


2.3.28

SKETCH OF UPPER & SECOND DECK HATCH ENDS

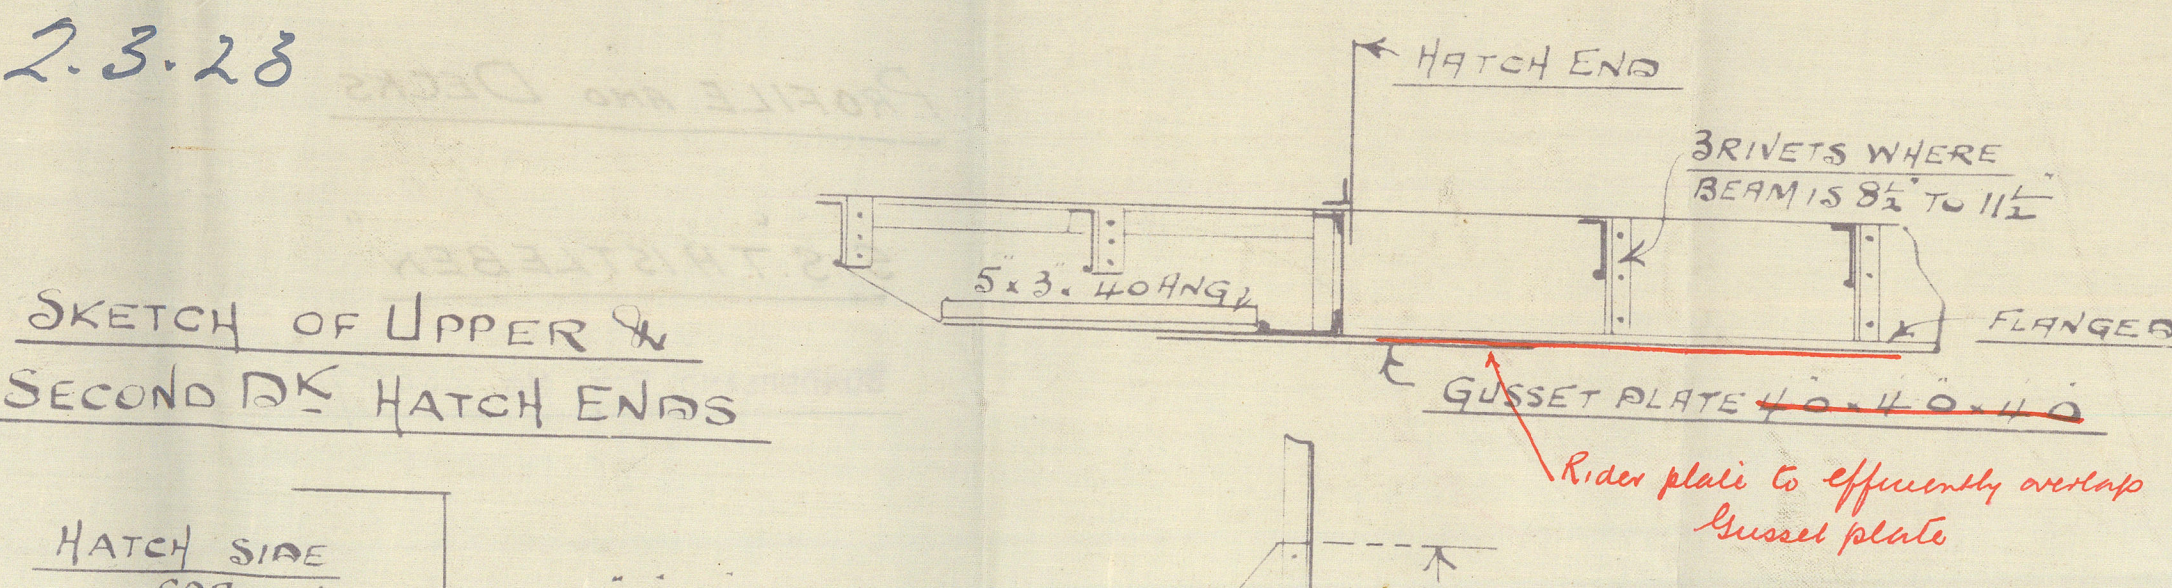

PROFILE & DECK PLANS OF A COMPLETE SUPERSTRUCTURE SCREW STEAMER

UPPER DECK BEAMS (WIDTH OF DECK MIDSHIPS = 50.0)

25.0 SPAN = 4.35.4284 BEAM KNEES 24.42 (6.7/8 IN)
16.8 = 4.35.38 = 21.42 (5.3/4 IN)
12.6 = 4.35.33 = 14.2 (5.1/4 IN)



FORWARD OF 1/2 LENGTH FROM FORWARD

25.0 SPAN = 4.35.4284 B.A. BEAM KNEES 24.42 (6.7/8 IN)
16.8 = 4.35.38 = 21.42 (5.3/4 IN)
12.6 = 4.35.33 = 14.2 (5.1/4 IN)


DIMENSIONS—
LENGTH B.P. 400.0
BREADTH MLD 53.45
DEPTH MLD 26.3
CLASS 100A.1 LLOYDS
SCALE 8"=1' FOOT with Freeboard.

SECOND DECK BEAMS (WIDTH OF DECK MIDSHIPS = 52.0)

26.0 SPAN = 11.35.4284 B.A. BEAM KNEES 33.46 (4 1/4 IN)
14.4 = 5.35.40 = 25.46 (6 1/4 IN)
13.0 = 4.35.36 = 21.46 (5 3/4 IN)

 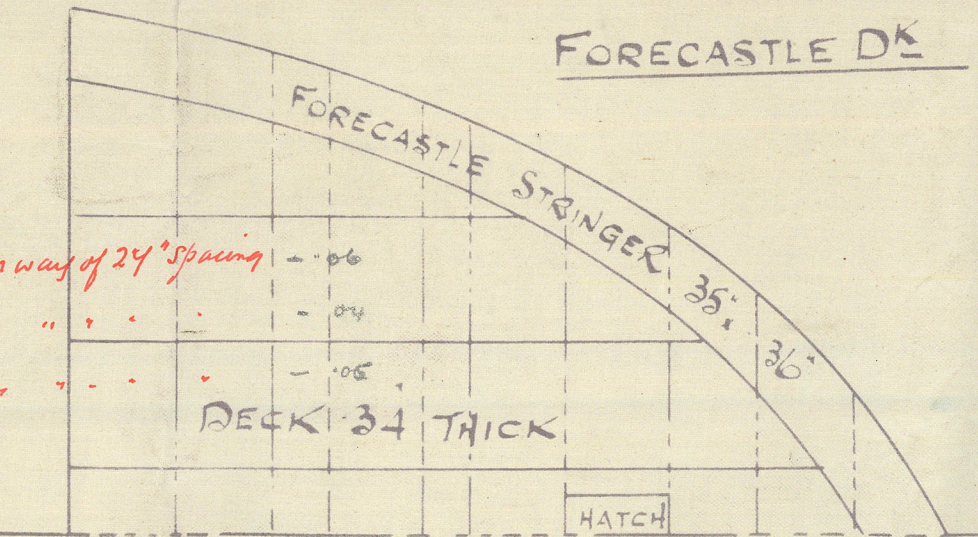

- No 210 -

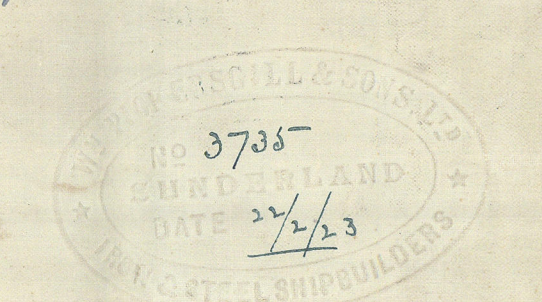

SUNDERLAND

WM. PICKERSGILL & SONS

S.S. No 210

PROFILE AND DECKS

"S.S. THISTLEBEN"

SUNDERLAND RPT. NO. 28857

RETAIN



© 2021

Lloyd's Register
Foundation

W693-0042