


23. 1. 20

# GENERAL ARRANGEMENT STEEL SCREW STEAMER

**DIMENSIONS**  
LENGTH 142' 0"  
BEAM 25' 0"  
DEPTH 12' 1"  
SCALE 1" = 10' 0"

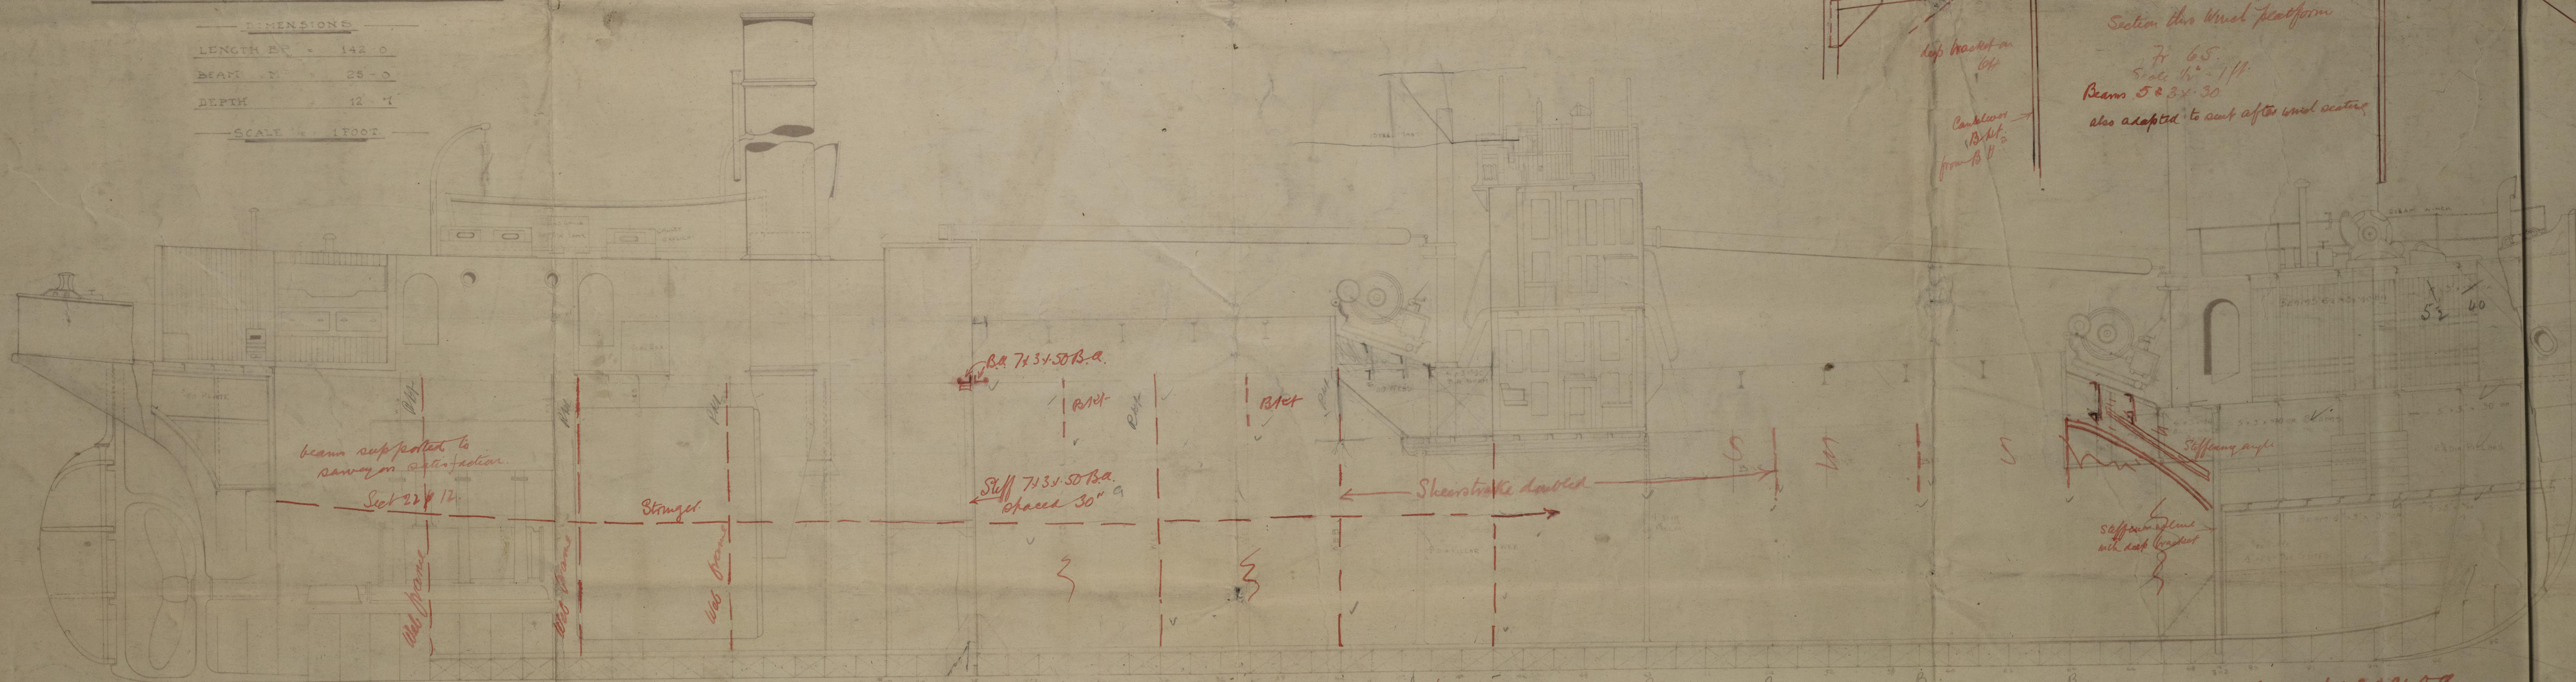


Frames 4 x 3 x 34 0.2.

Intermediate frame 4 x 3 x 34, Web 13 x 30, Side Str 13 x 50. see sketch of Section for alternative B.

frames 4 1/2 x 3 x 34 0.2.

Revised sketch showing Weak 1/2" R.O.C.  
as approved for extra ship 11.10.19


4 frames 4 x 3 x 34 0.2.  
Strengthening of bottom forward  
as approved for extra ship  
No 454

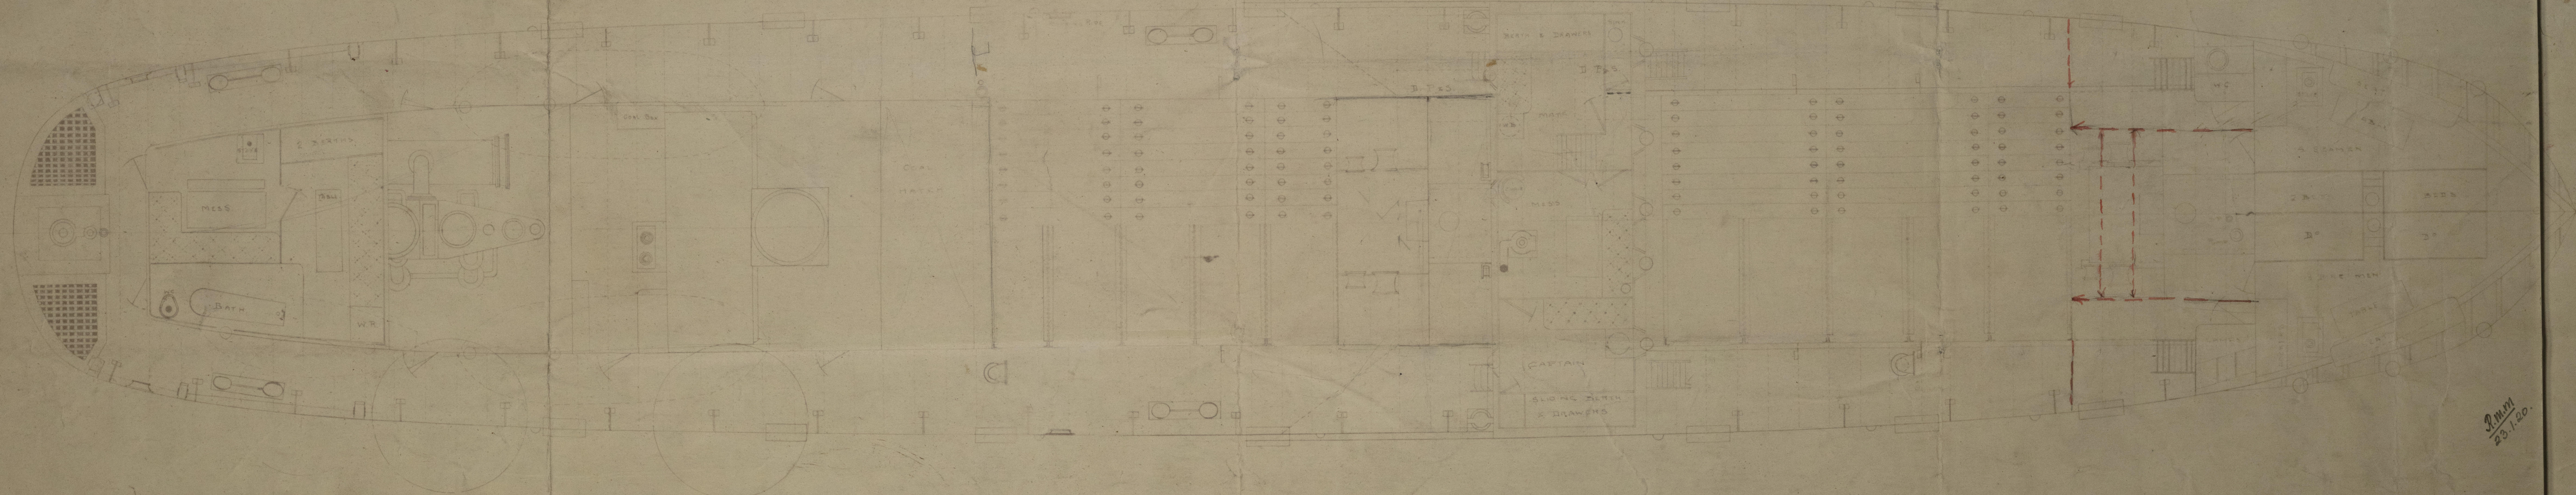

YARD N° 458.


23. 1. 20.



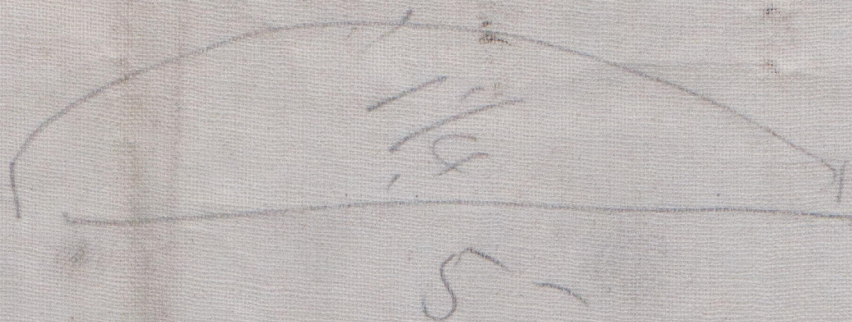

General Arrangement "Profile"  
ABDELA - MITCHELL  
S. S. 458

Abdela Mitchell  
U.S.S.

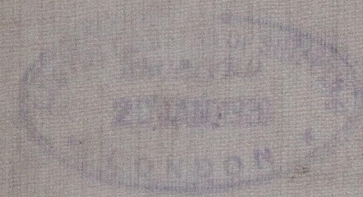

For "Commission" Profile  
S.S.

LIVERPOOL:

Report No. 82-966

RETAIN

W693-0156