


Sketch showing the length of propeller Shafts required to be drawn in when due for Survey also giving other particulars where shafts were made and showing the position of the marks, made for purpose of identification

*S.S. Mongolia*  
Trieste Report  
*N. 645*

*Stabilimento Tecnico Triestino*  
Yard N. 333.

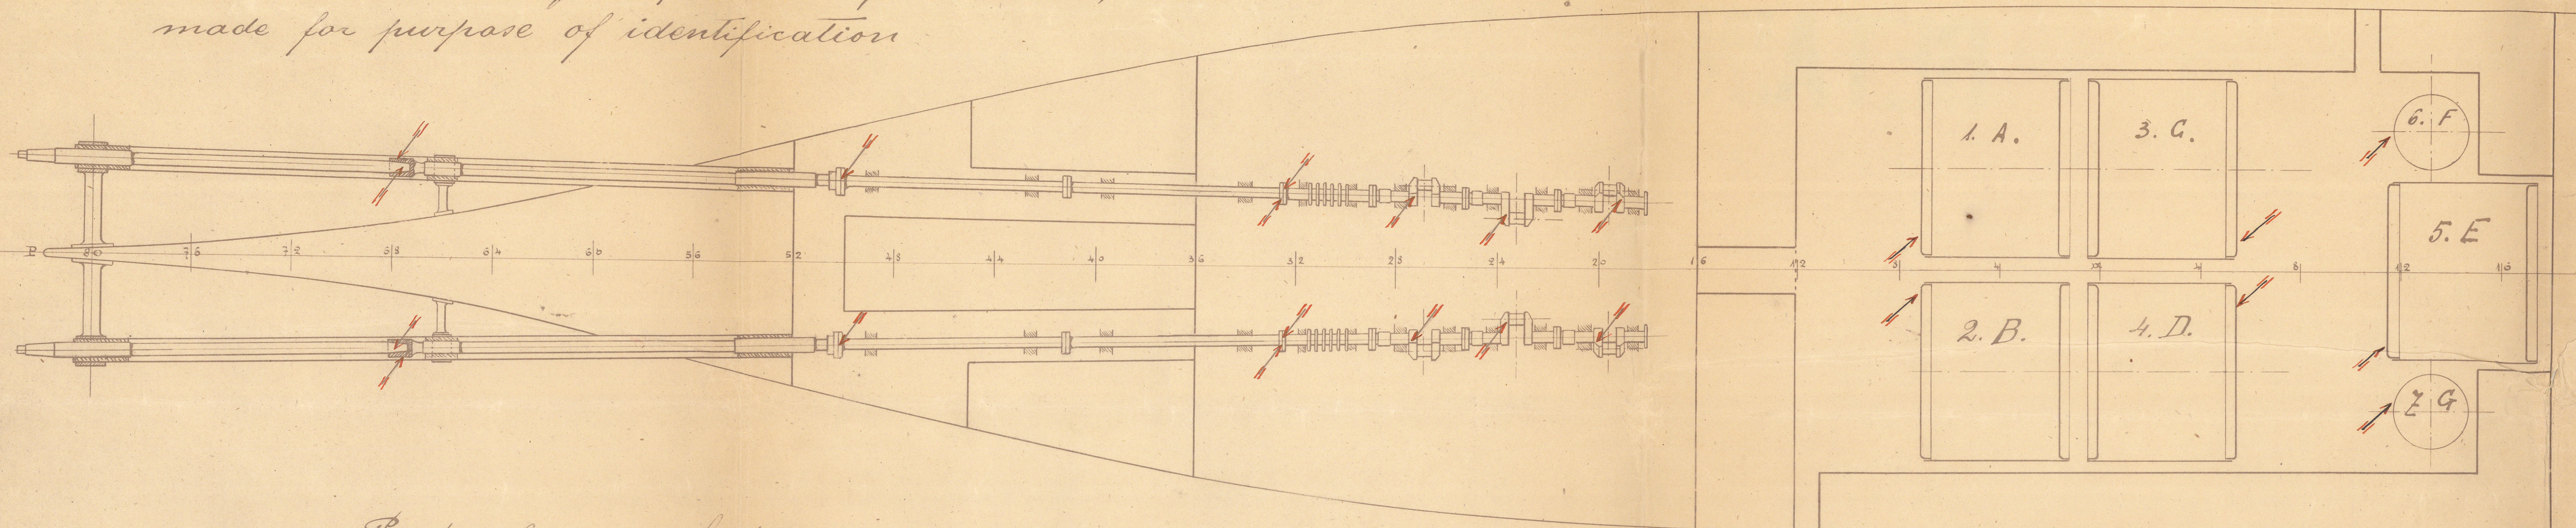

*Particulars of shafting*


Shafts	Material	Maker	Date of Test.	Mark stamped on shaft	
				Port side.	Starboard S.
Crank shafts		Witkowski Steel Works	12 <sup>th</sup> June 1900	LLOYD'S No 26 12.6.900 R.D.	LLOYD'S No 22 12.6.900 R.D.
Thrust - " -			4 <sup>th</sup> May 1900	LLOYD'S No 20 4.5.900 R.D.	LLOYD'S No 21 4.5.900 R.D.
Tunnel - " -			4 <sup>th</sup> May 1900	LLOYD'S No 20 4.5.900 R.D.	LLOYD'S No 21 4.5.900 R.D.
first length of propeller shaft			4 <sup>th</sup> May 1900	LLOYD'S No 20 4.5.900 R.D.	LLOYD'S No 21 4.5.900 R.D.
second length of propeller shaft			4 <sup>th</sup> May 1900	LLOYD'S No 20 4.5.900 R.D.	LLOYD'S No 21 4.5.900 R.D.
Spare.	1. Crank shaft.	Witkowski Steel Works	12 <sup>th</sup> June 1900	LLOYD'S No 22 12.6.900 R.D.	
	1. Thrust - " -		4 <sup>th</sup> May 1900	LLOYD'S No 22 4.5.900 R.D.	
	1. second length of propeller shaft.		4 <sup>th</sup> May 1900	LLOYD'S No 23 4.5.900 R.D.	

*Particulars of Boilers*  
showing position where stamped.

Number	Description of Boiler	Maker	Date of Test	Mark stamped on Boiler
1.	A Main Boiler	Made by Messrs Bors. & Co. Ltd. at Stabilimento Tecnico Triestino	5 <sup>th</sup> January 1901	No 14 LLOYD'S TEST 350 lbs 5.1.901 R.D.
2.	B " "		5 <sup>th</sup> January 1901	No 15 LLOYD'S TEST 350 lbs 5.1.901 R.D.
3.	C " "		12 <sup>th</sup> January 1901	No 16 LLOYD'S TEST 350 lbs 12.1.901 R.D.
4.	D " "		9 <sup>th</sup> January 1901	No 17 LLOYD'S TEST 350 lbs 9.1.901 R.D.
5.	E " "	Made at the Stabilimento Tecnico with material supplied by the steel works.	16 <sup>th</sup> January 1901	No 18 LLOYD'S TEST 350 lbs 16.1.901 R.D.
6.	F Donkey "	Bochran & Co. Amman.	1 <sup>st</sup> June 1900	No 19 LLOYD'S TEST 180 lbs 1.6.900 J.W.D.
7.	G " "		12 <sup>th</sup> June 1900	No 20 LLOYD'S TEST 180 lbs 12.6.900 W.D.



*Robt Dussich*

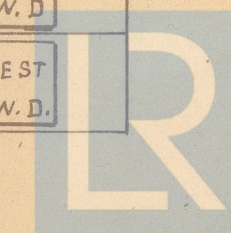



RETAIN



© 2021

Lloyd's Register  
Foundation

W643-0181