

Equipment 11-11358-0
Letter T

1st Bow (phobles)	35-2-0
2nd Bow (1")	35-2-0
3rd Bow (1")	30-0-0
Stream (2nd)	9-1-0
Kedge (1")	4-3-0

Cables 240 fathoms of 1 1/2" (shillit)
 Steam wire - 45 fathoms of 4"
 Towline - 90' of 3 1/2" wire or 11" manila
 Hawseas 2-90' of 6"
 Manila 2-90' of 5"

PRINCIPAL DIMENSIONS

LENGTH BETWEEN PERP.	250'-0"
BEAM MOULDED	42'-6"
BEAM EXTREME	43'-6"
DEPTH MOULDED	25'-0"

LLOYDS REQUIREMENTS, A.I. CLASSIFICATION.


S.S. "War Babine"
Foundation 6-3-6
Vessel 11-23

**WOODEN STEAMER
 TYPE SECTIONS**

SCALE 1/2" = ONE FOOT.

IMPERIAL MUNITIONS BOARD VICTORIA B.C.

DRAWING 7-A
 JULY 8th 1918

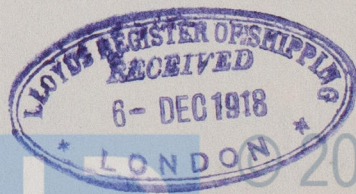

2021

Lloyd's Register
Foundation

W694 - 0097.2