





N-761

Marine Boiler

12'-0" dia x 10'-0" long for 130 lbs  
W.P.

Duplicate of No 460.


Mark on boiler

No 15219  
Lloyds Lat  
260 lbs  
HP 130 lbs  
P.M.C. 14/4/20

GLASGOW REPORT No. 39874

RETAIN

W694-0189

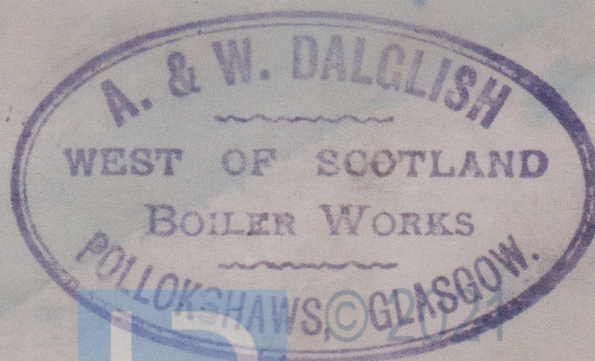

Lloyd's Register  
Foundation