

13/7/17

LONGITUDINAL PLAN S.S. N^o 286.

163'-6" x 25'-0" x 14'-3"





CLASSED AT LLOYDS + 100. A.1.

SCALE 1/8" = 1'-0"


TRANSVERSE NUMBER B+D-25+14.25=39.25

LONGITUDINAL L(B+D)=163.5x39.25=6417.37

FORECASTLE

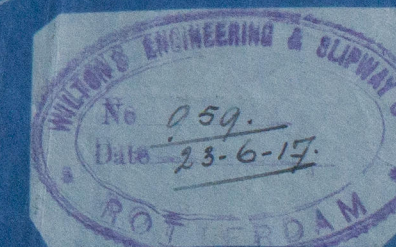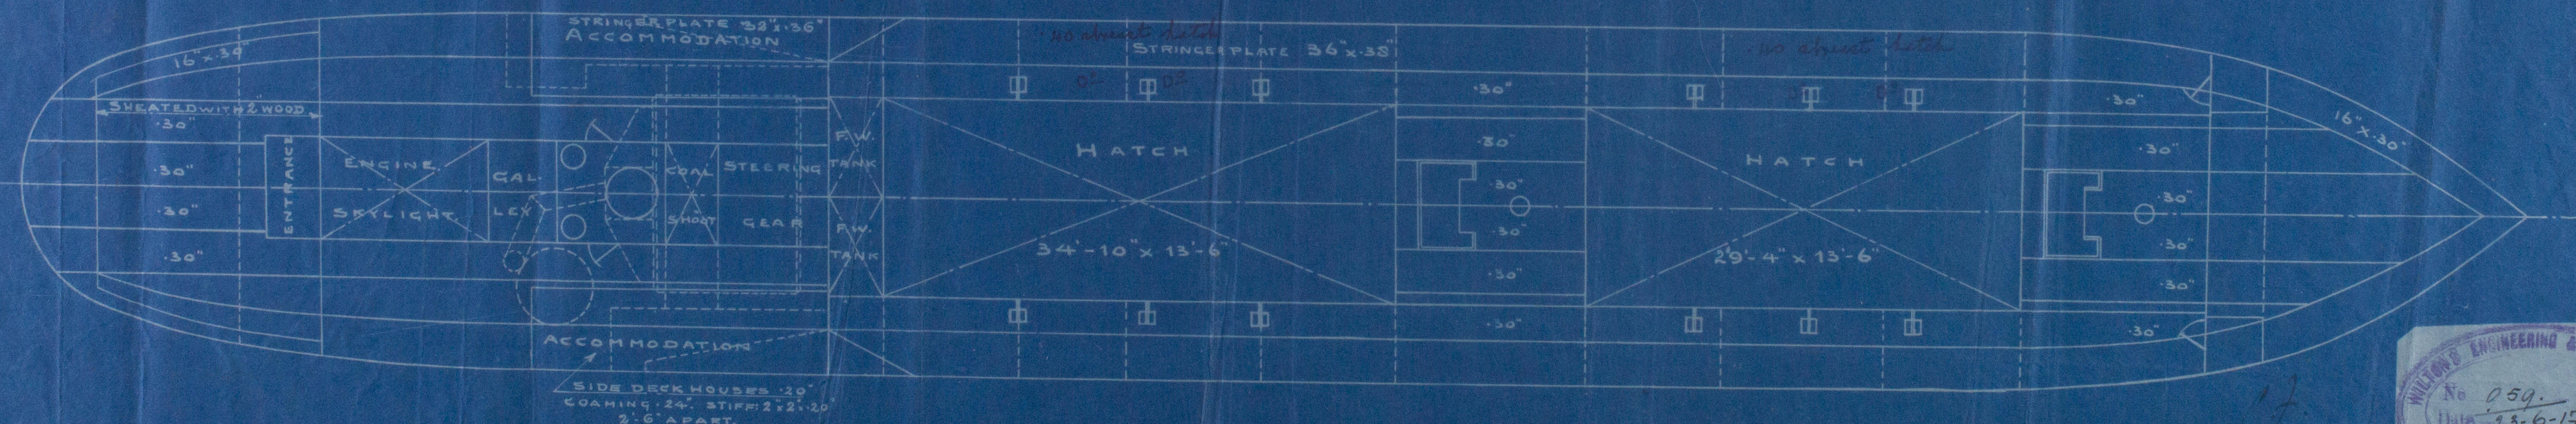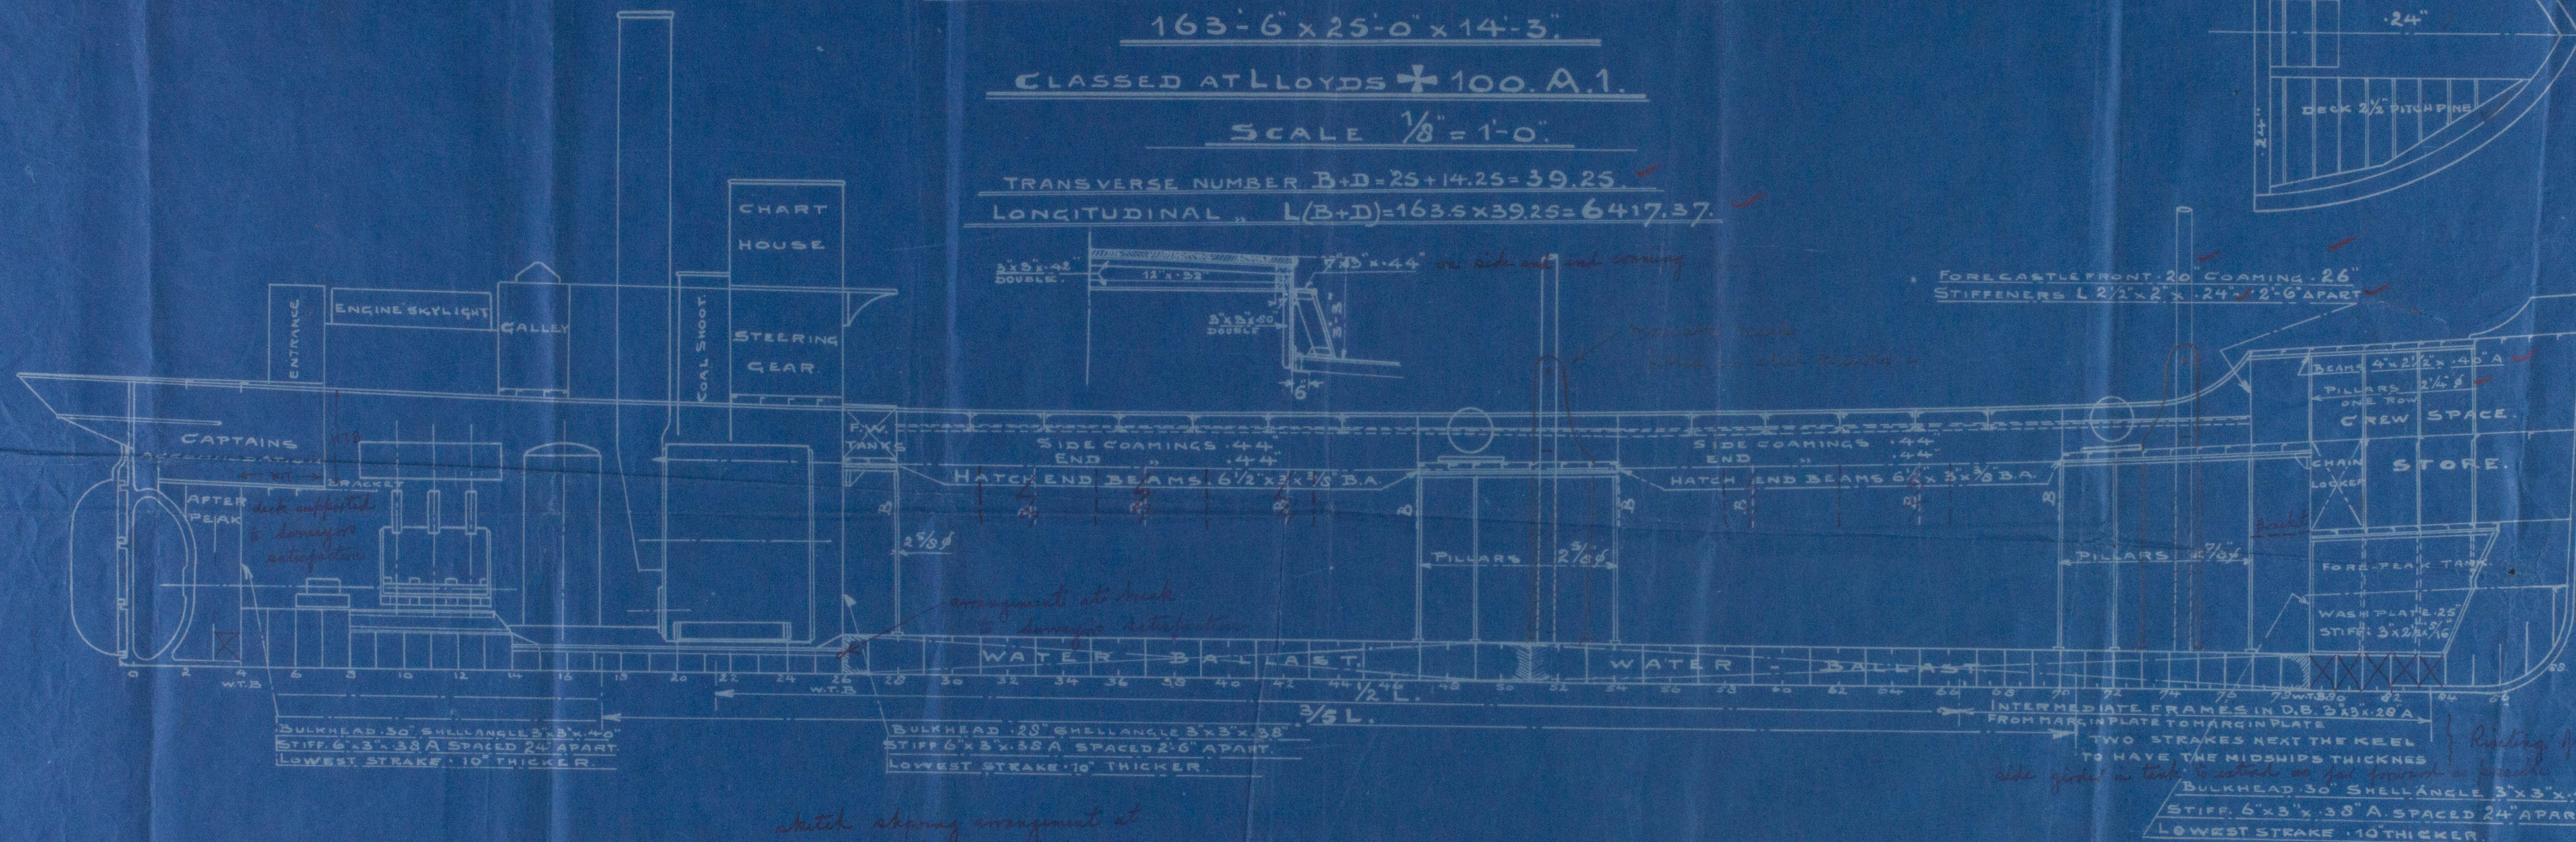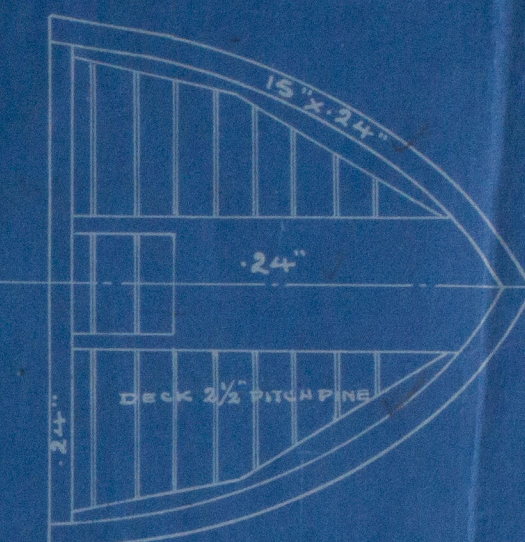

De Klodder

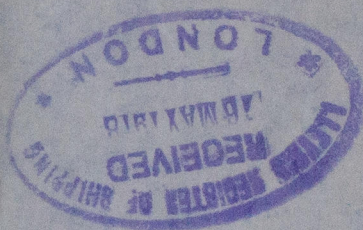

S.S. "Eigen Hulp VI"

Profile and Decks

Rotterdam

Report No. 10574^a

W695-0096



© 2020

Lloyd's Register
Foundation