


HORIZONTAL MULTITUBULAR STEEL BOILER 11'-0" DIAM. x 10'-0" LONG. LLOYDS SURVEY 100 W.P.






FOR MESSRS W<sup>M</sup> PICKERSGILL & SONS SUNDERLAND S.S. N<sup>o</sup> 144.

N<sup>o</sup> 3406.

SCALE 1" = 1 FT.

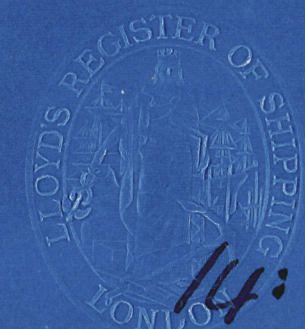

14:3:04

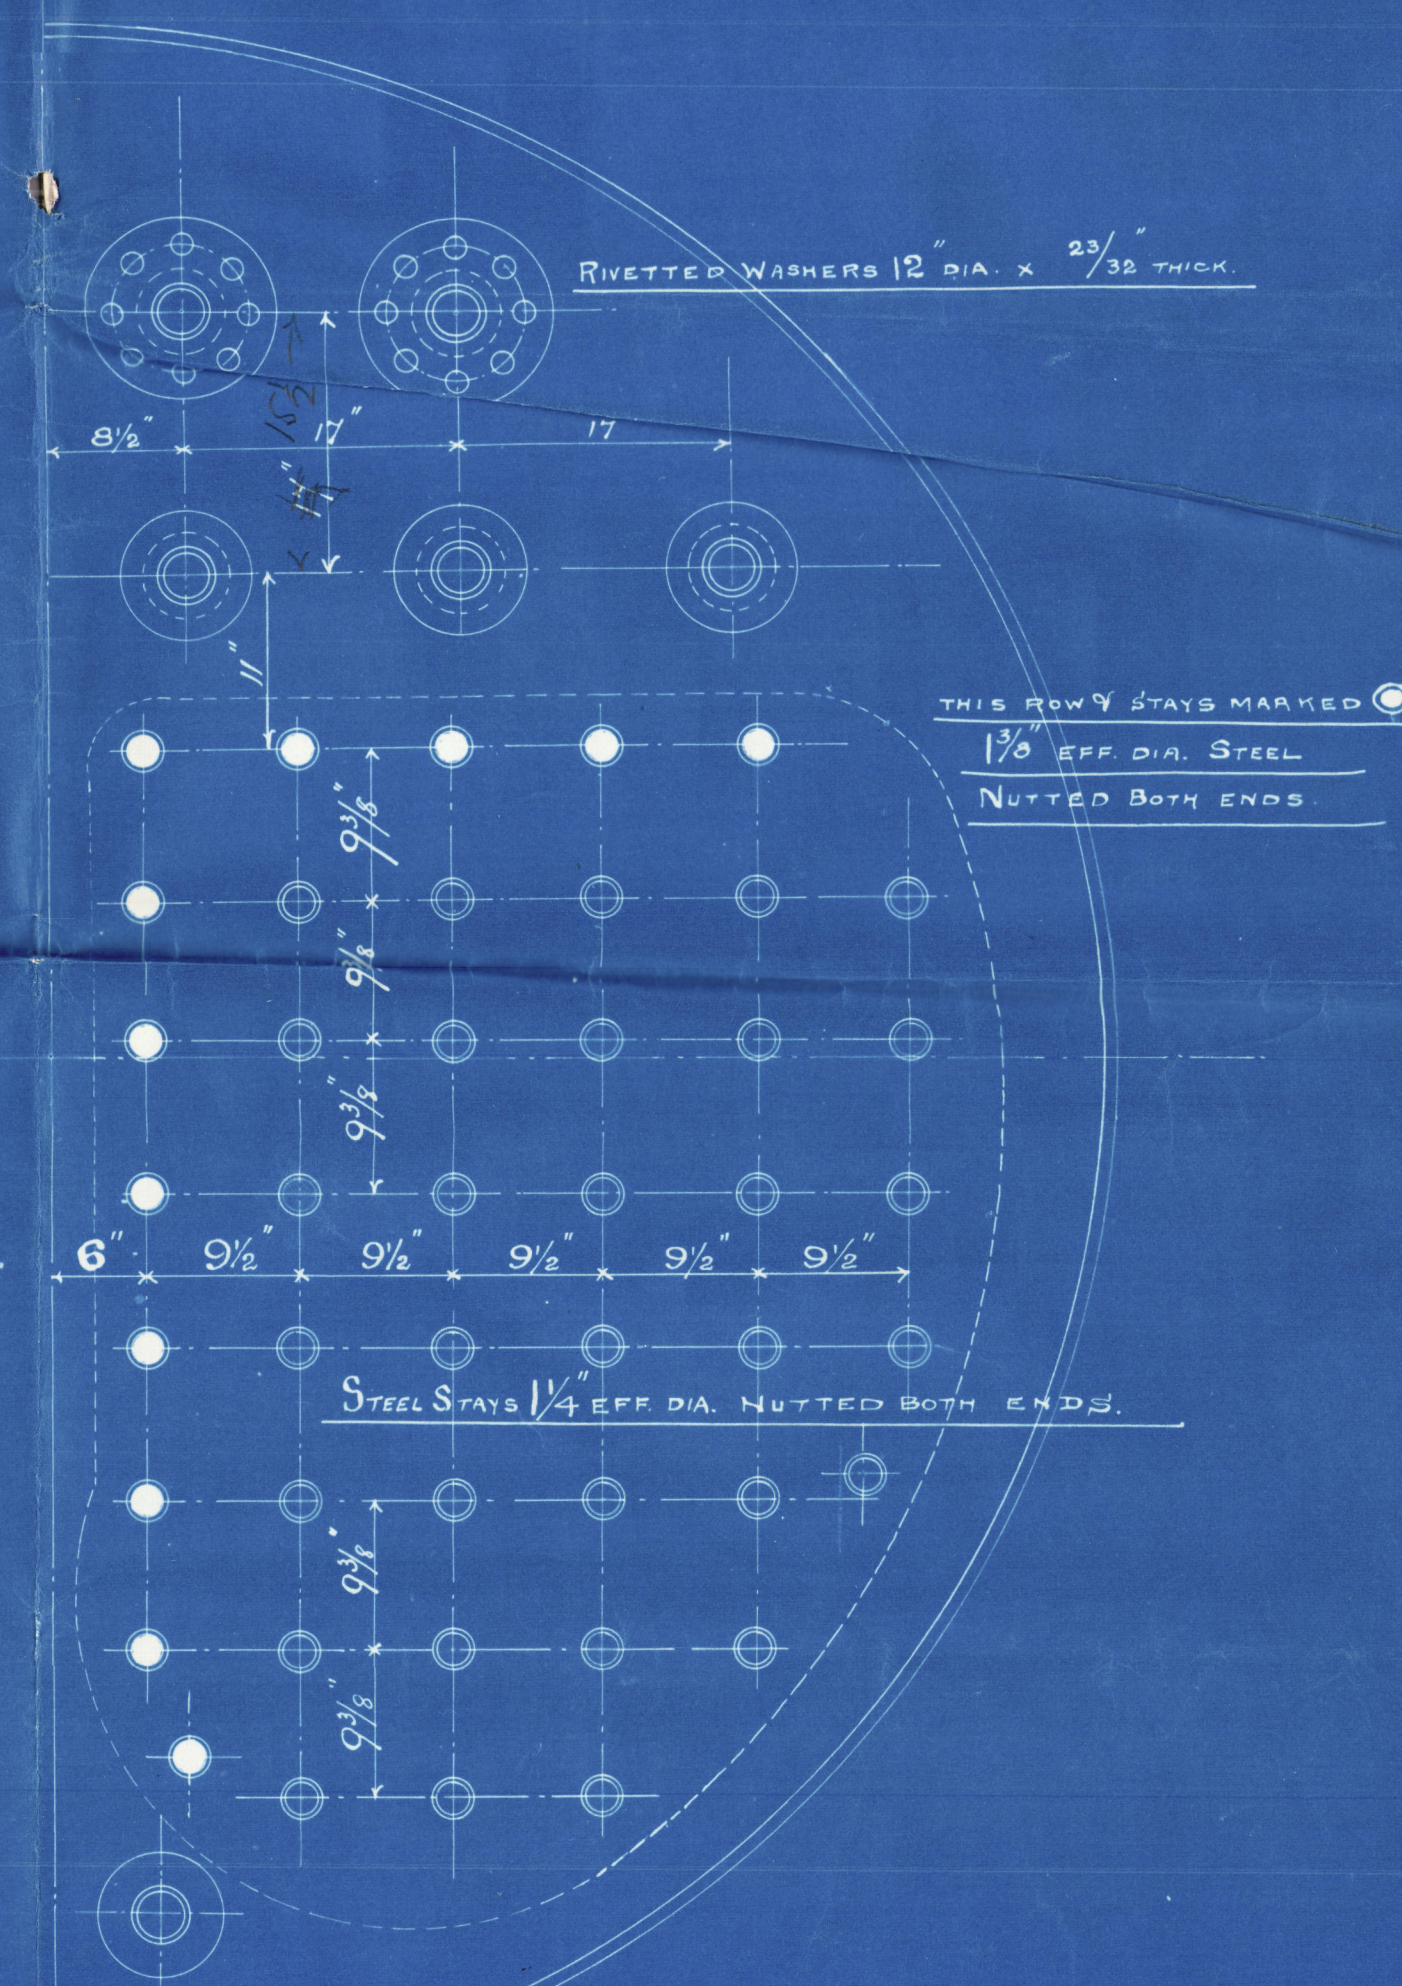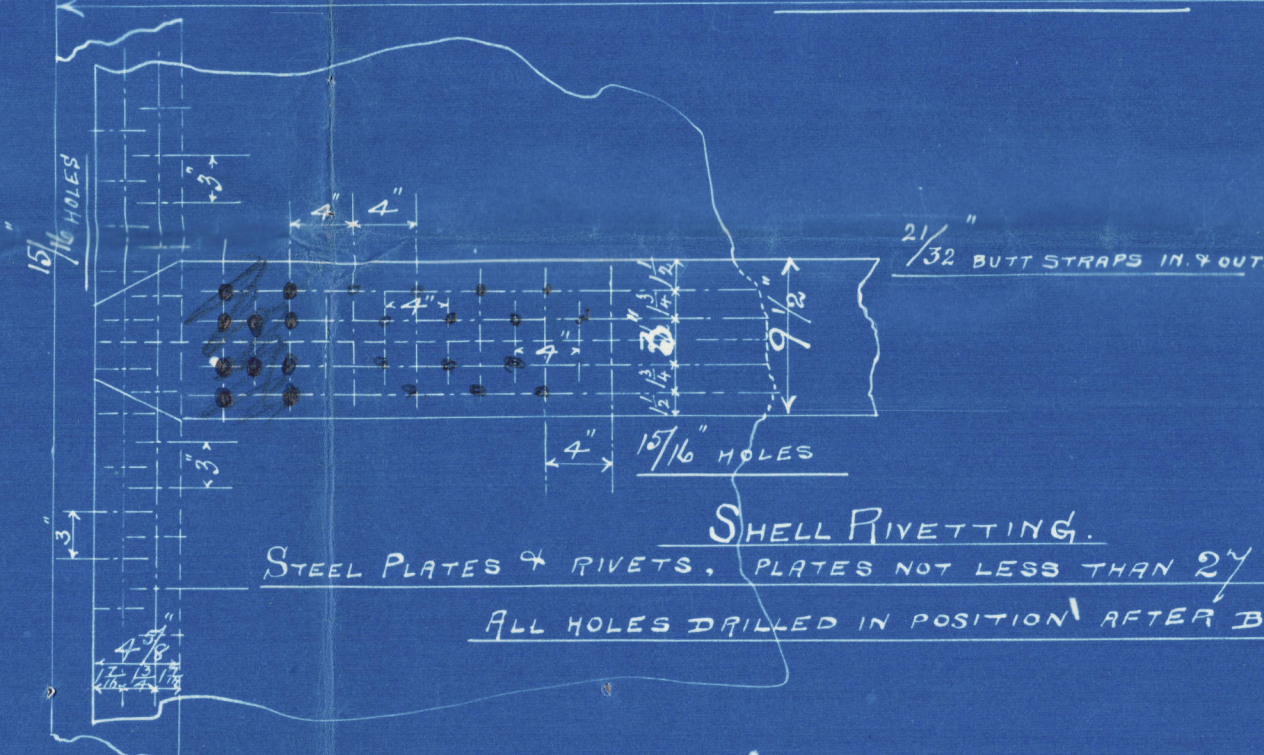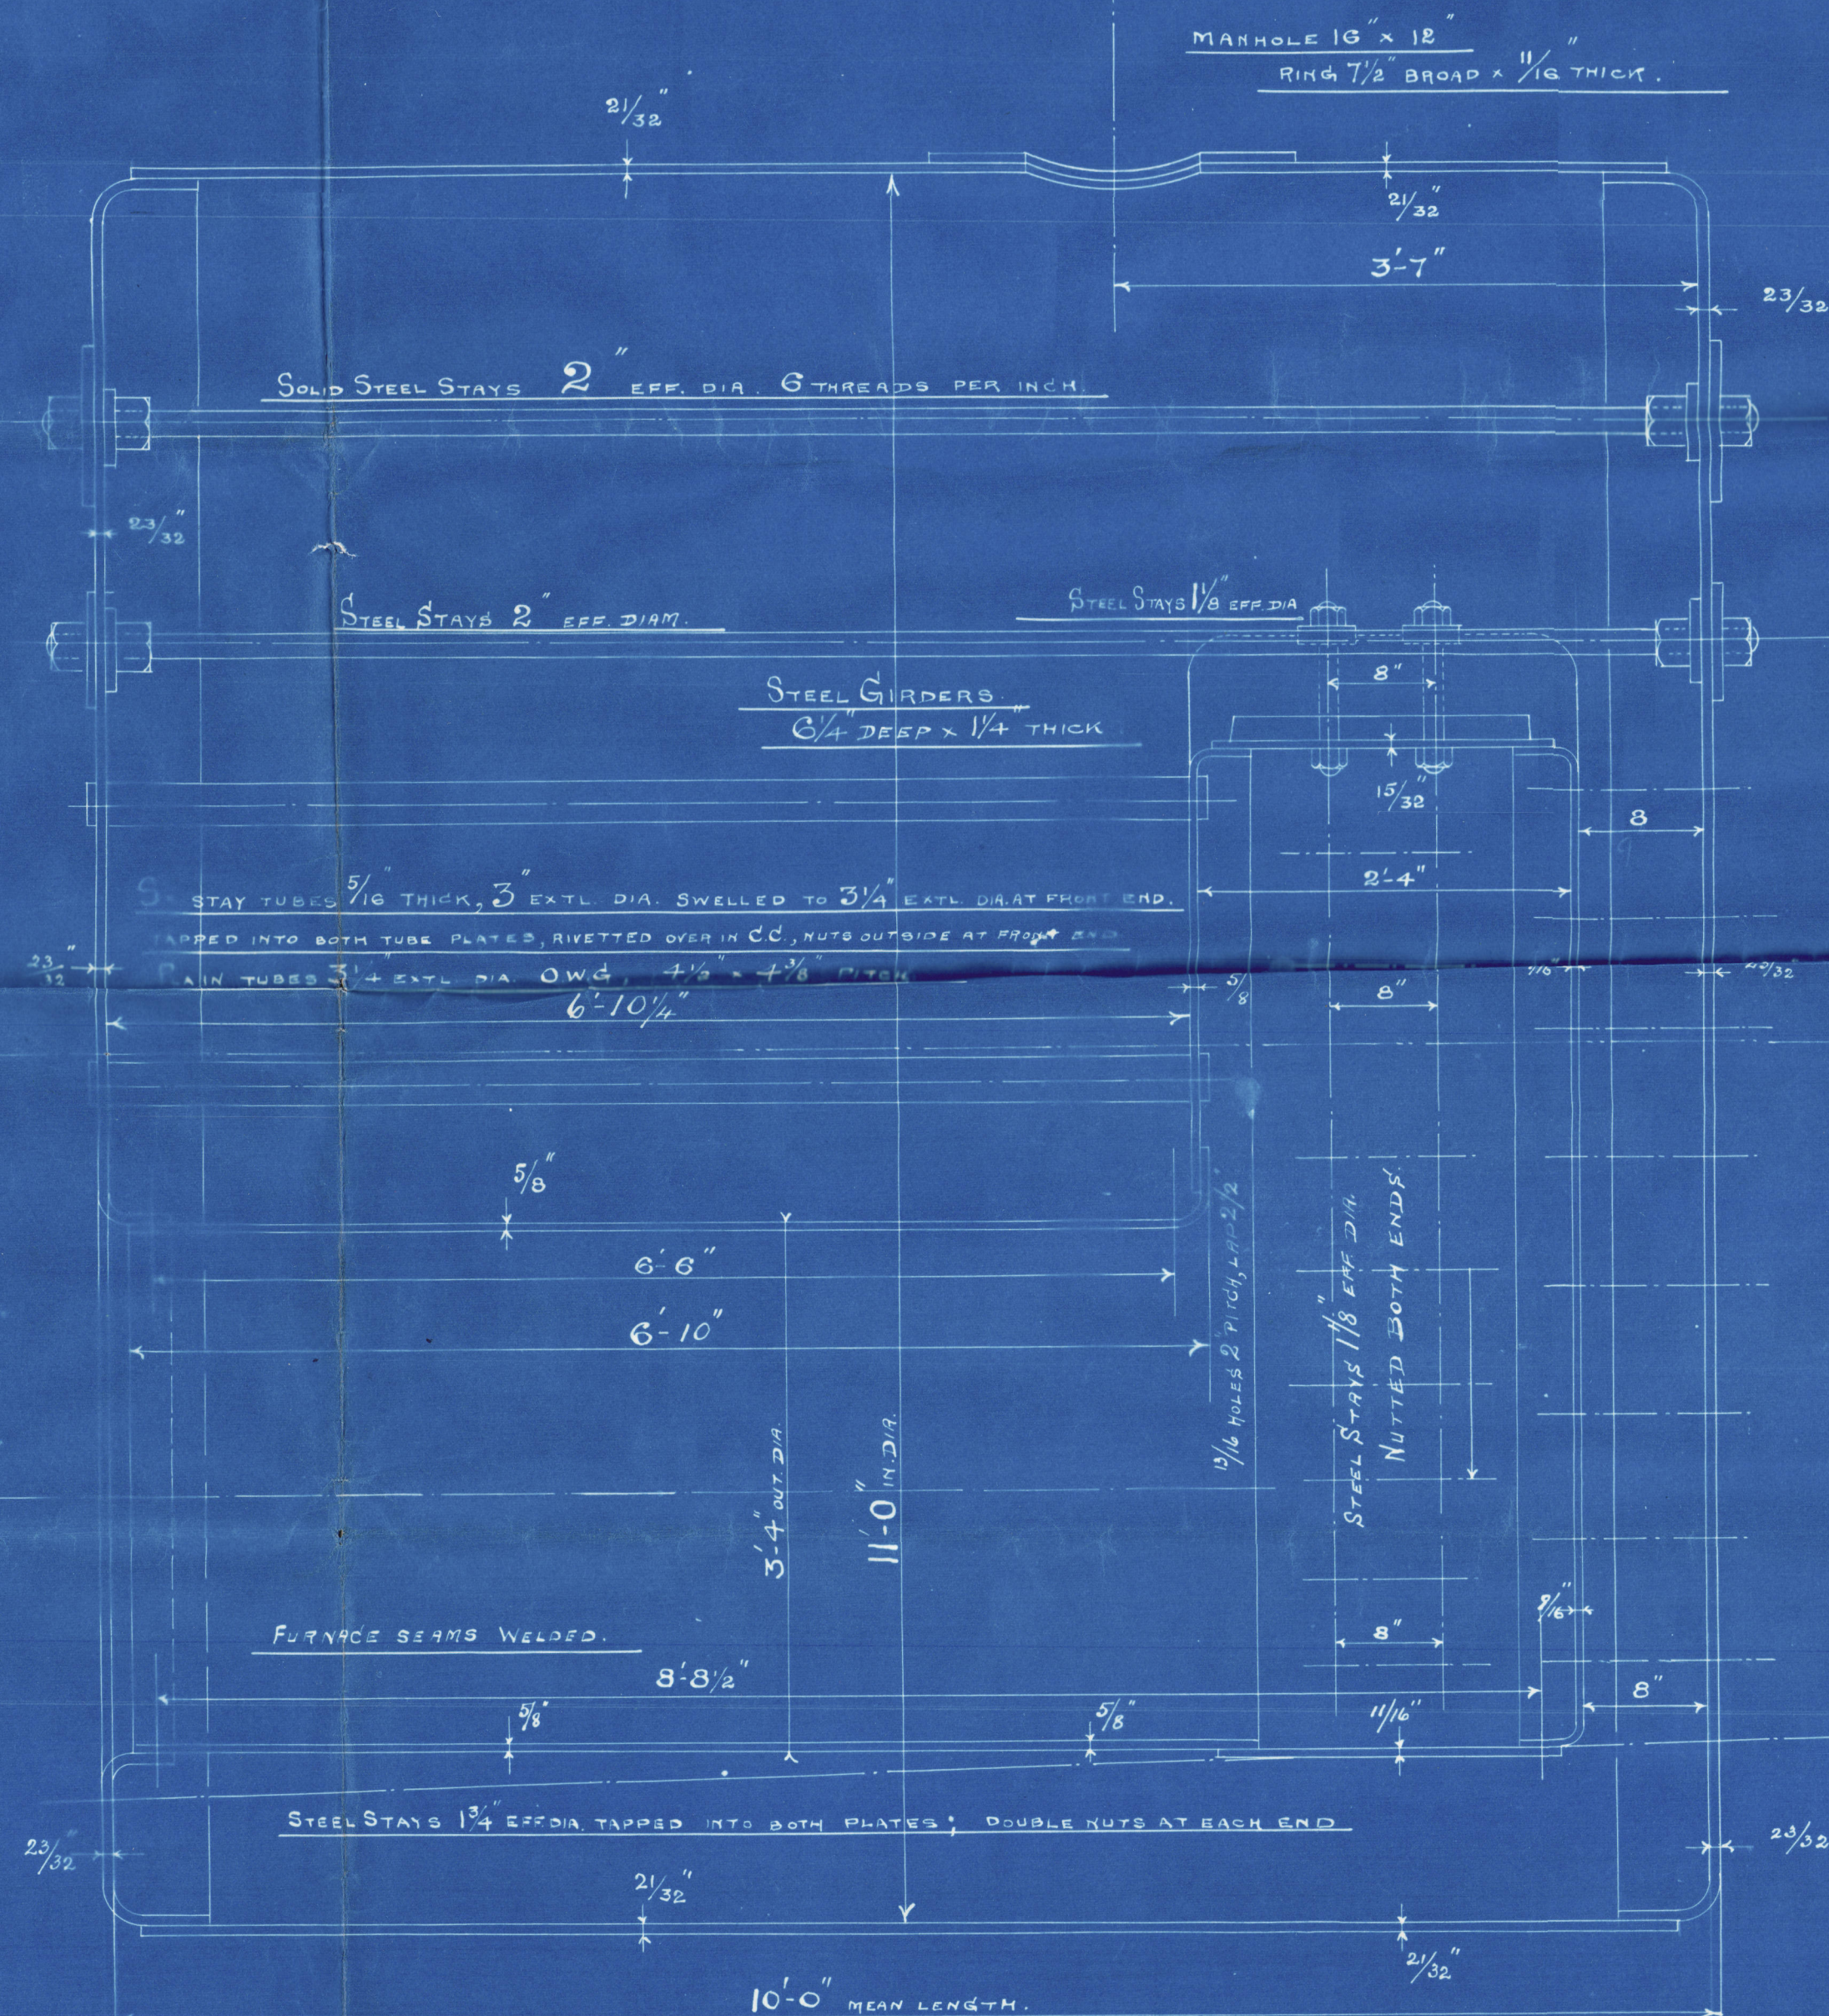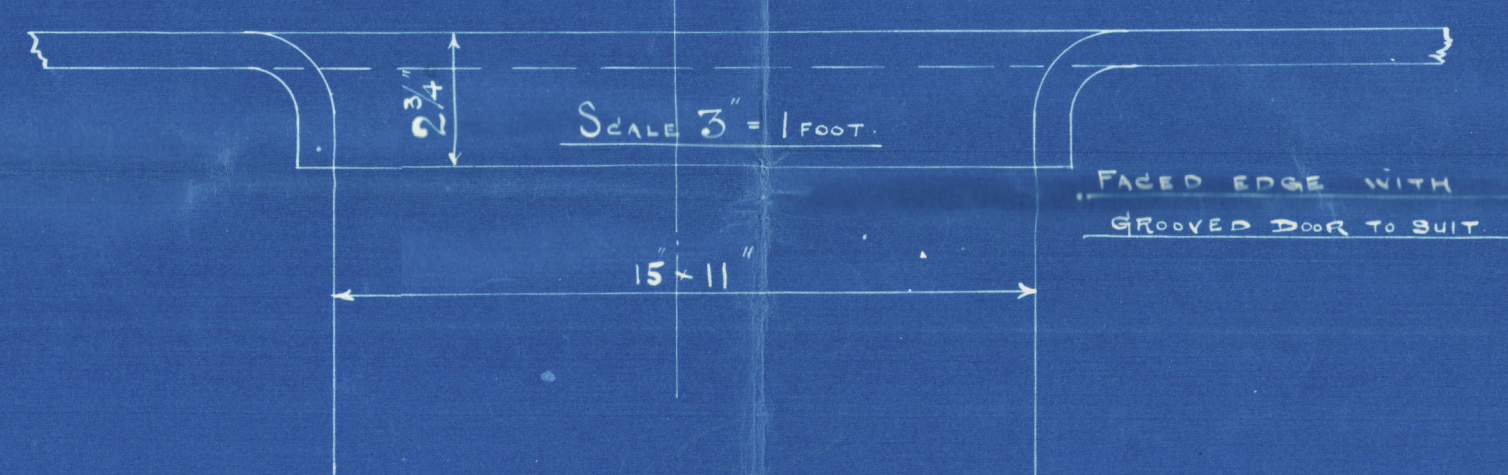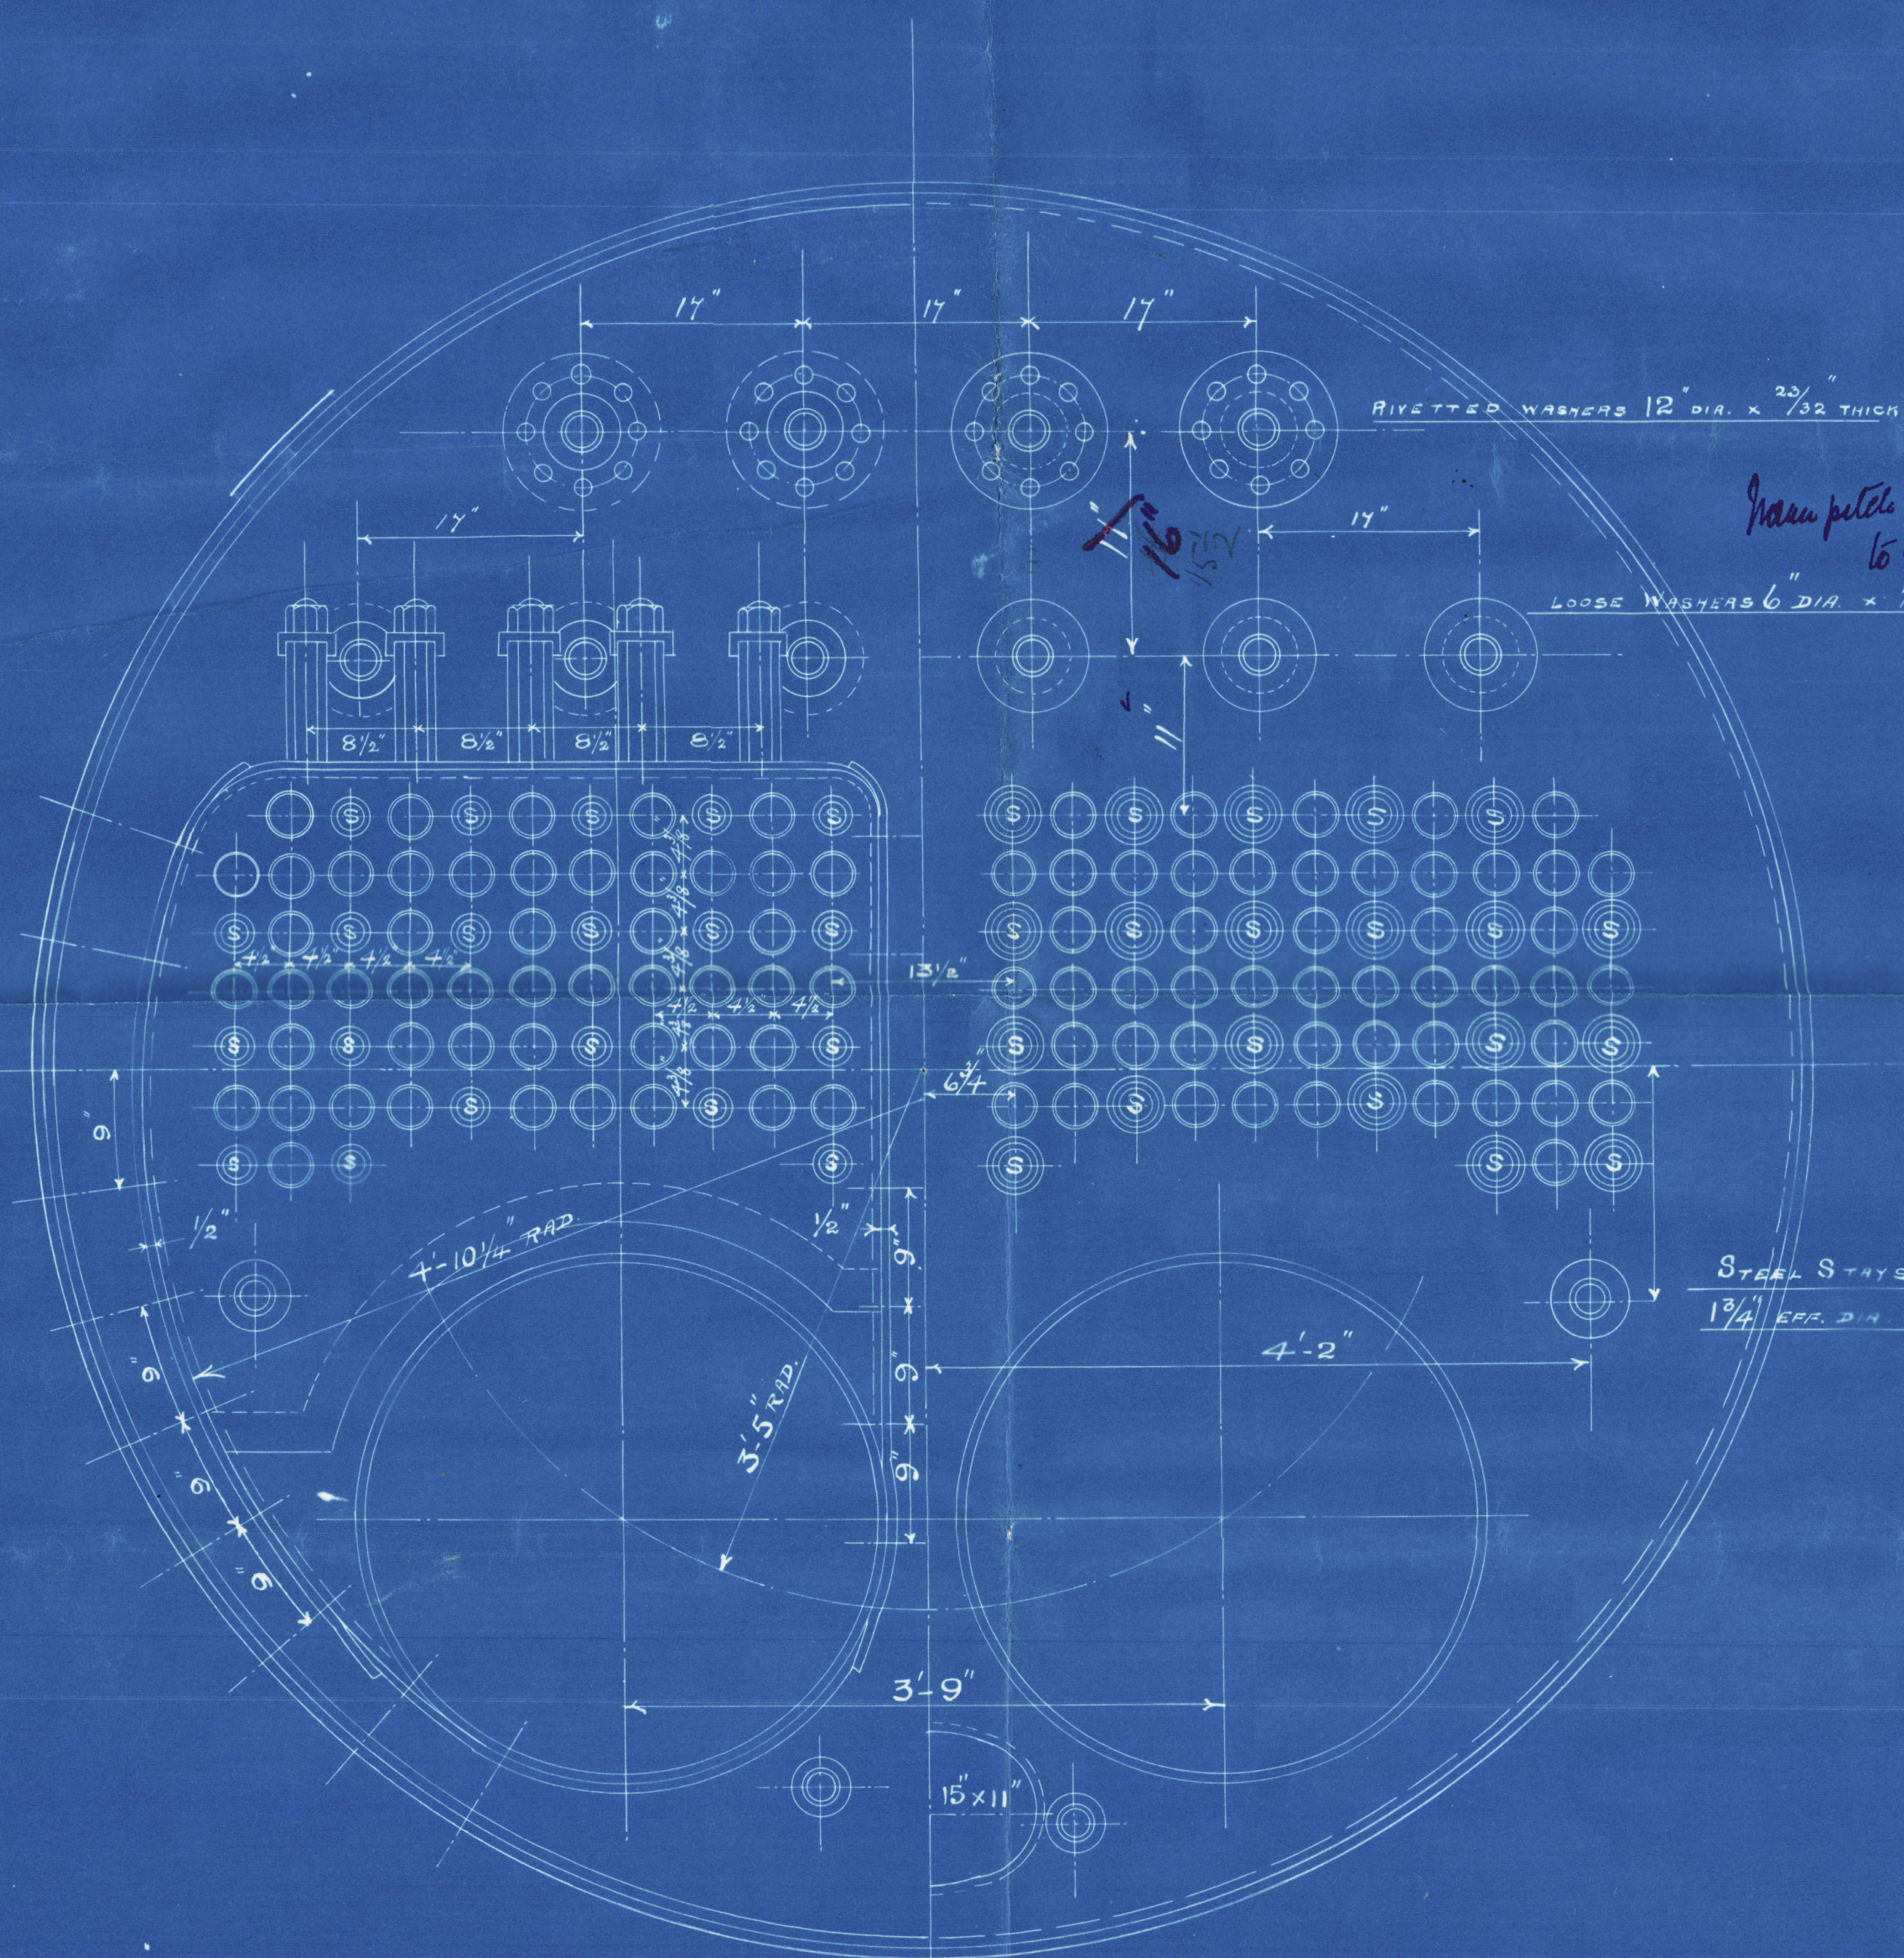

Bale.  
12.3.04  
11/3/04




Lloyd's Register Foundation



Hiley Bros Ltd


No 3406.

W Pickens & Son  $\frac{3}{8}$  No 144

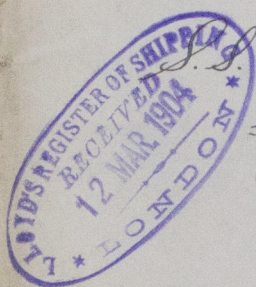

<sup>100lb. net</sup>  
"Gray Castle"  
Sld. Rpt. No. 21954  
Filed 15-6-04

W695-0251

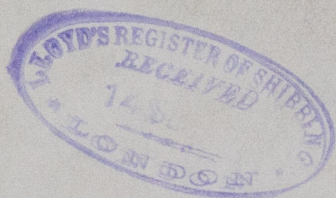

RETAIN



© 2020

Lloyd's Register  
Foundation