


22.10.00
23.3.01
25.4.02

— S.S. N^o 267 —
— PROFILE & DECK PLANS —

— SCALE $\frac{1}{8}$ INCH = ONE FOOT —
DIMENSIONS 348' 0" x 45' 5" x 29' 0" M.P.

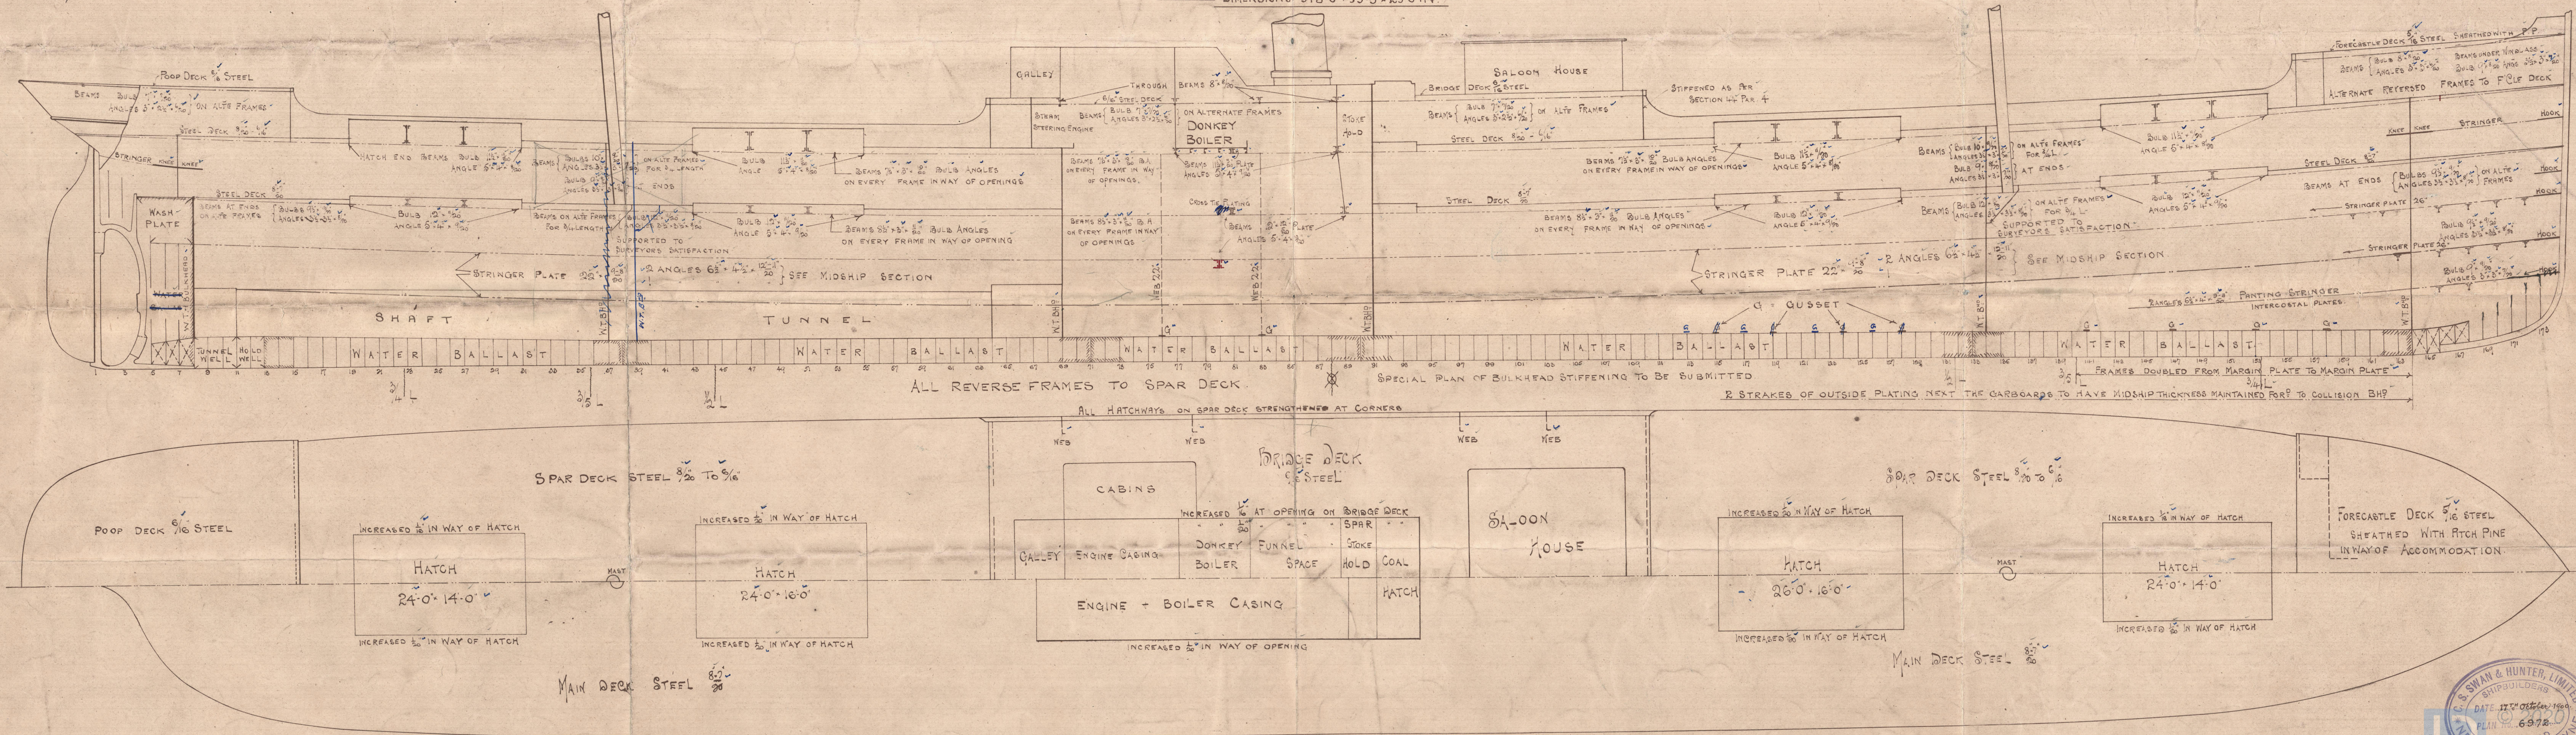

No 267

Profile

Swan & Hunter.



Newcastle Freeboard Report
No 43,311
~

J. J. Potomac

Newcastle Report

No 43425



RETAIN



© 2020

Lloyd's Register
Foundation
W697-0081