

HORIZONTAL MULTITUBULAR STEEL BOILER 2975<sup>mm</sup> DIAMETER, X 3050<sup>mm</sup> LONG.

WORKING PRESSURE 6.32 ATMS. 90 lbs.







MESSRS SWAN & HUNTER 267 S.S.

N<sup>o</sup> 2999.


SCALE 83<sup>mm</sup> = 1 METER.

HEATING SURFACE 71.0 SQ.M.

GRATE AREA 2.8 SQ.M.

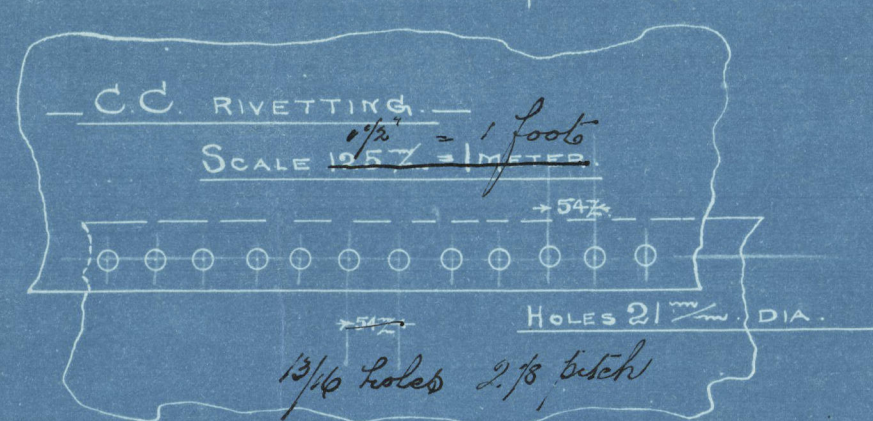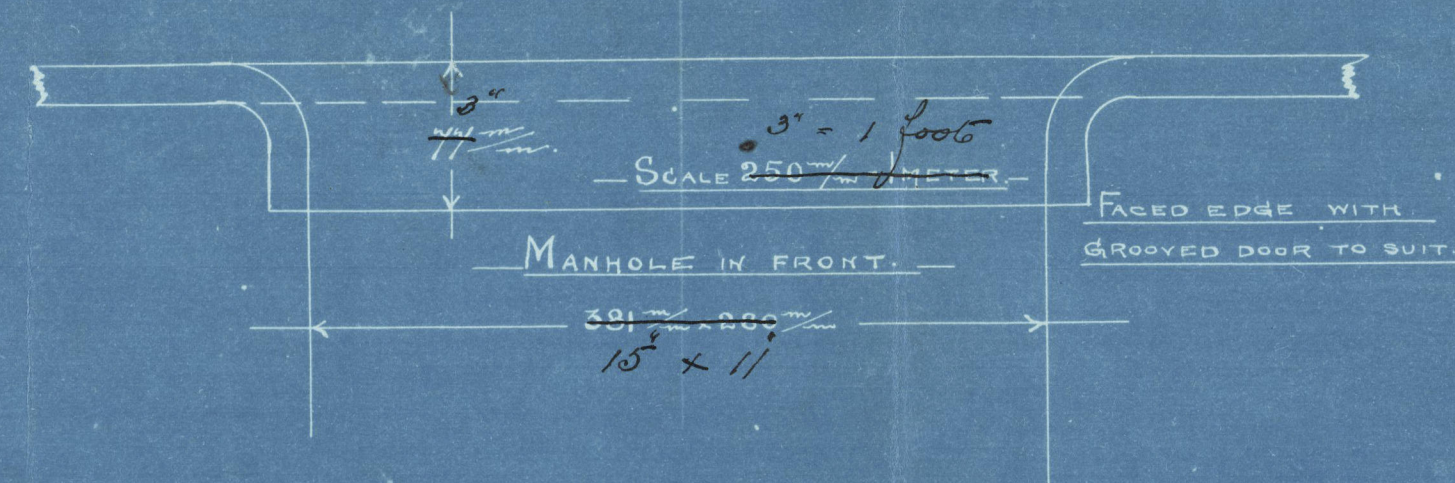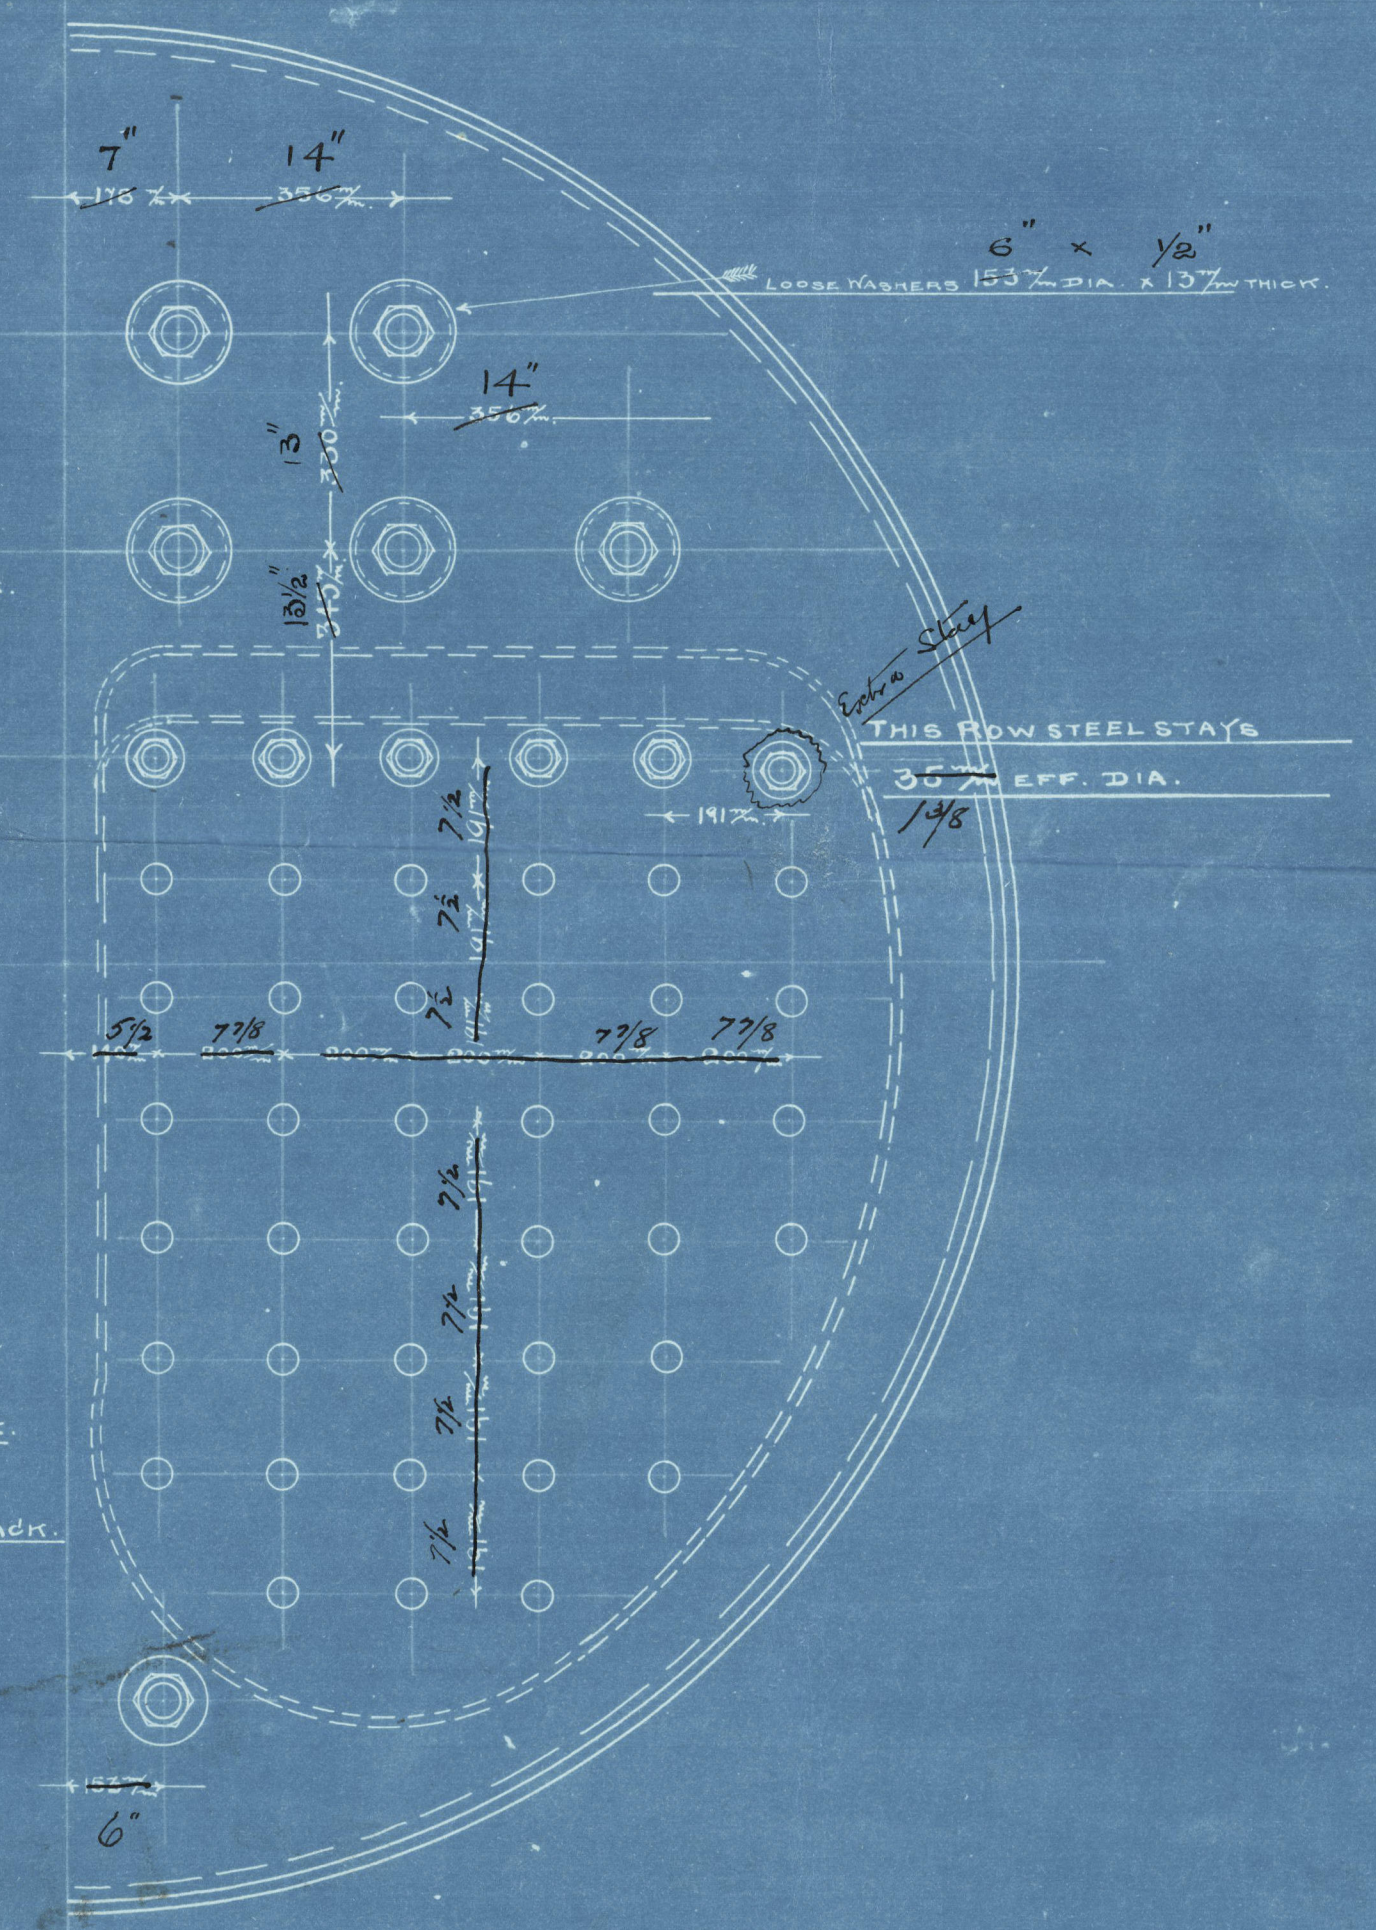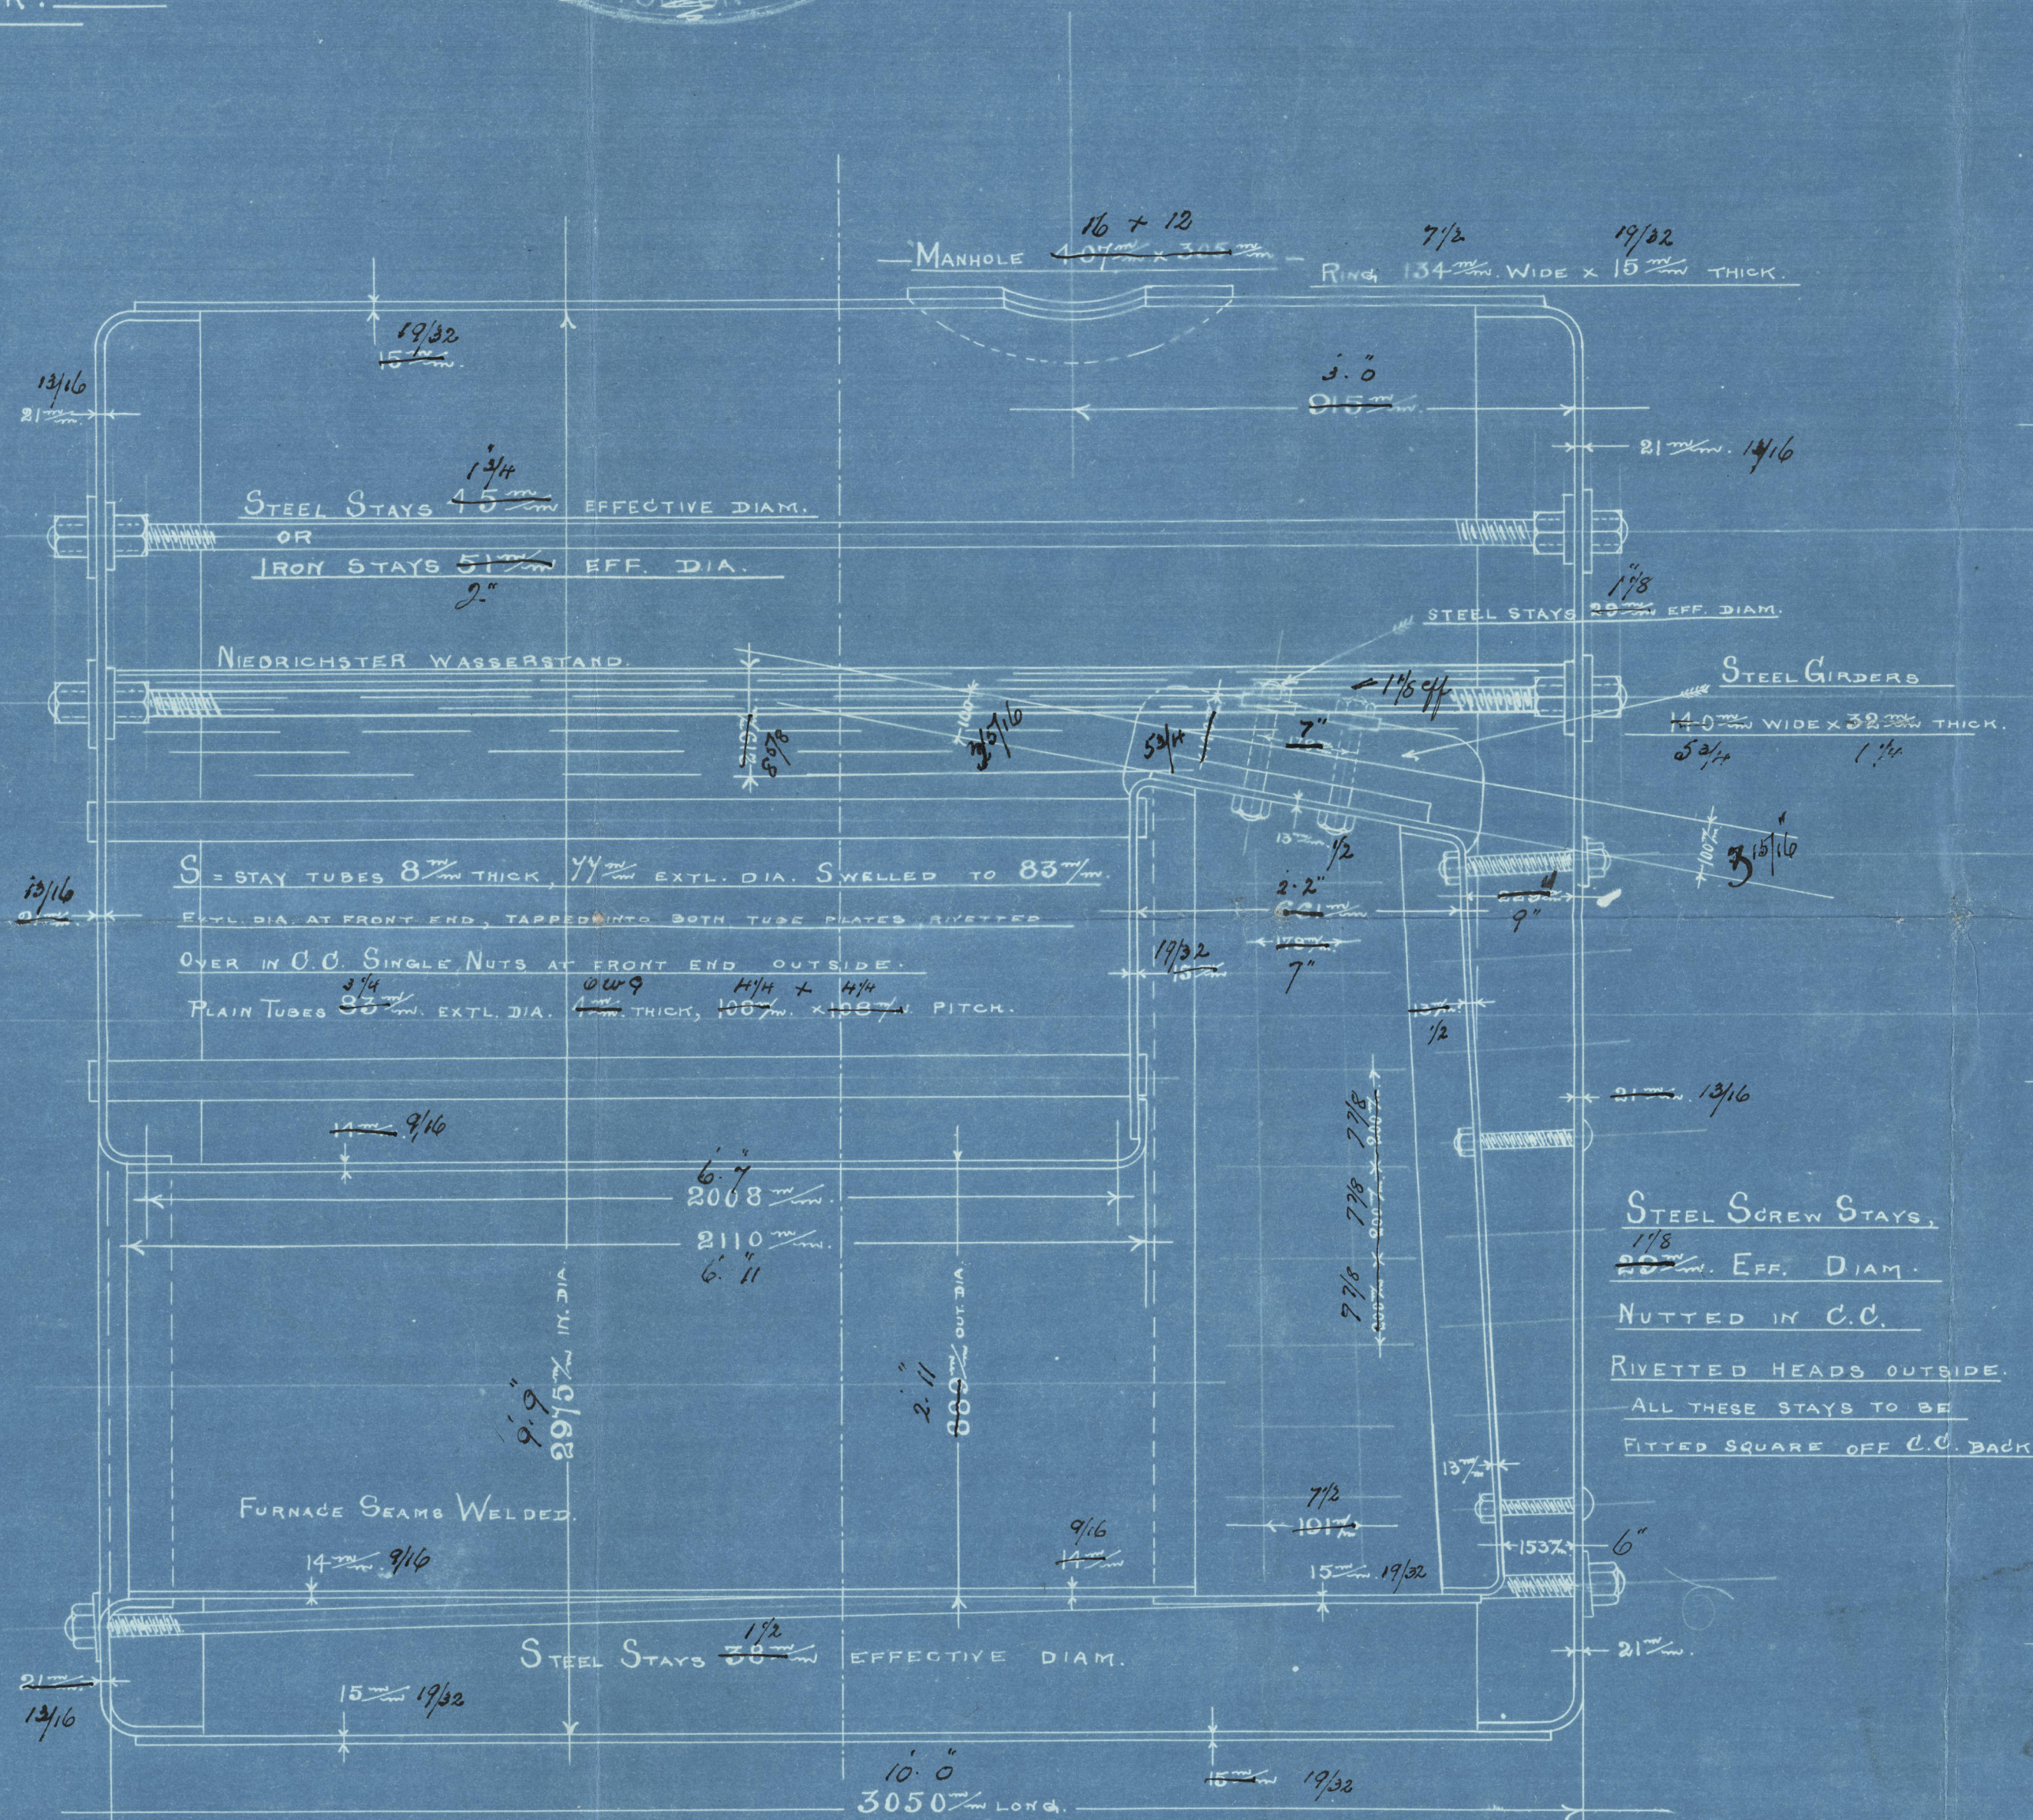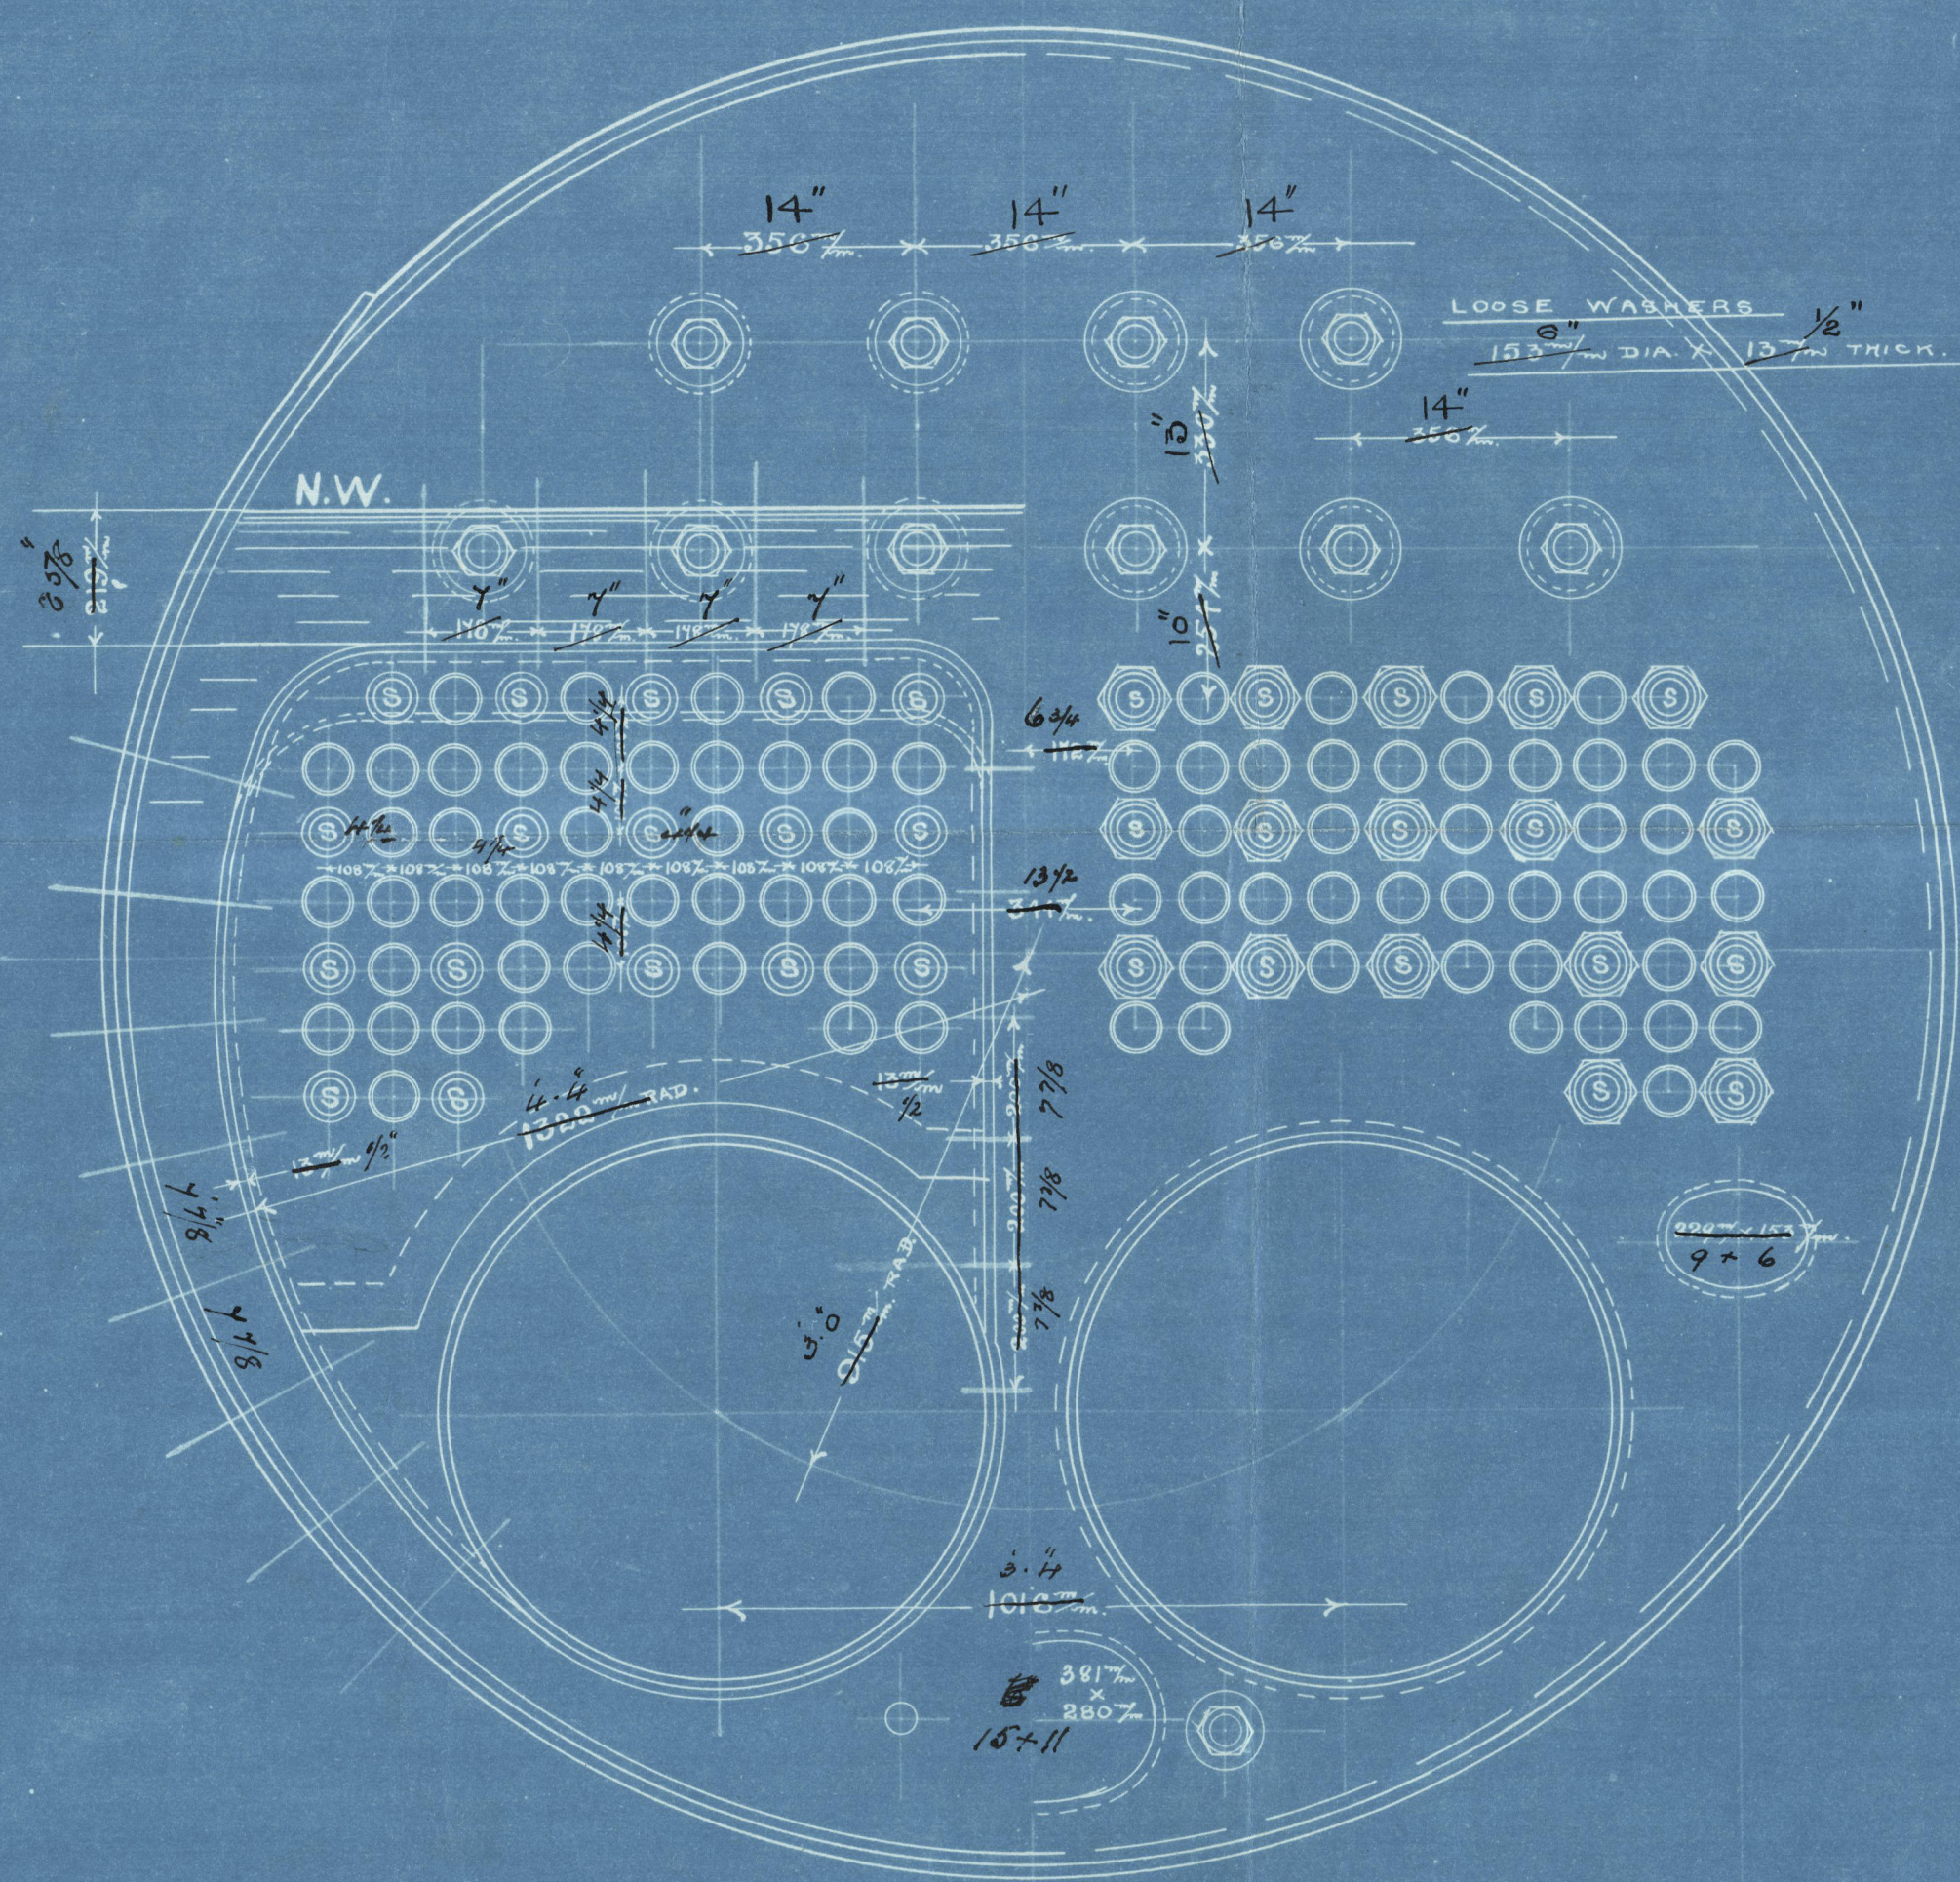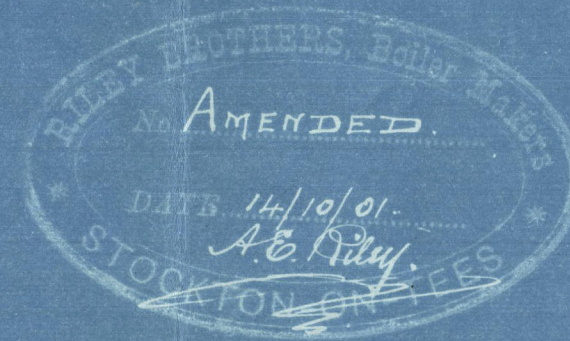

HOLES 21 DIA.  
83<sup>mm</sup> PITCH

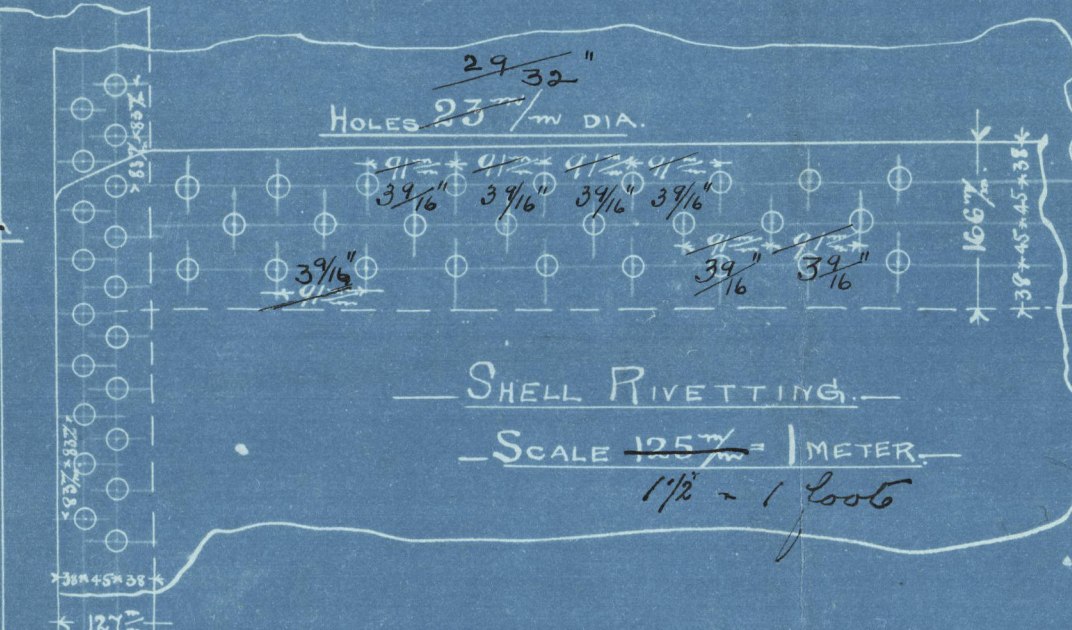


STEEL PLATES & STEEL RIVETS.  
ALL HOLES DRILLED IN POSITION AFTER BENDING.  
PLATES NOT LESS THAN 27 TONS TENSILE.

26.10.01



Soran Hunter 2678.3  
Riley Bros 2999.90 As mp

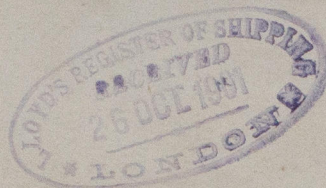

RETAIN



© 2020

Lloyd's Register  
Foundation

W697-0082