


14.8.02
23.8.02
23.9.02


Steel Screw Cargo Steamers.

Proposed arrangement of beams and quarter pillars.

NEDERLANDSCHE
SCHEEPSBOUW-MAATSCHAPPIJ
AMSTERDAM

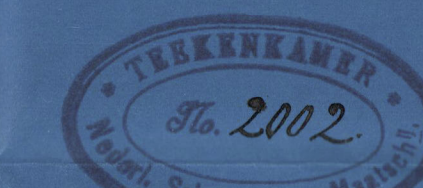

5 August 1902.

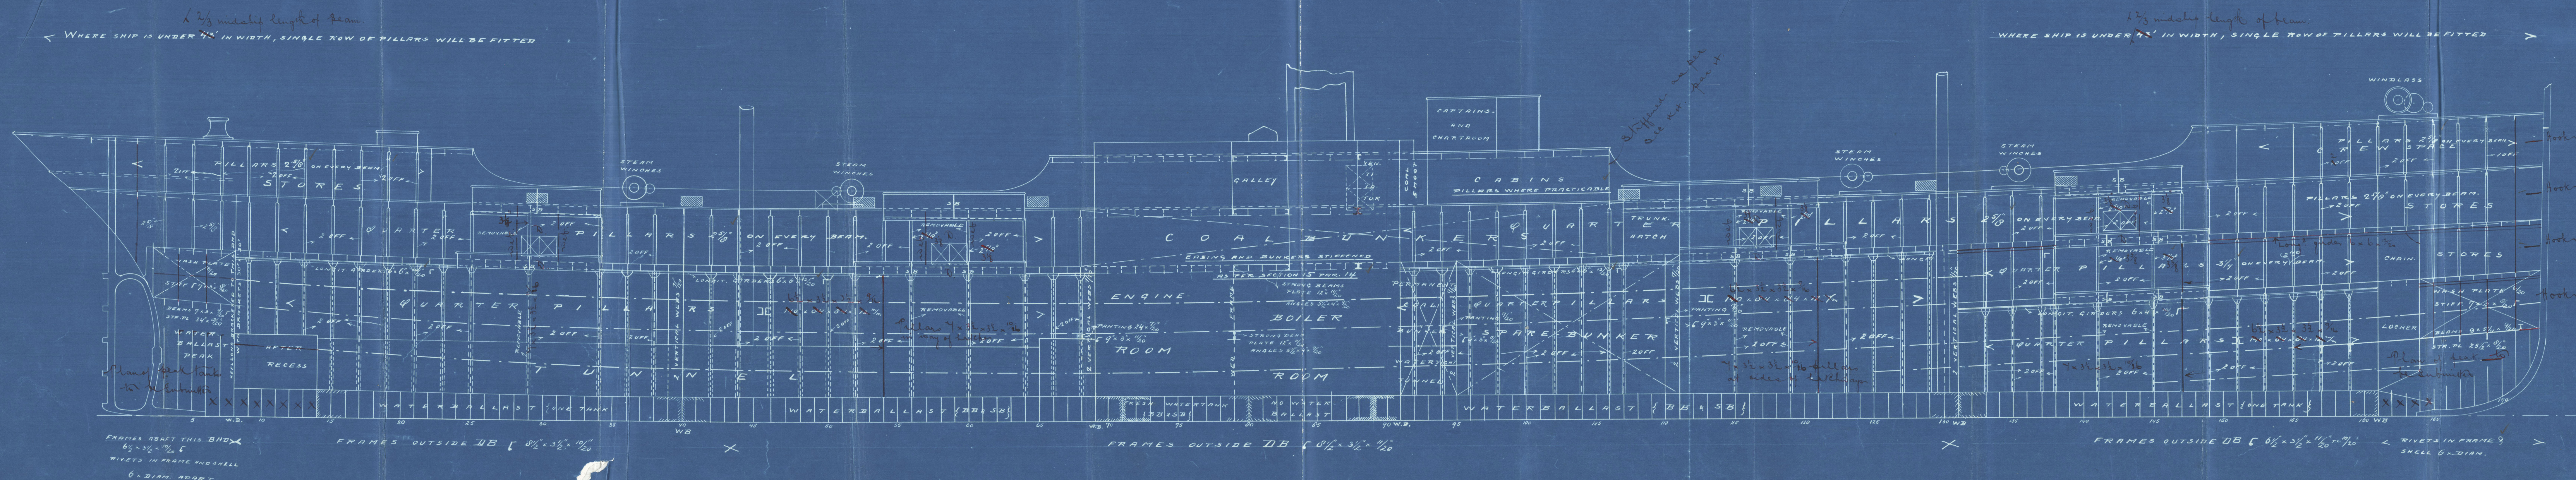


PRINCIPAL DIMENSIONS

LENGTH ACCORDING LLOYDS	347' 2"
BREADTH EXTREME	45' 11"
DEPTH MOULDED TO SPARDECK	29' 6"
HEIGHT OF BRIDGE AND ROOF	7' 9"
FORE CASTLE	7' 6"
ROUND OF BERM	0' 11 1/2"
RISE OF FLOORS	1' 0"

LLOYDS NUMBER

1 ST NUMBER 22-10 1/2 + 22-0 + 41-0	30' 3"
2 ND " 87.3 + 347.167	30' 3"
COMBINED LENGTH OF ROOF AND 2 ND DECK	32.00 + 183
EQUIPMENT NUMBER 35' 116 + 30' 117	30' 0"
LENGTH: DEPTH (TO MAINDECK)	15.00
" " BREADTH	7.56

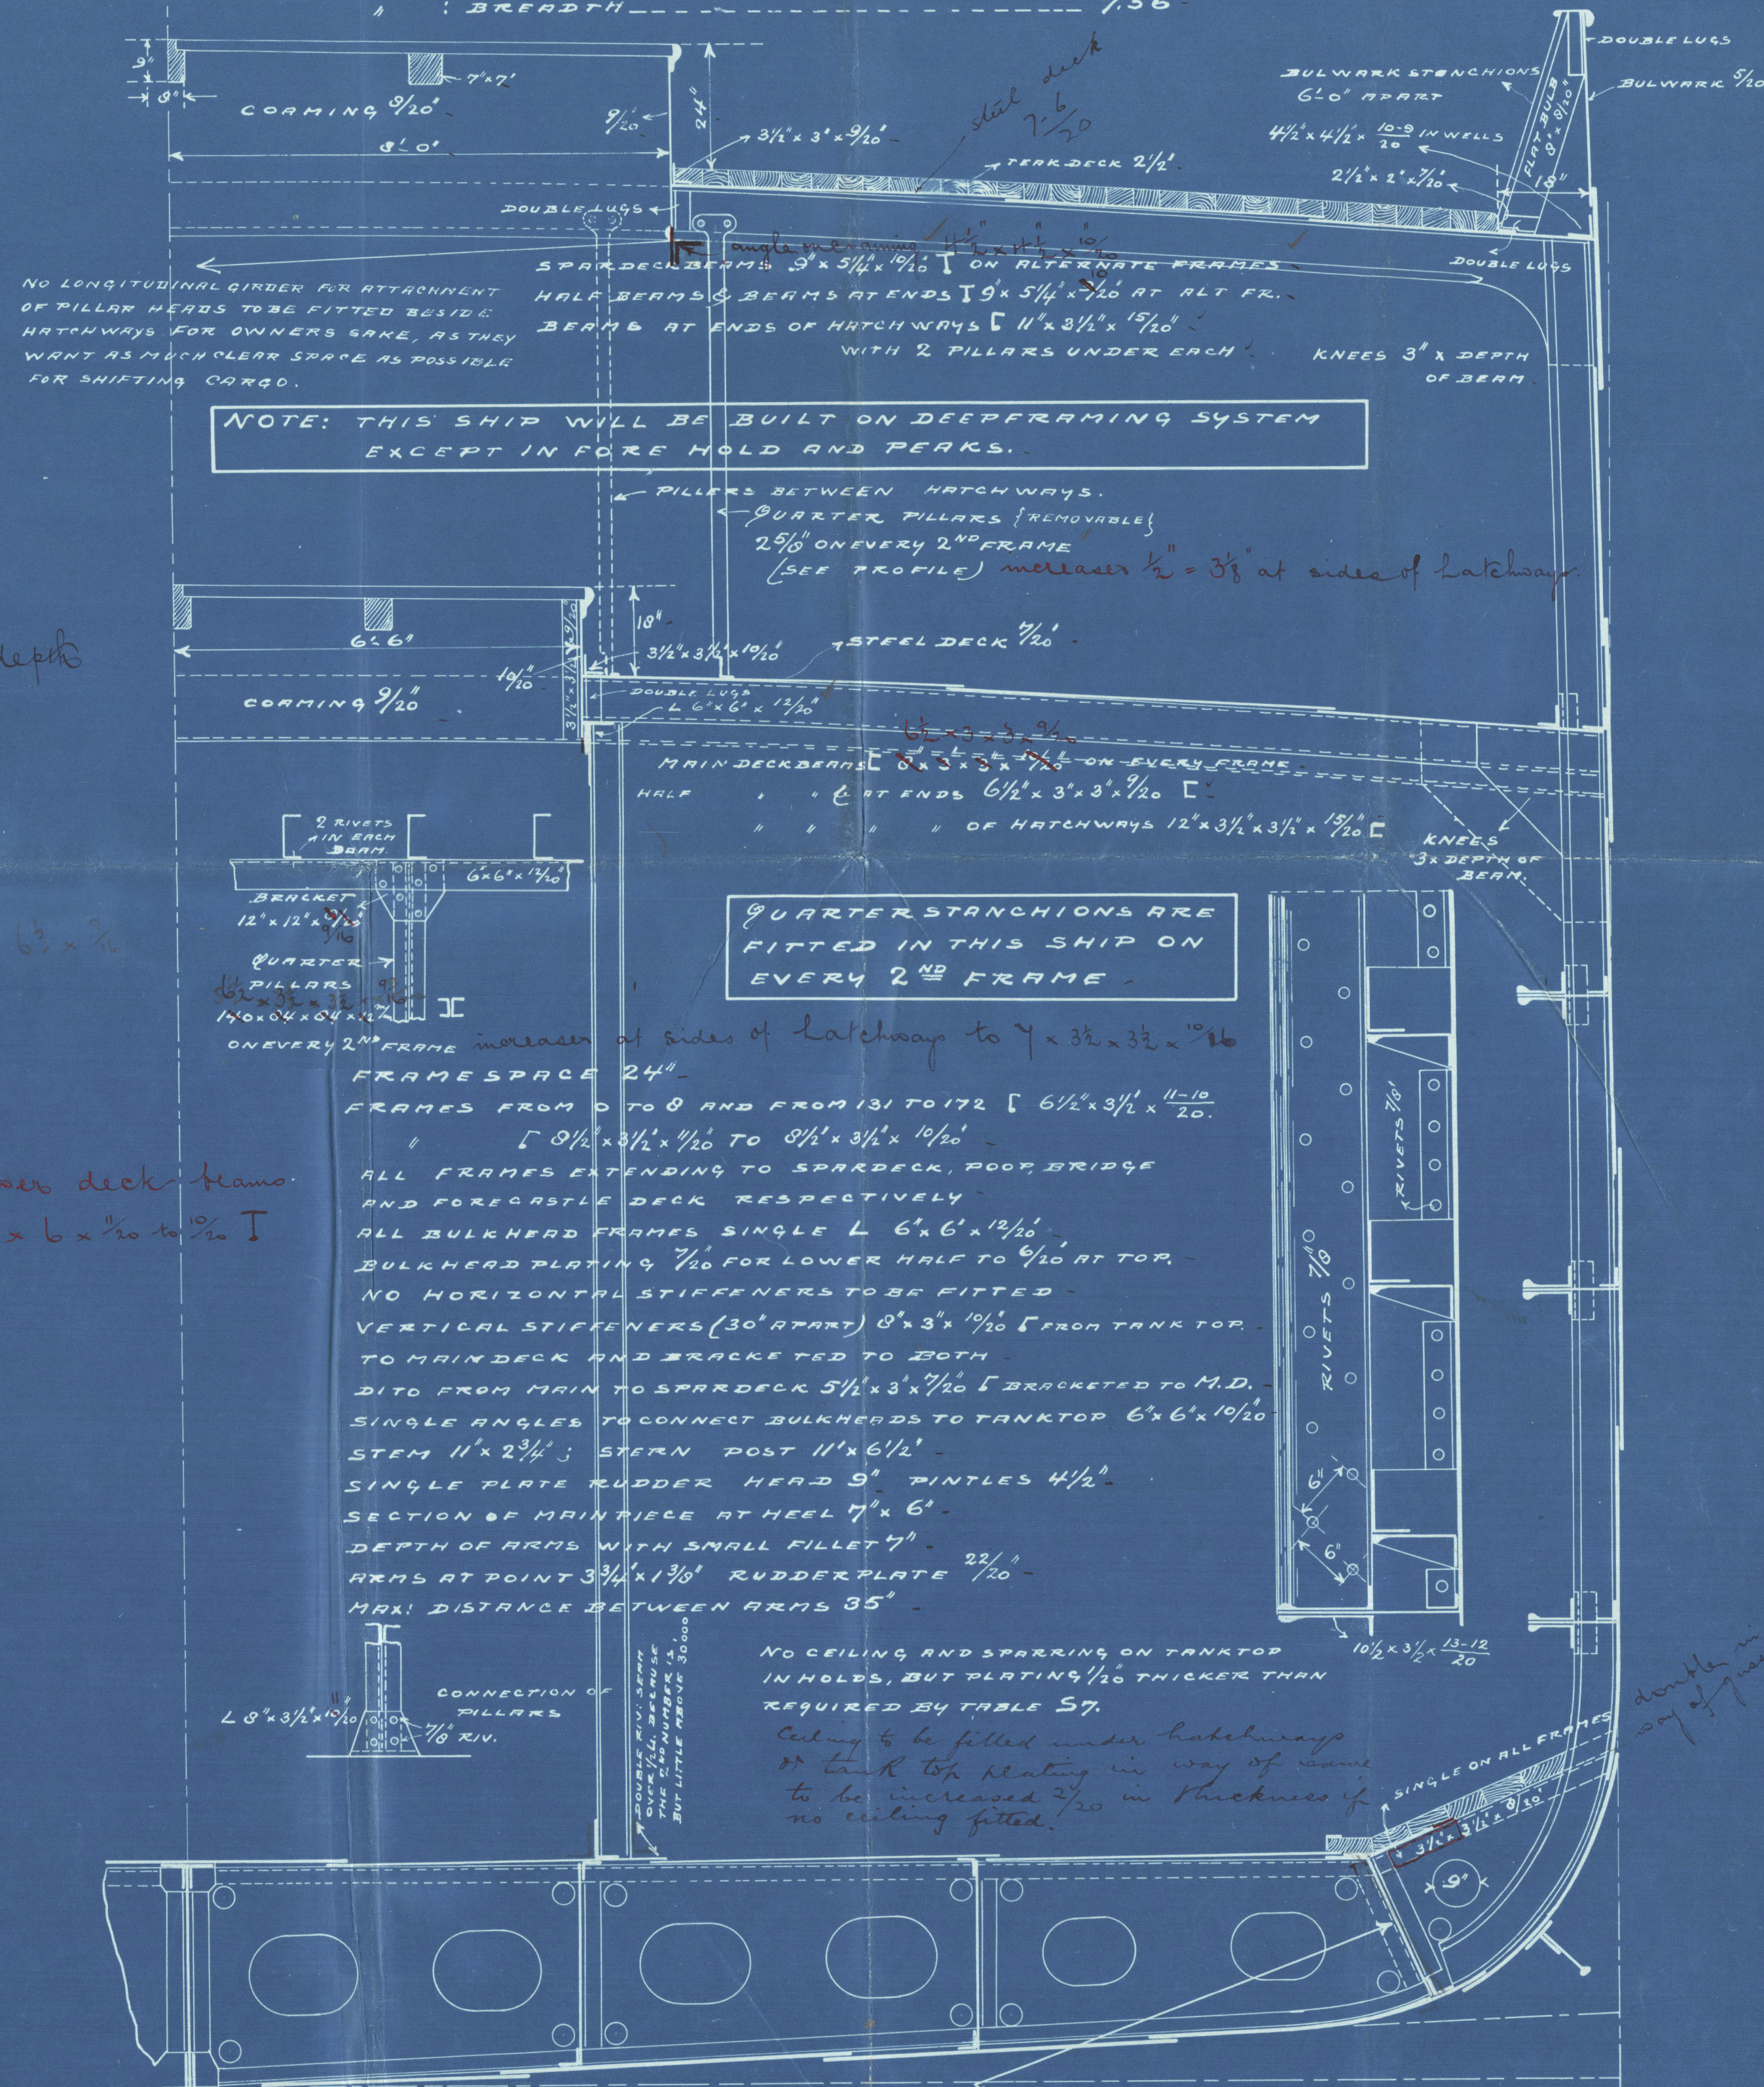

14.8.02
23.8.02
23.9.02

LLOYD'S REGISTER OF SHIPPING
RECEIVED
11 AUG 1902
LONDON

4/ 51 352

Steamer Tjipanas

LLOYD'S REGISTER OF SHIPPING
RECEIVED
19 AUG 1902
LONDON

LLOYD'S REGISTER OF SHIPPING
RECEIVED
19 SEP 1902
LONDON

S.S. Tjipanas.

Ans. 2712

LLOYD'S REGISTER OF SHIPPING
RECEIVED
19 AUG 1902
LONDON

RETAIN

LLOYD'S REGISTER OF SHIPPING
RECEIVED
15 AUG 1902
LONDON

LLOYD'S REGISTER OF SHIPPING
RECEIVED
11 AUG 1902
LONDON

LLOYD'S REGISTER OF SHIPPING
RECEIVED
19 AUG 1902
LONDON

LLOYD'S REGISTER OF SHIPPING
RECEIVED
11 AUG 1902
LONDON

LLOYD'S REGISTER OF SHIPPING
RECEIVED
15 AUG 1902
LONDON



© 2020

Lloyd's Register
Foundation

W697 - 0252