




N^{os} 431 - 432
 PROFILE AND DECK PLAN

DIM. 127'-0" x 22'-0" EX. x 12'-9" MOULDED.

SCALE 1/4" = ONE FOOT

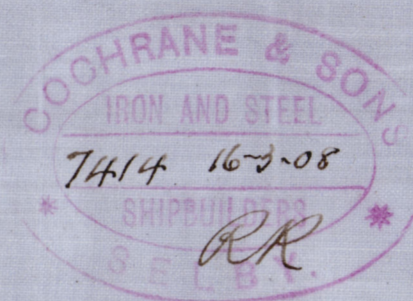

NOTE. ALL DIMS TO SURVEYORS SATISFACTION.

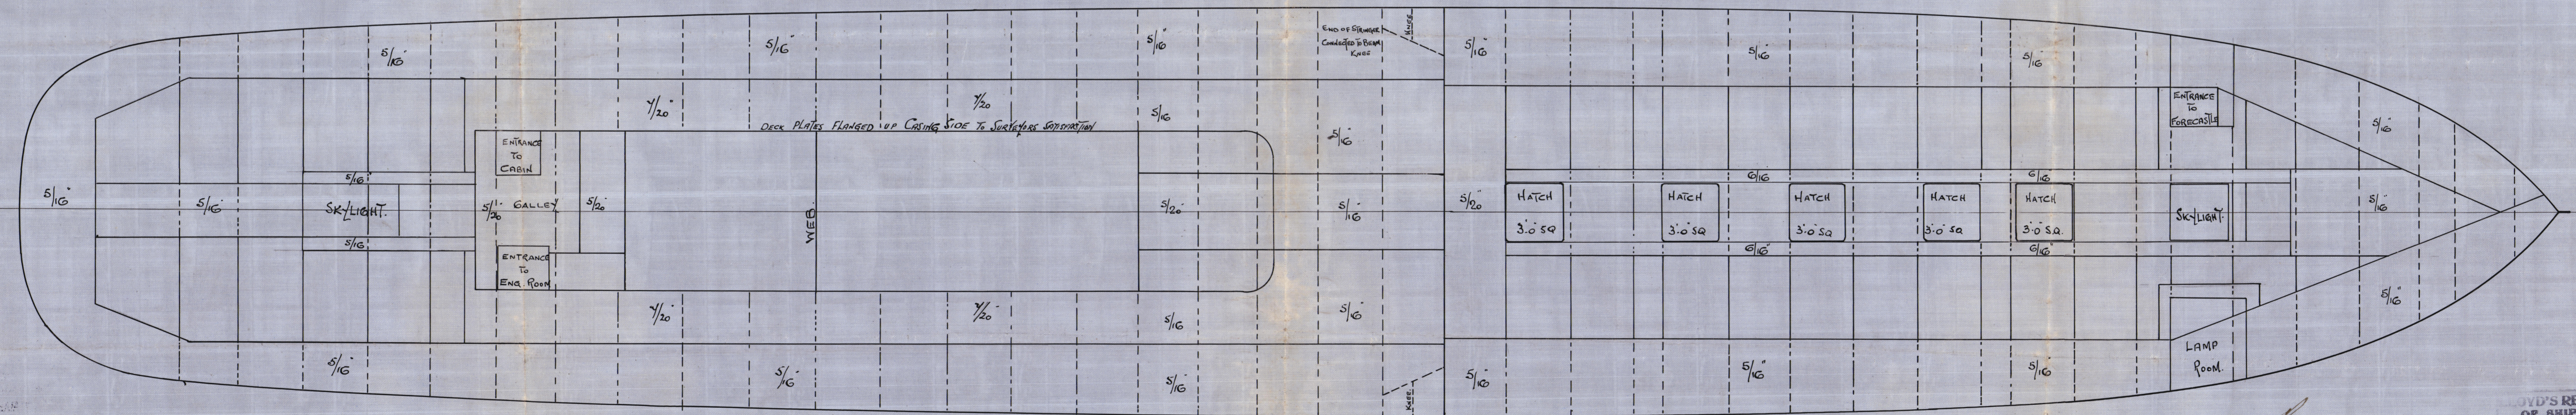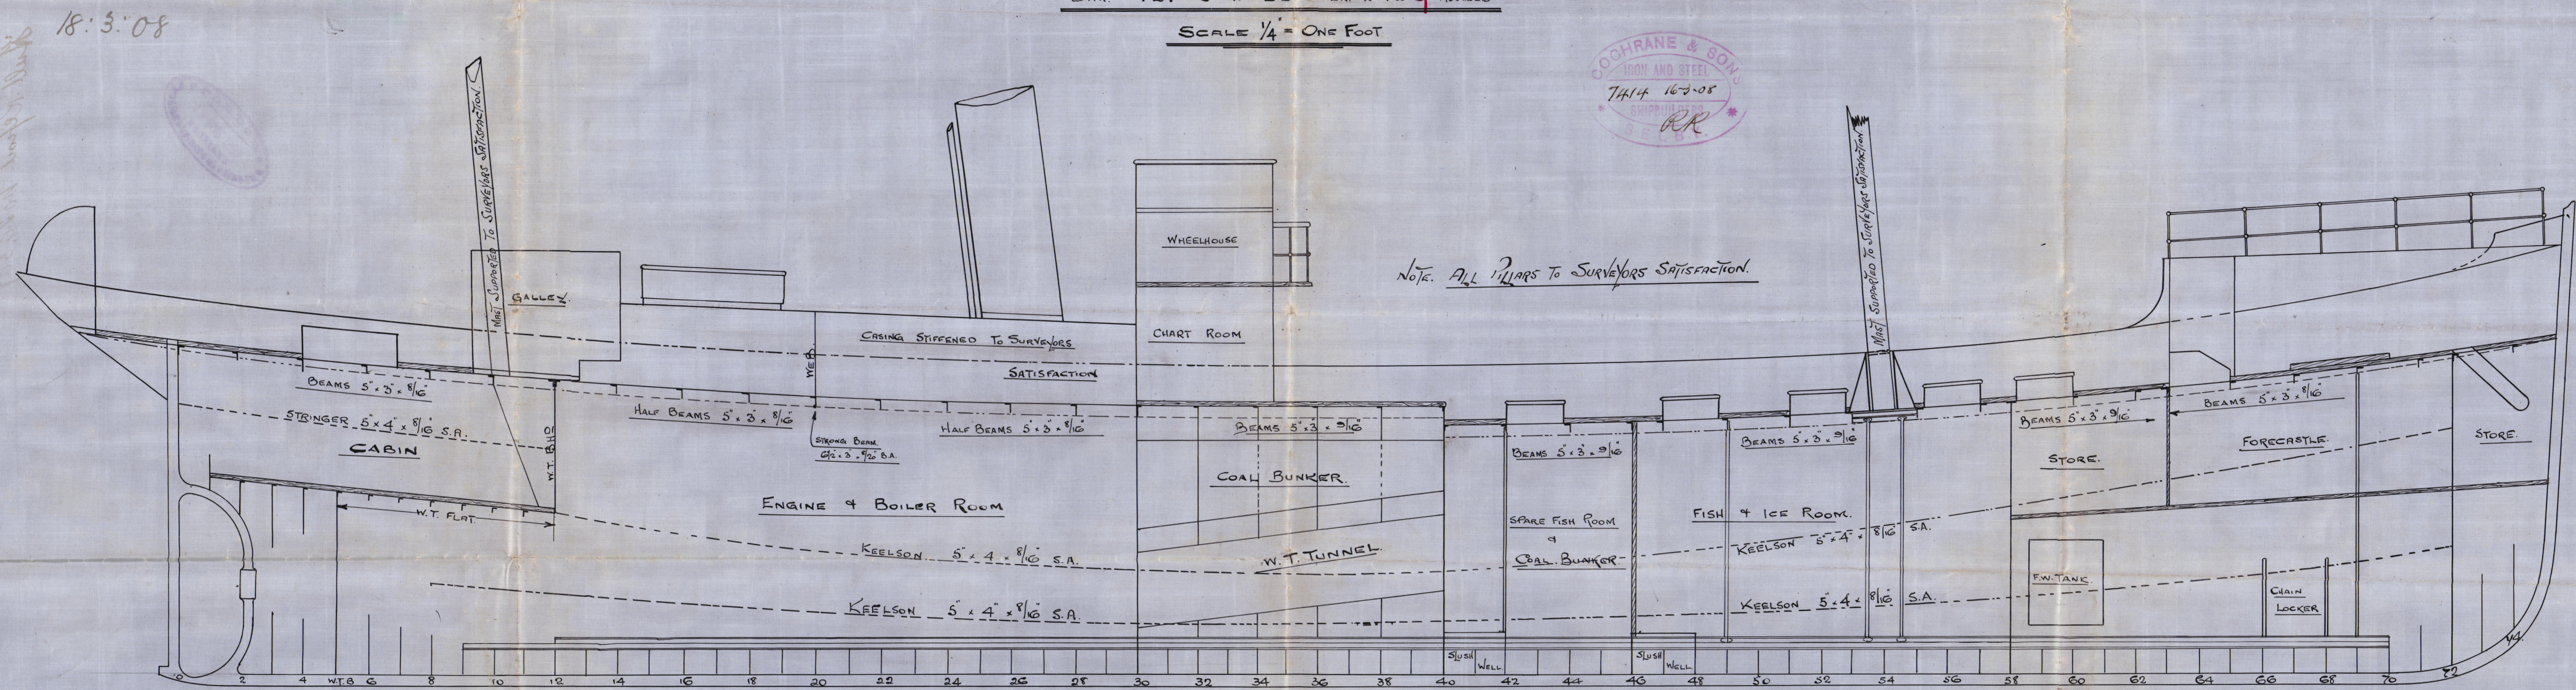

C.B.
 18.3.08.

LOYD'S REGISTER
 OF SHIPPING
 17 MAR 1908
 + HULL +


Cochrane & Sons
Nos 431 & 432.

Profile and Deck Plans

s/s Premier (431)
Hull Report No 20.378

s/s Varonit (432)
Hull Report No 20.507

P.
W.
D.

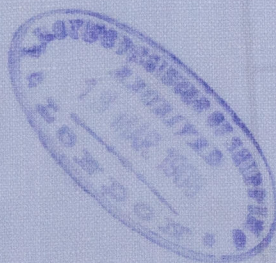

RETAIN



© 2020

Lloyd's Register
Foundation

W698-0013