


24.11.99
 12.4.00 (P.116)
 10.5.00 (P.117)
 6.6.00 (P.118)
 26.6.00 (P.119)
 17.8.00 (P.120)



MAIN DECK — S. S. 345 x 47'9" x 30'2 1/2" (TO SPAR) — SCALE 1/8" = ONE FOOT.

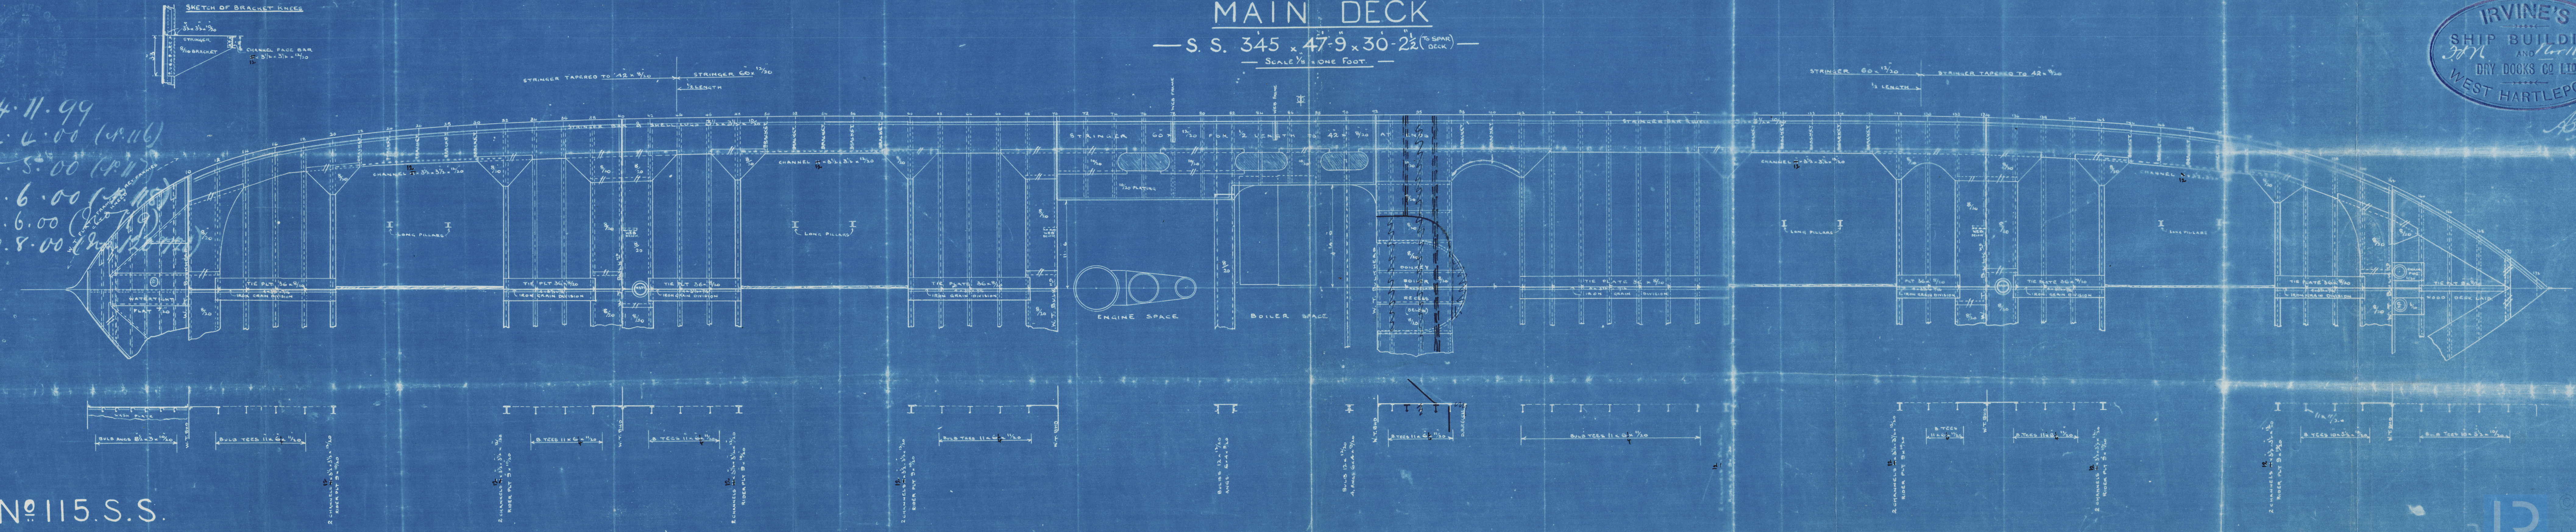

No 115 S.S.
 116 117 118 119 120 121

Irwin's No. 115
Main Deck Plan
"Hendonhall"
Hpl. Report no. 11444

121. Birmingham Apr. 11697.

RETAIN



© 2020

Lloyd's Register
Foundation
W698-0108