


24.11.99
 14.2.00
 12.4.00 (No. 116)
 10.5.00 (No. 117)
 6.6.00 (No. 118)
 26.6.00 (No. 119)
 17.8.00 (No. 120/21)

PROFILE

S.S. 345 x 47' 9" x 30'-2 1/2" (TO SPAR D*)

SCALE 1/8" = ONE FOOT.

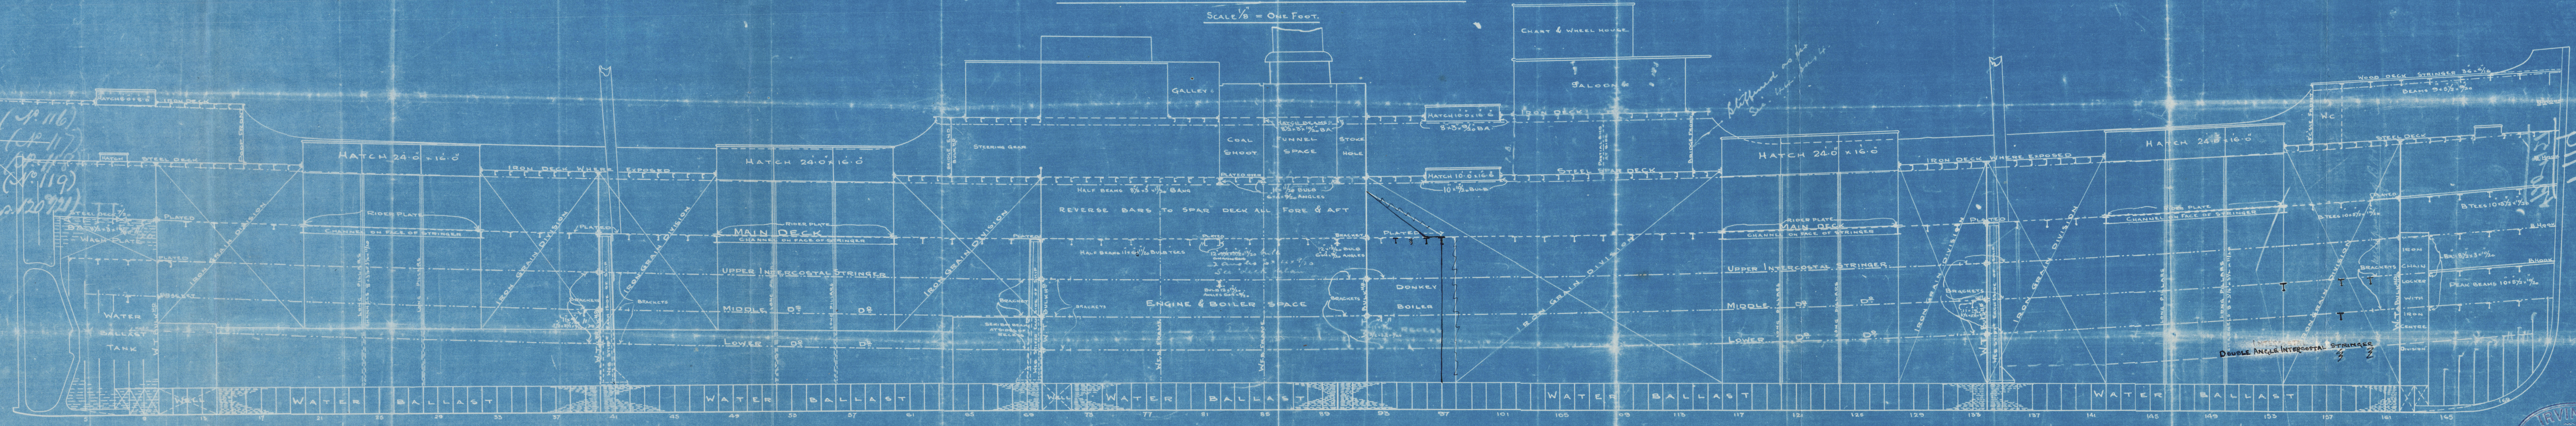

Nº 115 116 117 118 119

120/21

For painting beams
 and stringers at fore
 end in No. 116
 See letter 12/4/00



Irvine's No 115.

Profile

"Hendonhall"

Hpl. Report No. 11444

121 "Birmingham" Hpl. 11697.

RETAIN



© 2020

Lloyd's Register

Foundation
W698-0109