


S.S. N° 196
PROFILE

Scale 1/4" = 1 foot

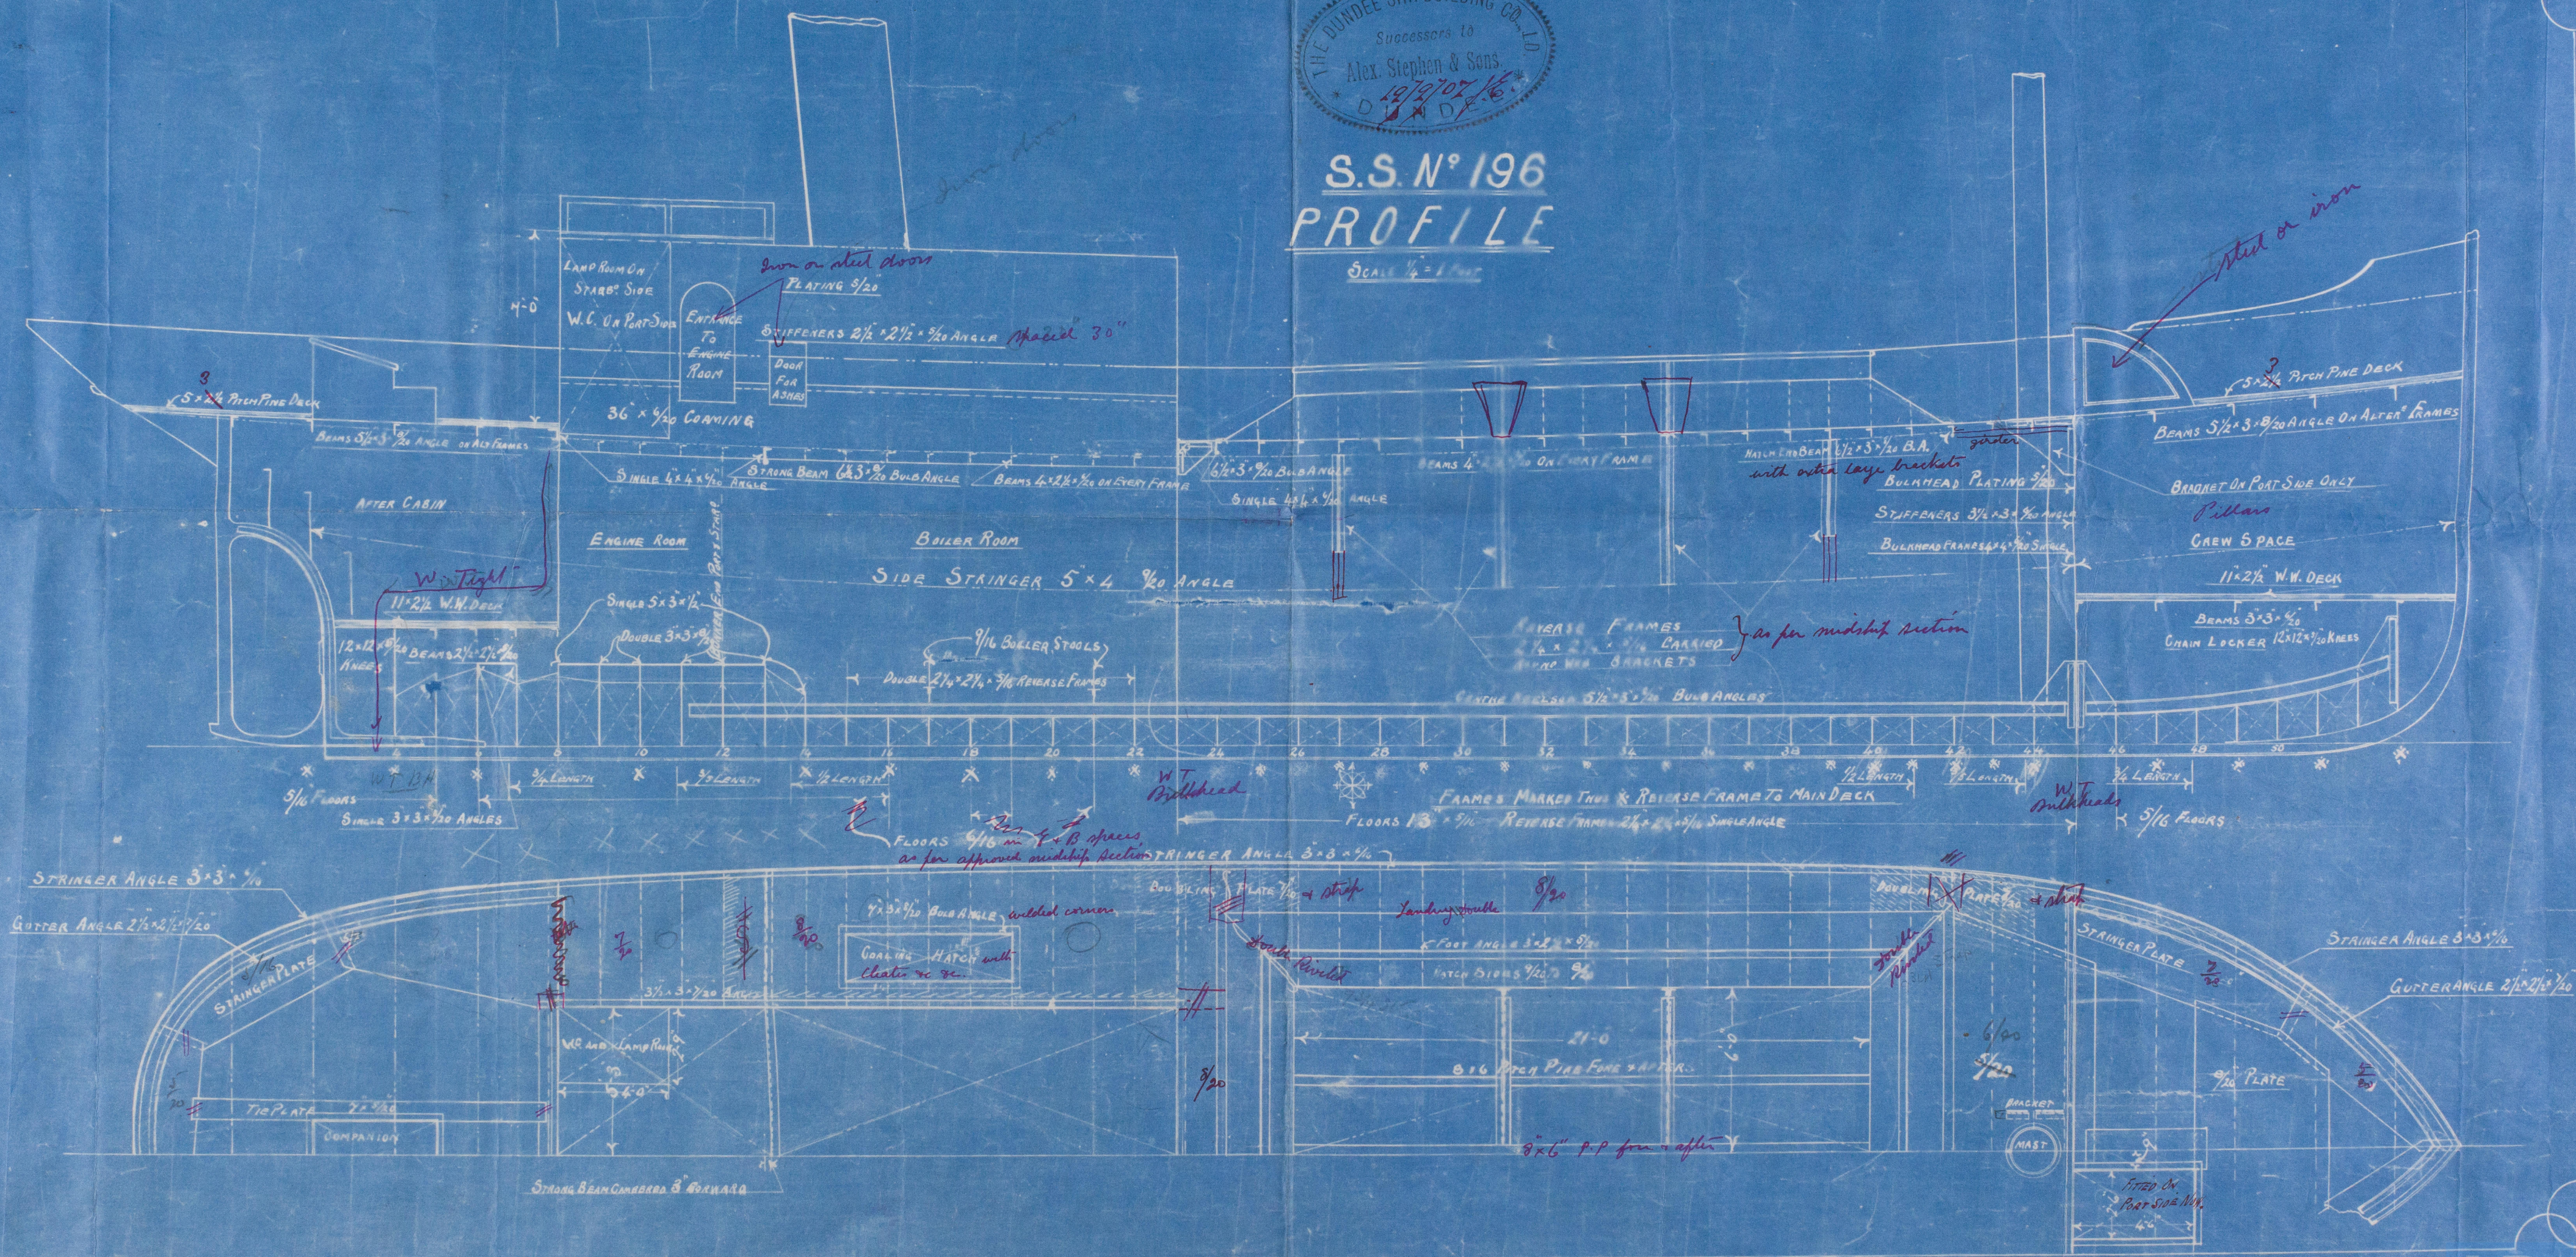

Propels Plans
Sunder MB boys
Comp is. No 196
S.S. PORTLETHEN
Sun Ppt. No 7331

W698-0139

MINI
LE
RE



© 2020

Lloyd's Register
Foundation