
 


T.S. 525'-0" x 60'-0" x 38'-0" TO SHELTER DECK.

SCALE 1/8" = 1 FOOT.

UPPER DECK.

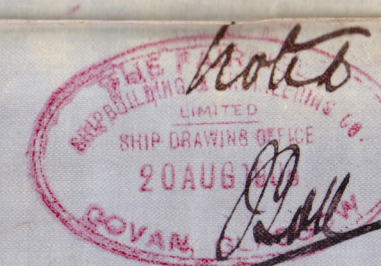

11x3 1/2 x 10
10x3 1/2 x 10 B. ANGLE

11x3 1/2 x 11
10x3 1/2 x 10 B.A.

11x3 1/2 x 13/20
10x3 1/2 x 10 B.A.

UPPER DECK BEAMS 10x3 1/2 x 10 B. ANGLES ON ALT. FRAMES.

11x3 1/2 x 13/20
10x3 1/2 x 10 B.A.

11x3 1/2 x 14/20
10x3 1/2 x 10 B.A.

11x3 1/2 x 17/20
10x3 1/2 x 10 B.A.

11x3 1/2 x 10 7/20
10x3 1/2 x 10 B. ANGLE.

The Tarfua S.W.E.C.
Nos 449 & 450
Plan of Upper R.R.

449 "Heliopolis"

450 "Cairo"

Glasgow Report. No. 26157



W648-0195



© 2020

Lloyd's Register
Foundation