



T.S. 525'-0" x 60'-0" x 38'-0" TO SHELTER DECK.

SCALE 1/8" = 1 FOOT.

6.7.06

BOAT DECK.

ANGLE BEAMS 5' 2 1/2" x 20" ON ALT. FRAMES.

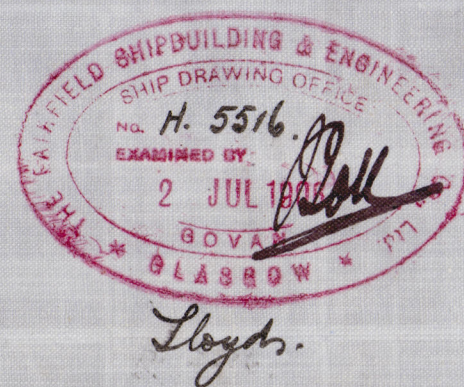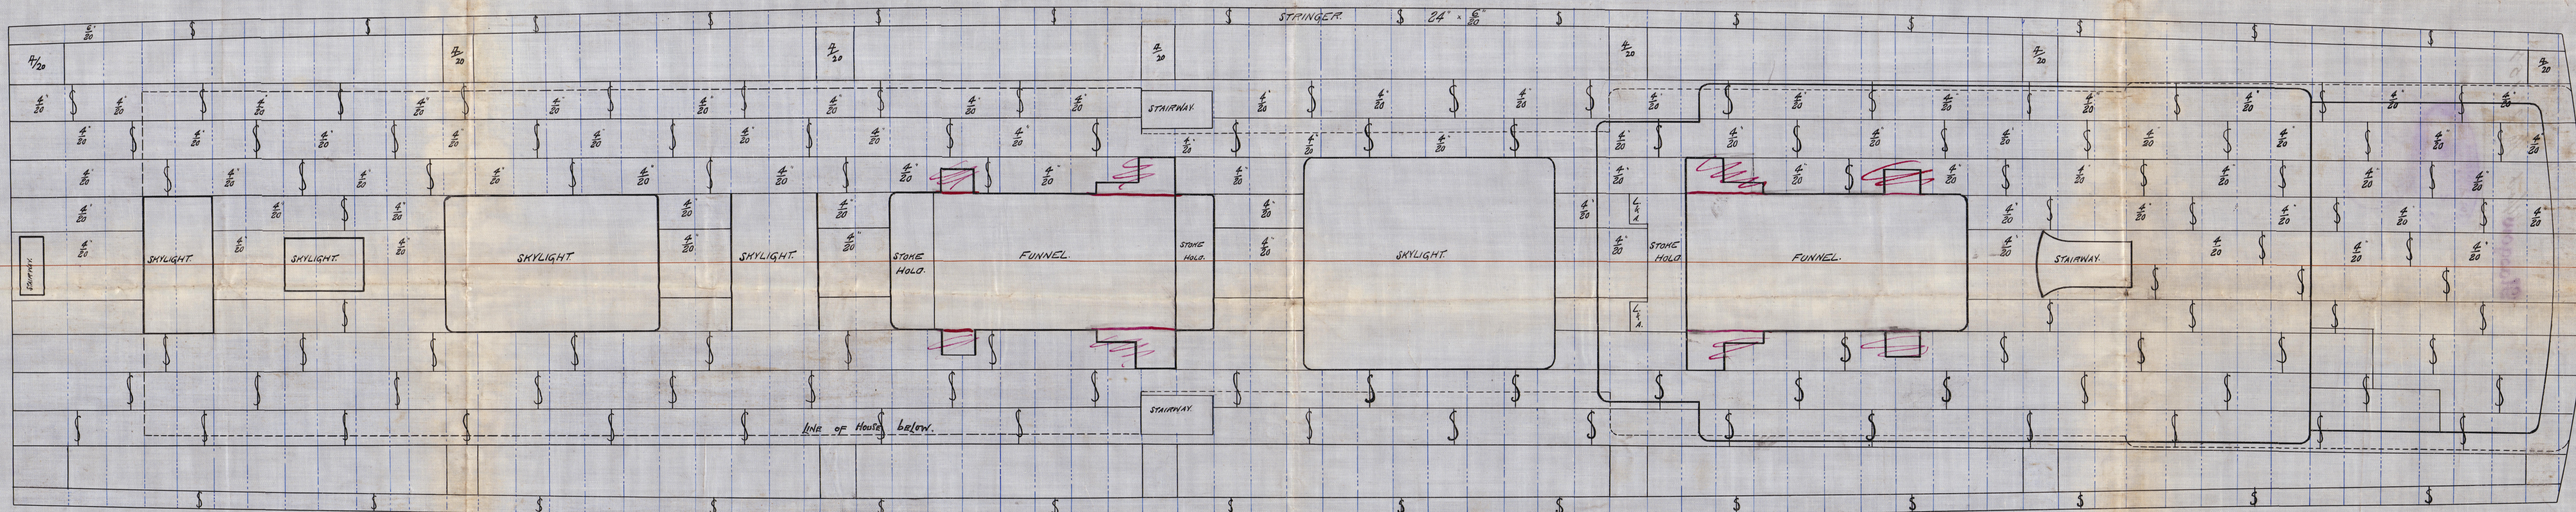

H. 5516
6.7.06

13
The Fairfield S. B. & Co


Nos 449 & 450

Plan of Boat DR

449 "Heliopolis"

450 "Cairo"

Glasgow Work No 26157

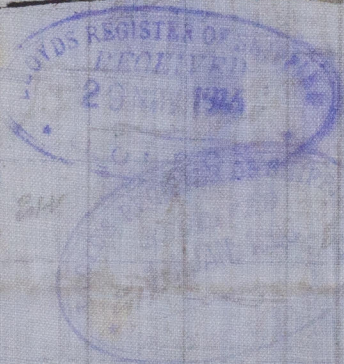

© 2020

Lloyd's Register
Foundation

W648-0202