


21. 2. 07  
27. 2. 07  
5. 3. 07.


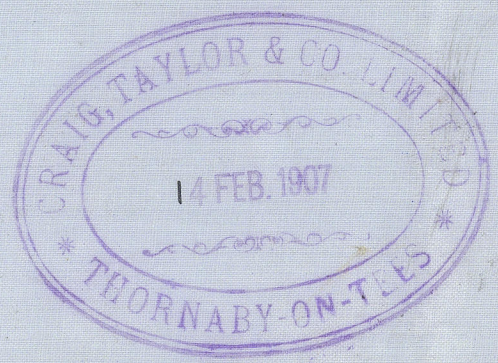


"Baltic Sea"  
S.S. N<sup>o</sup> 125.

LONGITUDINAL SECTION

SCALE 1/8 IN = 1 FT.

TRACING N<sup>o</sup> 8791

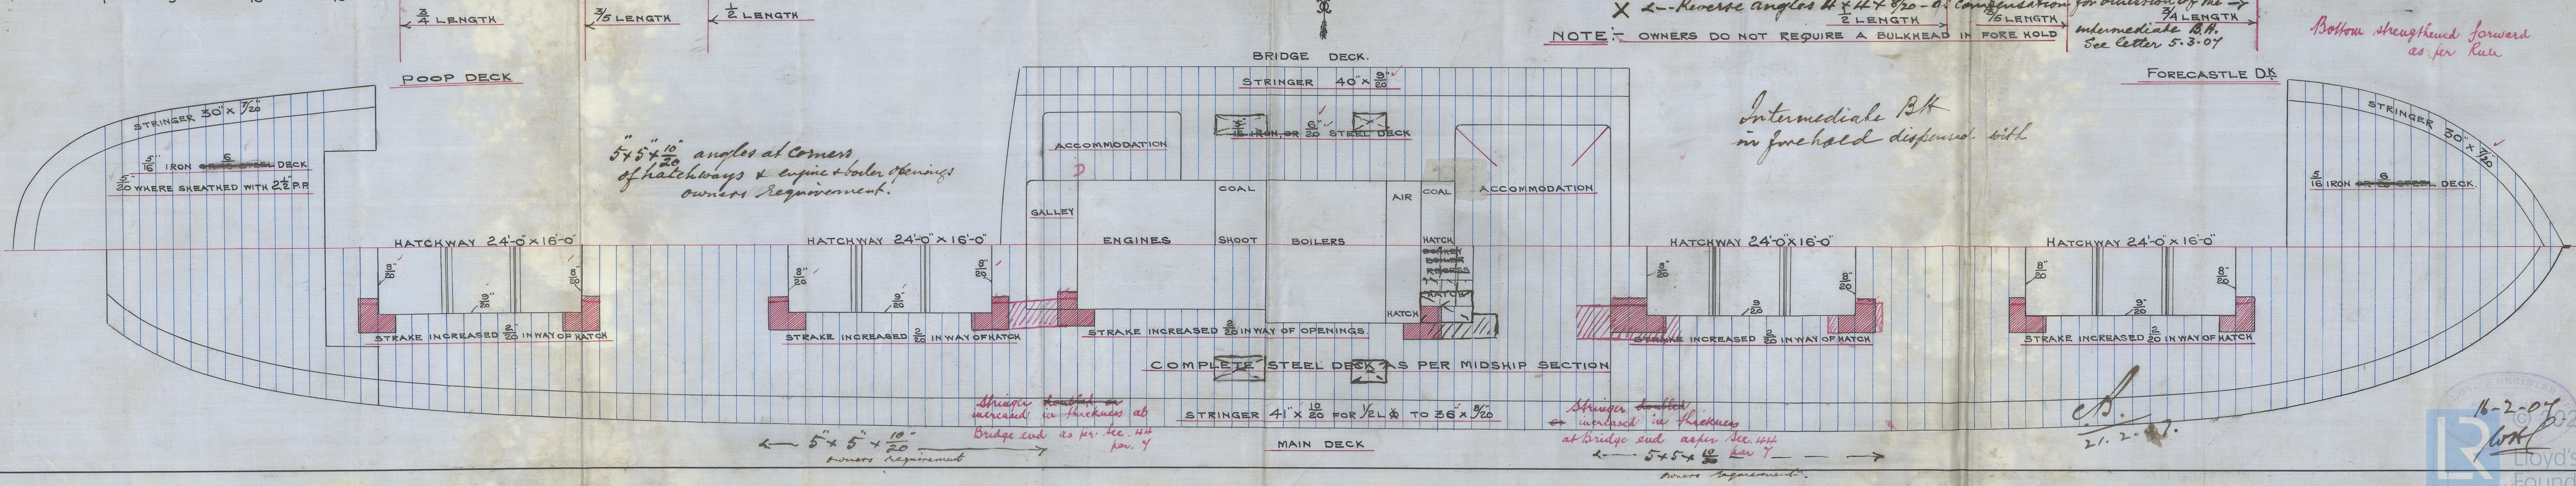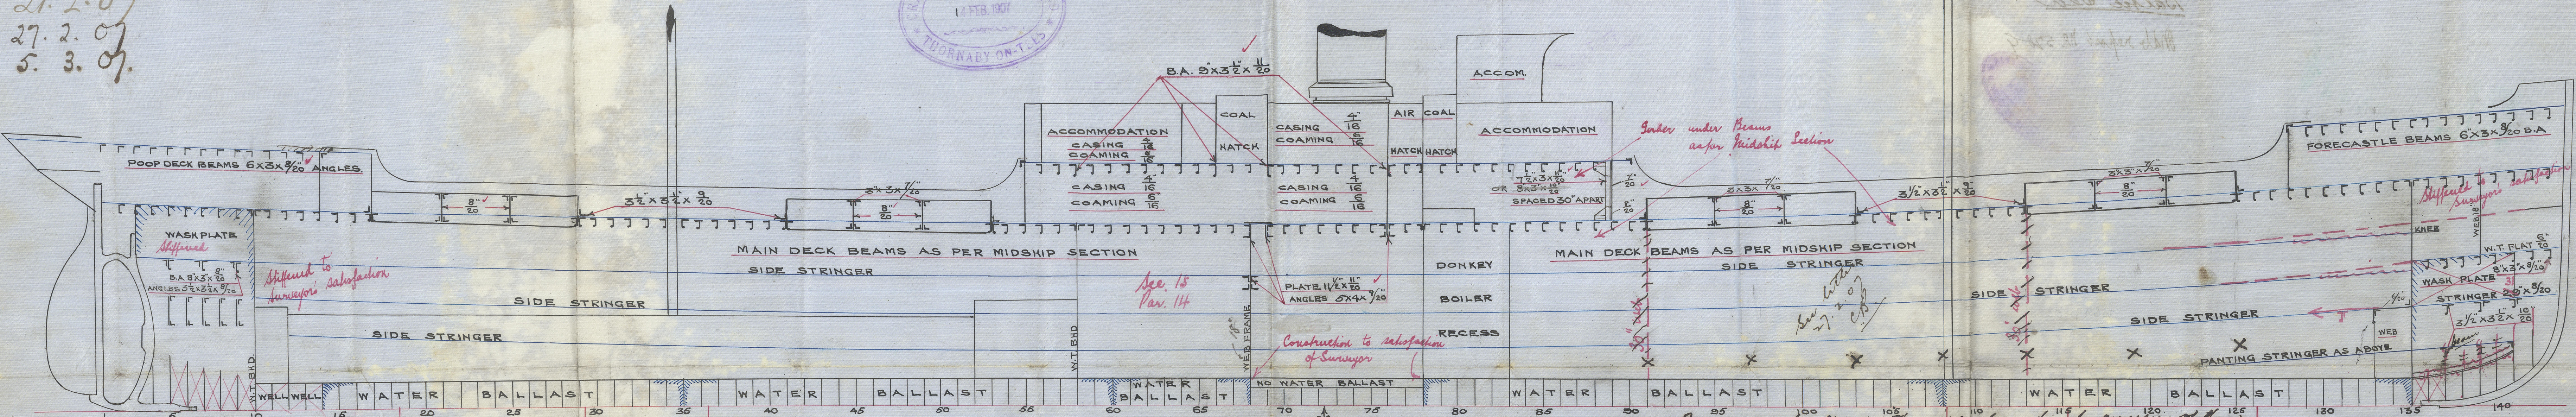




Craig Taylor  
No 125

Profile & deck plans

"Baltic Sea"

Onlv report no. 5209

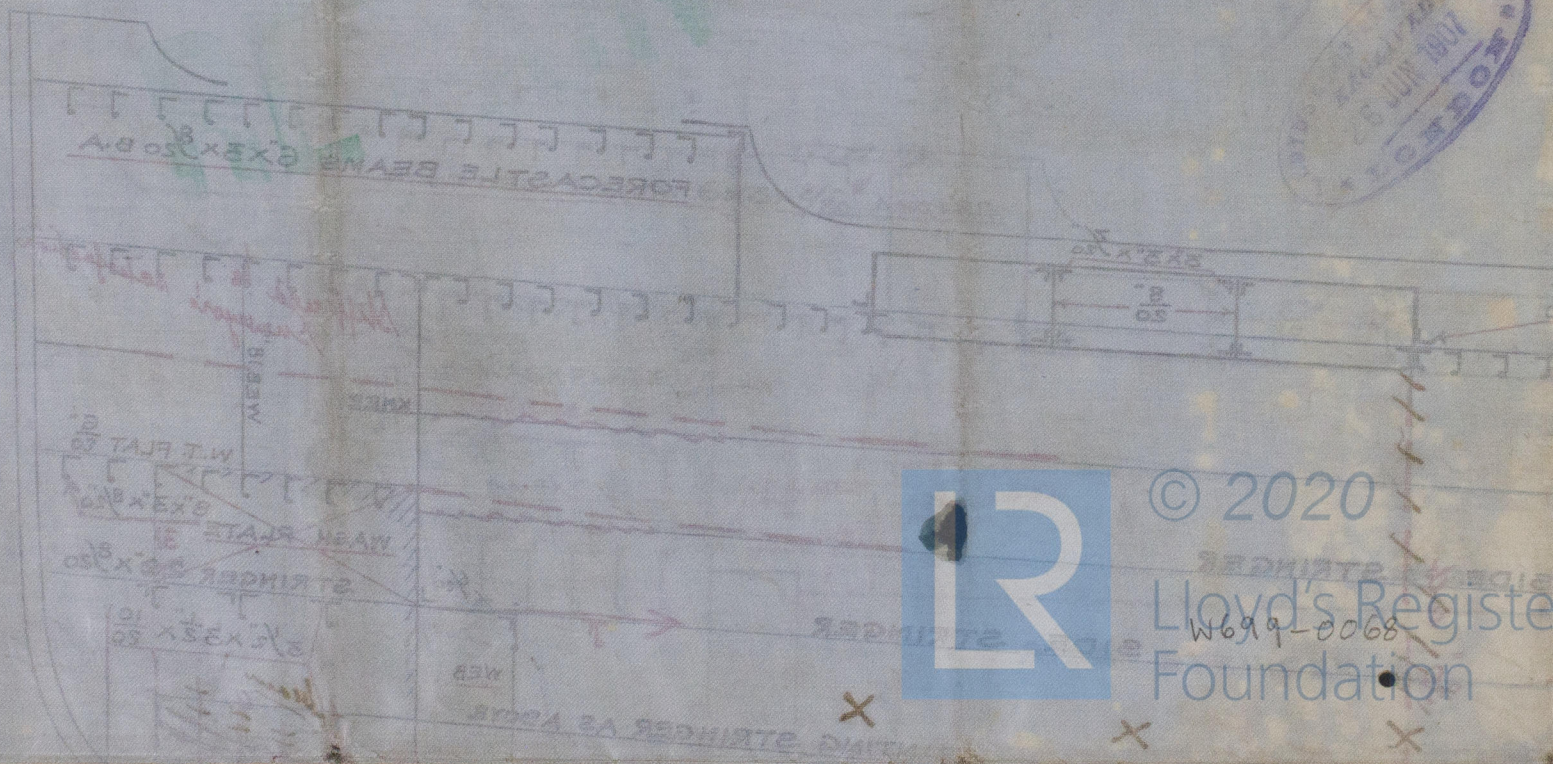

© 2020

Lloyd's Register  
Foundation