

LLOYD'S REGISTER  
 9.11.01



DONKEY BOILER No 483.


ENGINE No 262

TO PASS LLOYD'S FOR A WORKING PRESSURE


OF 80 LBS. PER SQ. INCH

SCALE 1 INCH = 1 FOOT.


ALL PLATES AND RIVETS STEEL  
 ALL HOLES DRILLED IN PLACE  $\frac{1}{16}$ " DIA.  
 LONGITUDINAL SEAMS TREBLE RIVETTED  
 CIRCUMFERENTIAL SEAMS SINGLE RIVETTED  
 TENSILE STRENGTH OF PLATES 27 TO 30 TONS

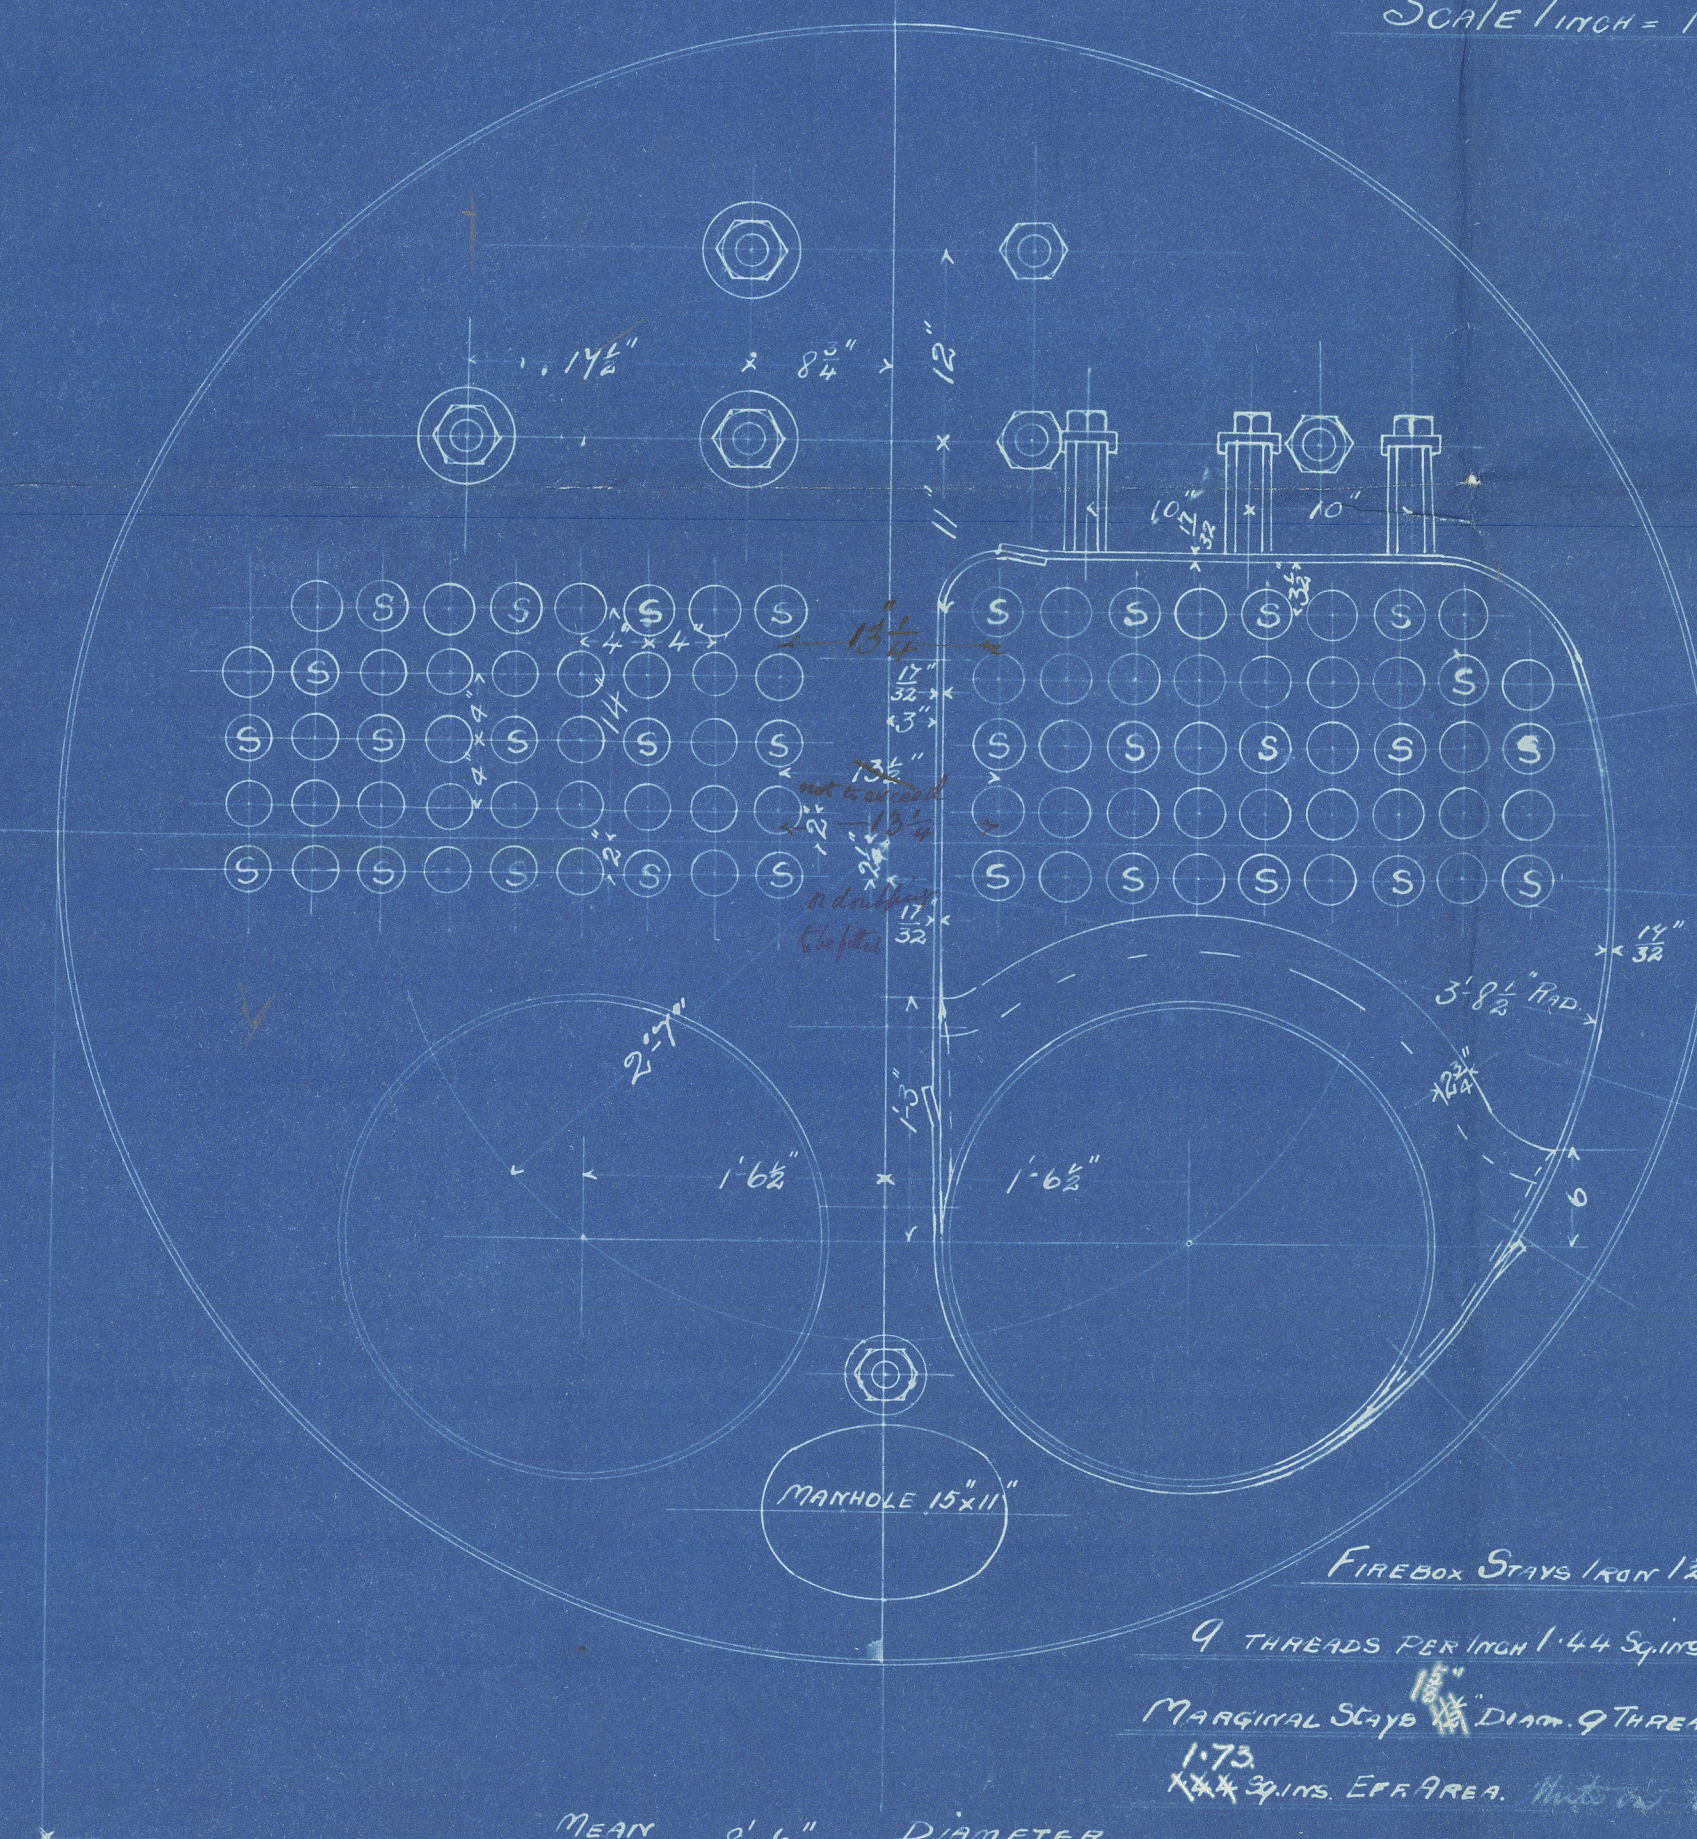

FIREBOX STAYS 1/2" DIA.  
 9 THREADS PER INCH 1.44 SQ. INS. EFF. AREA.  
 MARGINAL STAYS 1/2" DIA. 9 THREADS PER INCH.  
 1.73 SQ. INS. EFF. AREA.

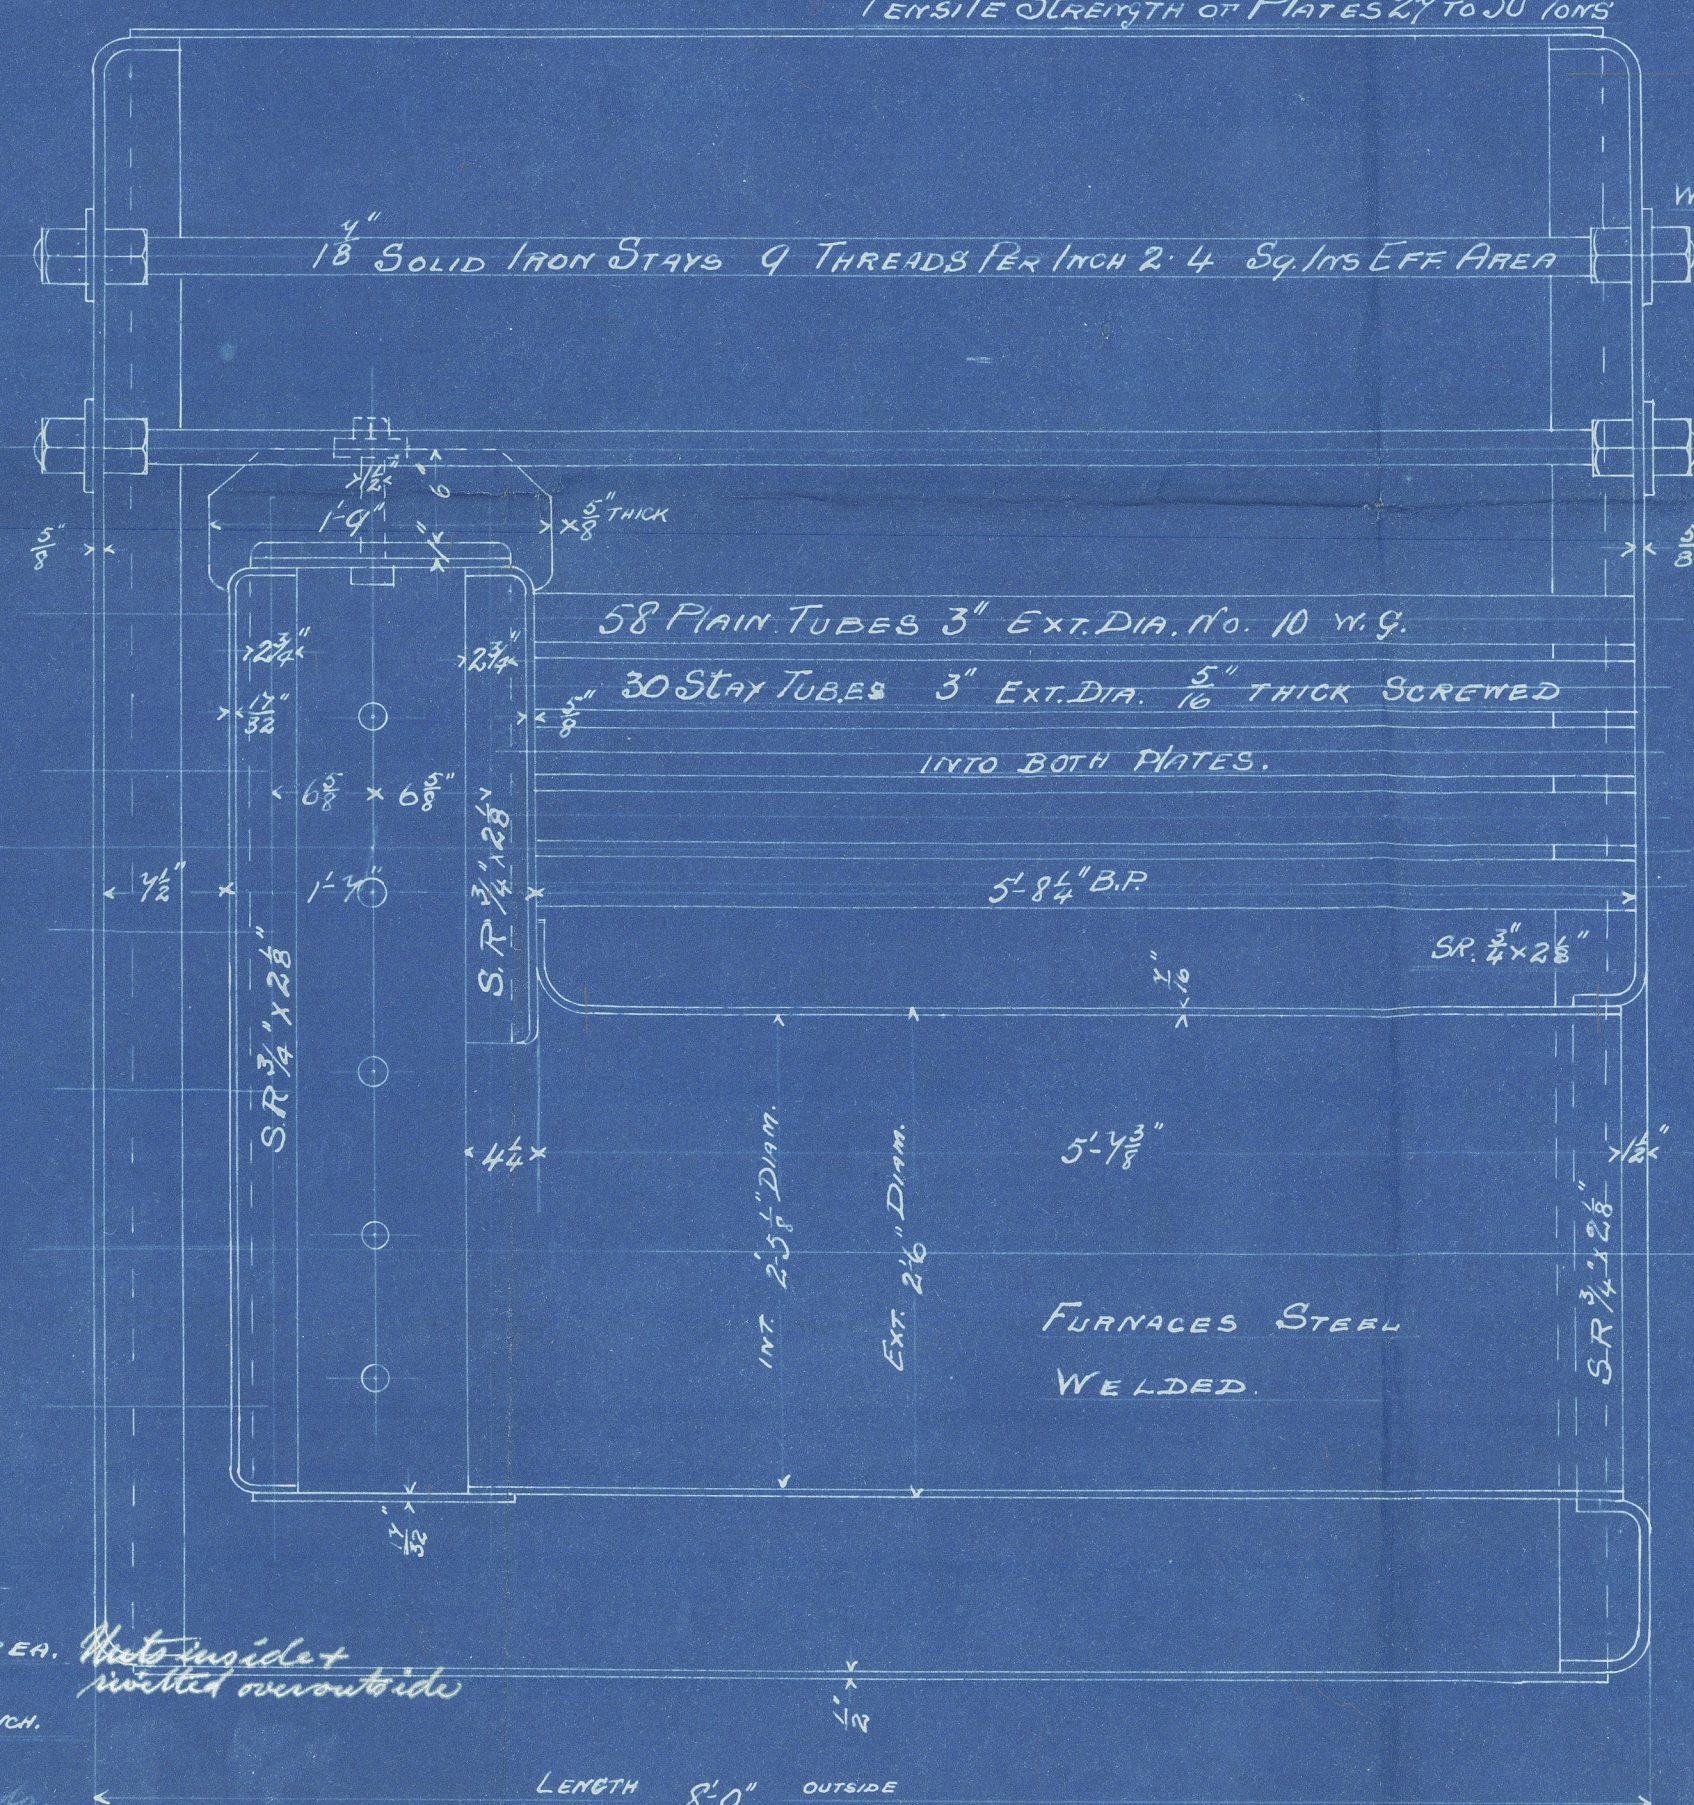

WASHERS 6" DIA. X 7/16" THICK

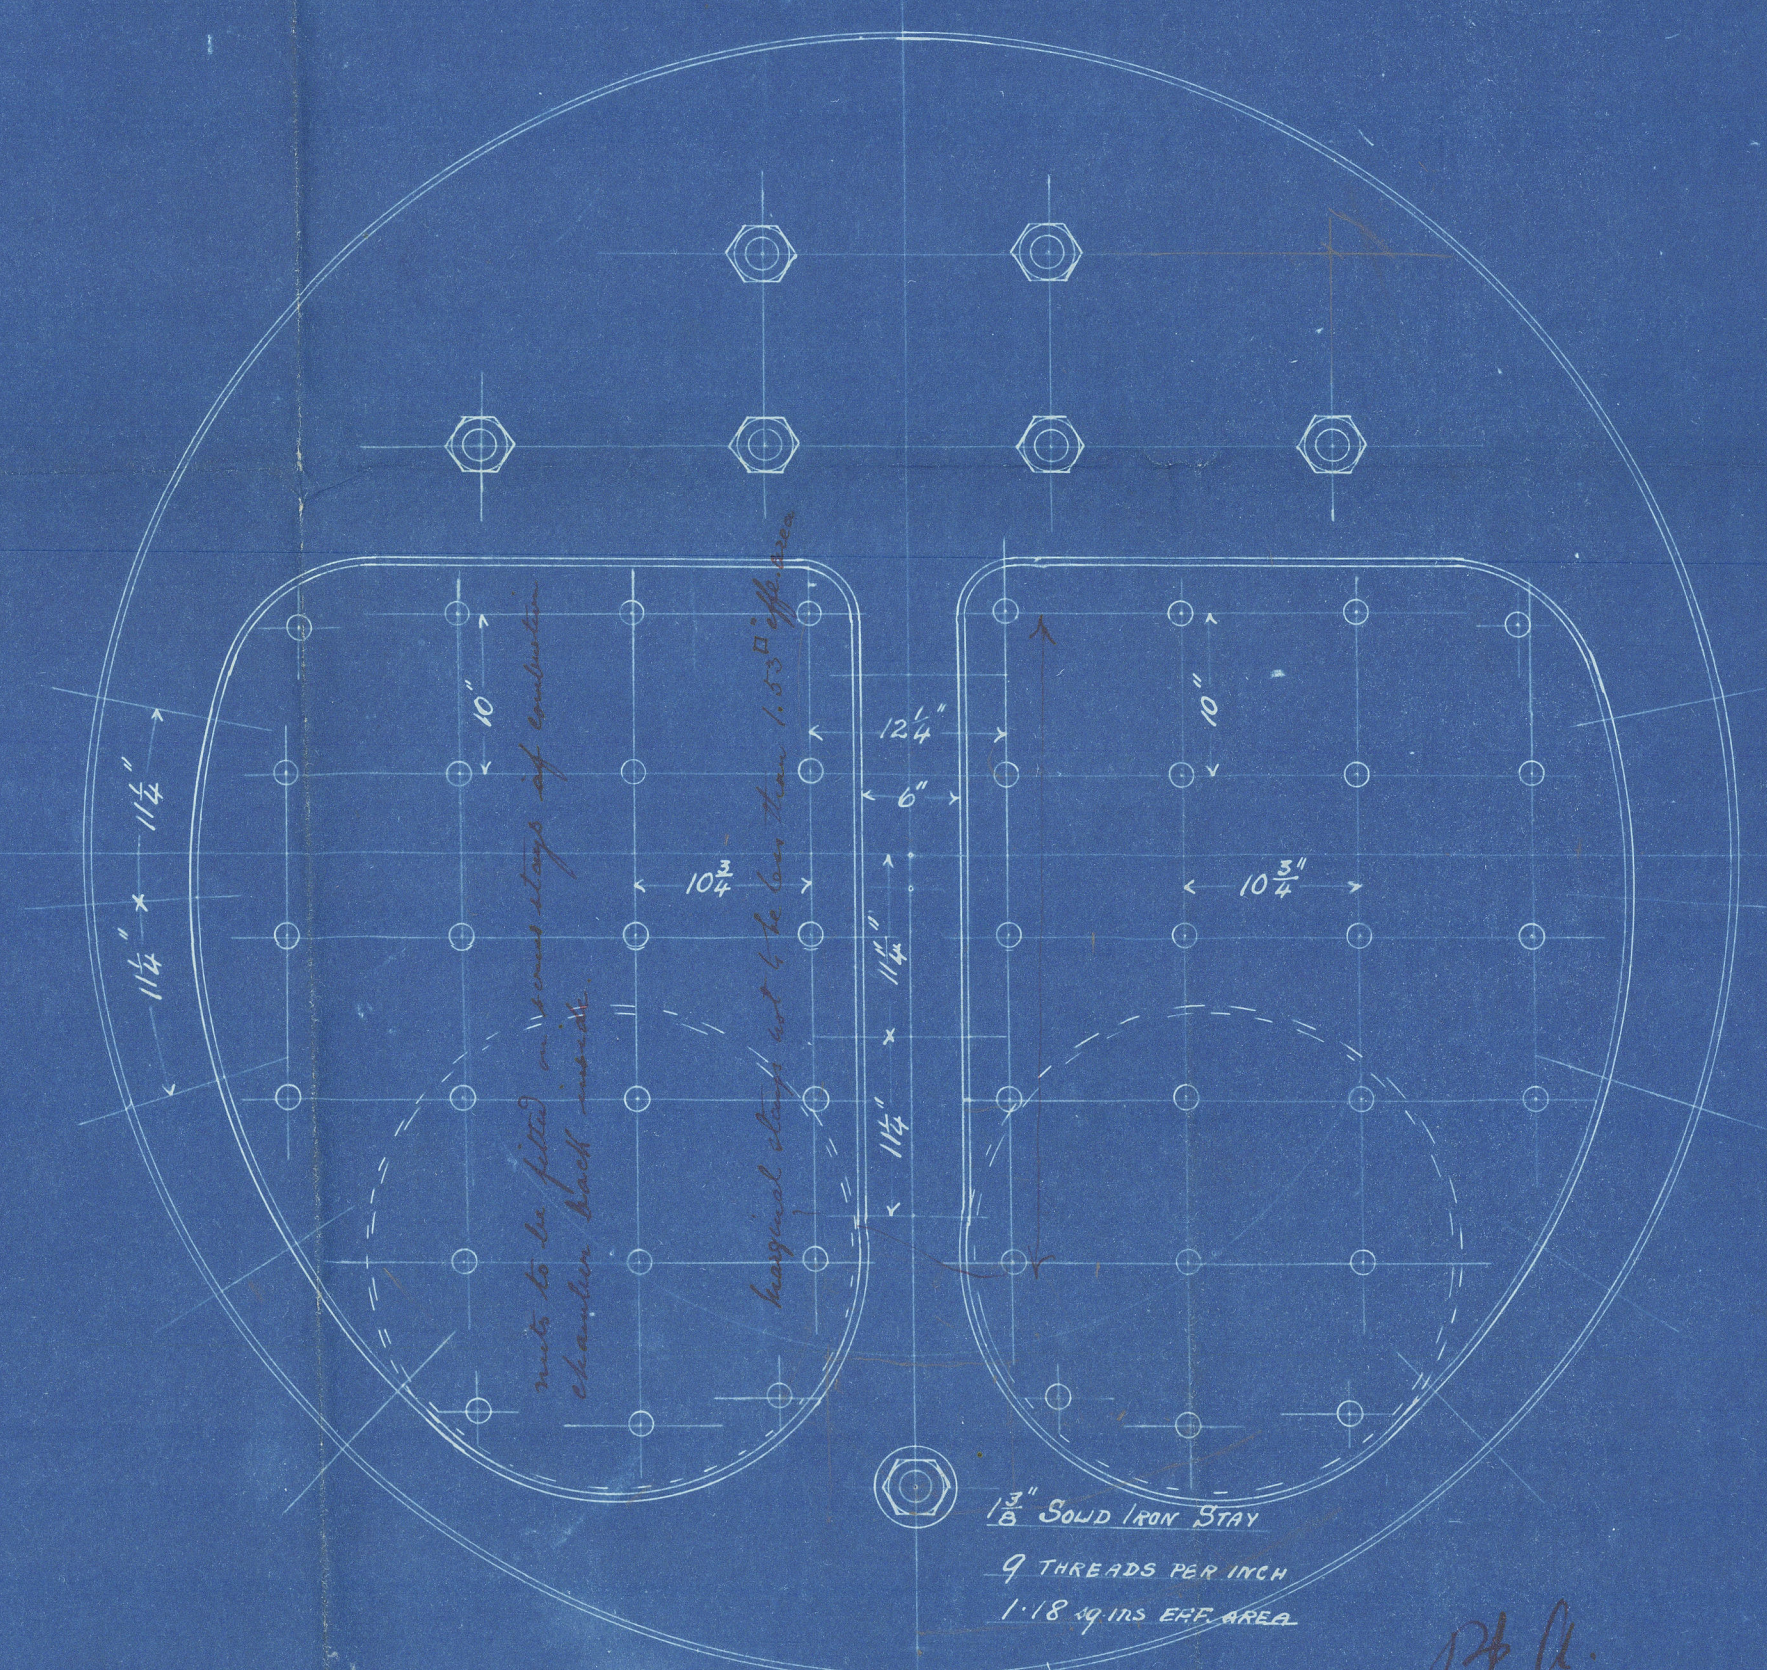

ARRANGEMENT OF STAYS.

1/2" SOLID IRON STAY  
 9 THREADS PER INCH  
 1.18 SQ. INS. EFF. AREA

J.B.A.  
 8.11.01




Plan donkey bailer  
No. 483 by Hutson  
& Sons

ss. ~~Barone Edmonds Vay~~  
~~Londonderry~~ 1891 5-1



~~Glasgow report No 20085~~

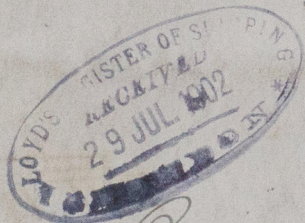

Barone Edmonds Vay

Del 5458



© 2020

Lloyd's Register  
Foundation