

avoid numbers
 27.9.12
 waiters (Gardiner)

27.9.12
 2022
 10000
 10000


MIDSHIP SECTION

Nos 552,3,4,5.

STEEL SCREW TRAWLERS
 DIMS 133' 4" BP x 23' 0" E x 13' 0" M^{LD}

SCALE 1/2" = 1 FOOT.

TO CLASS 100 A1 LLOYDS, STEAM TRAWLER.

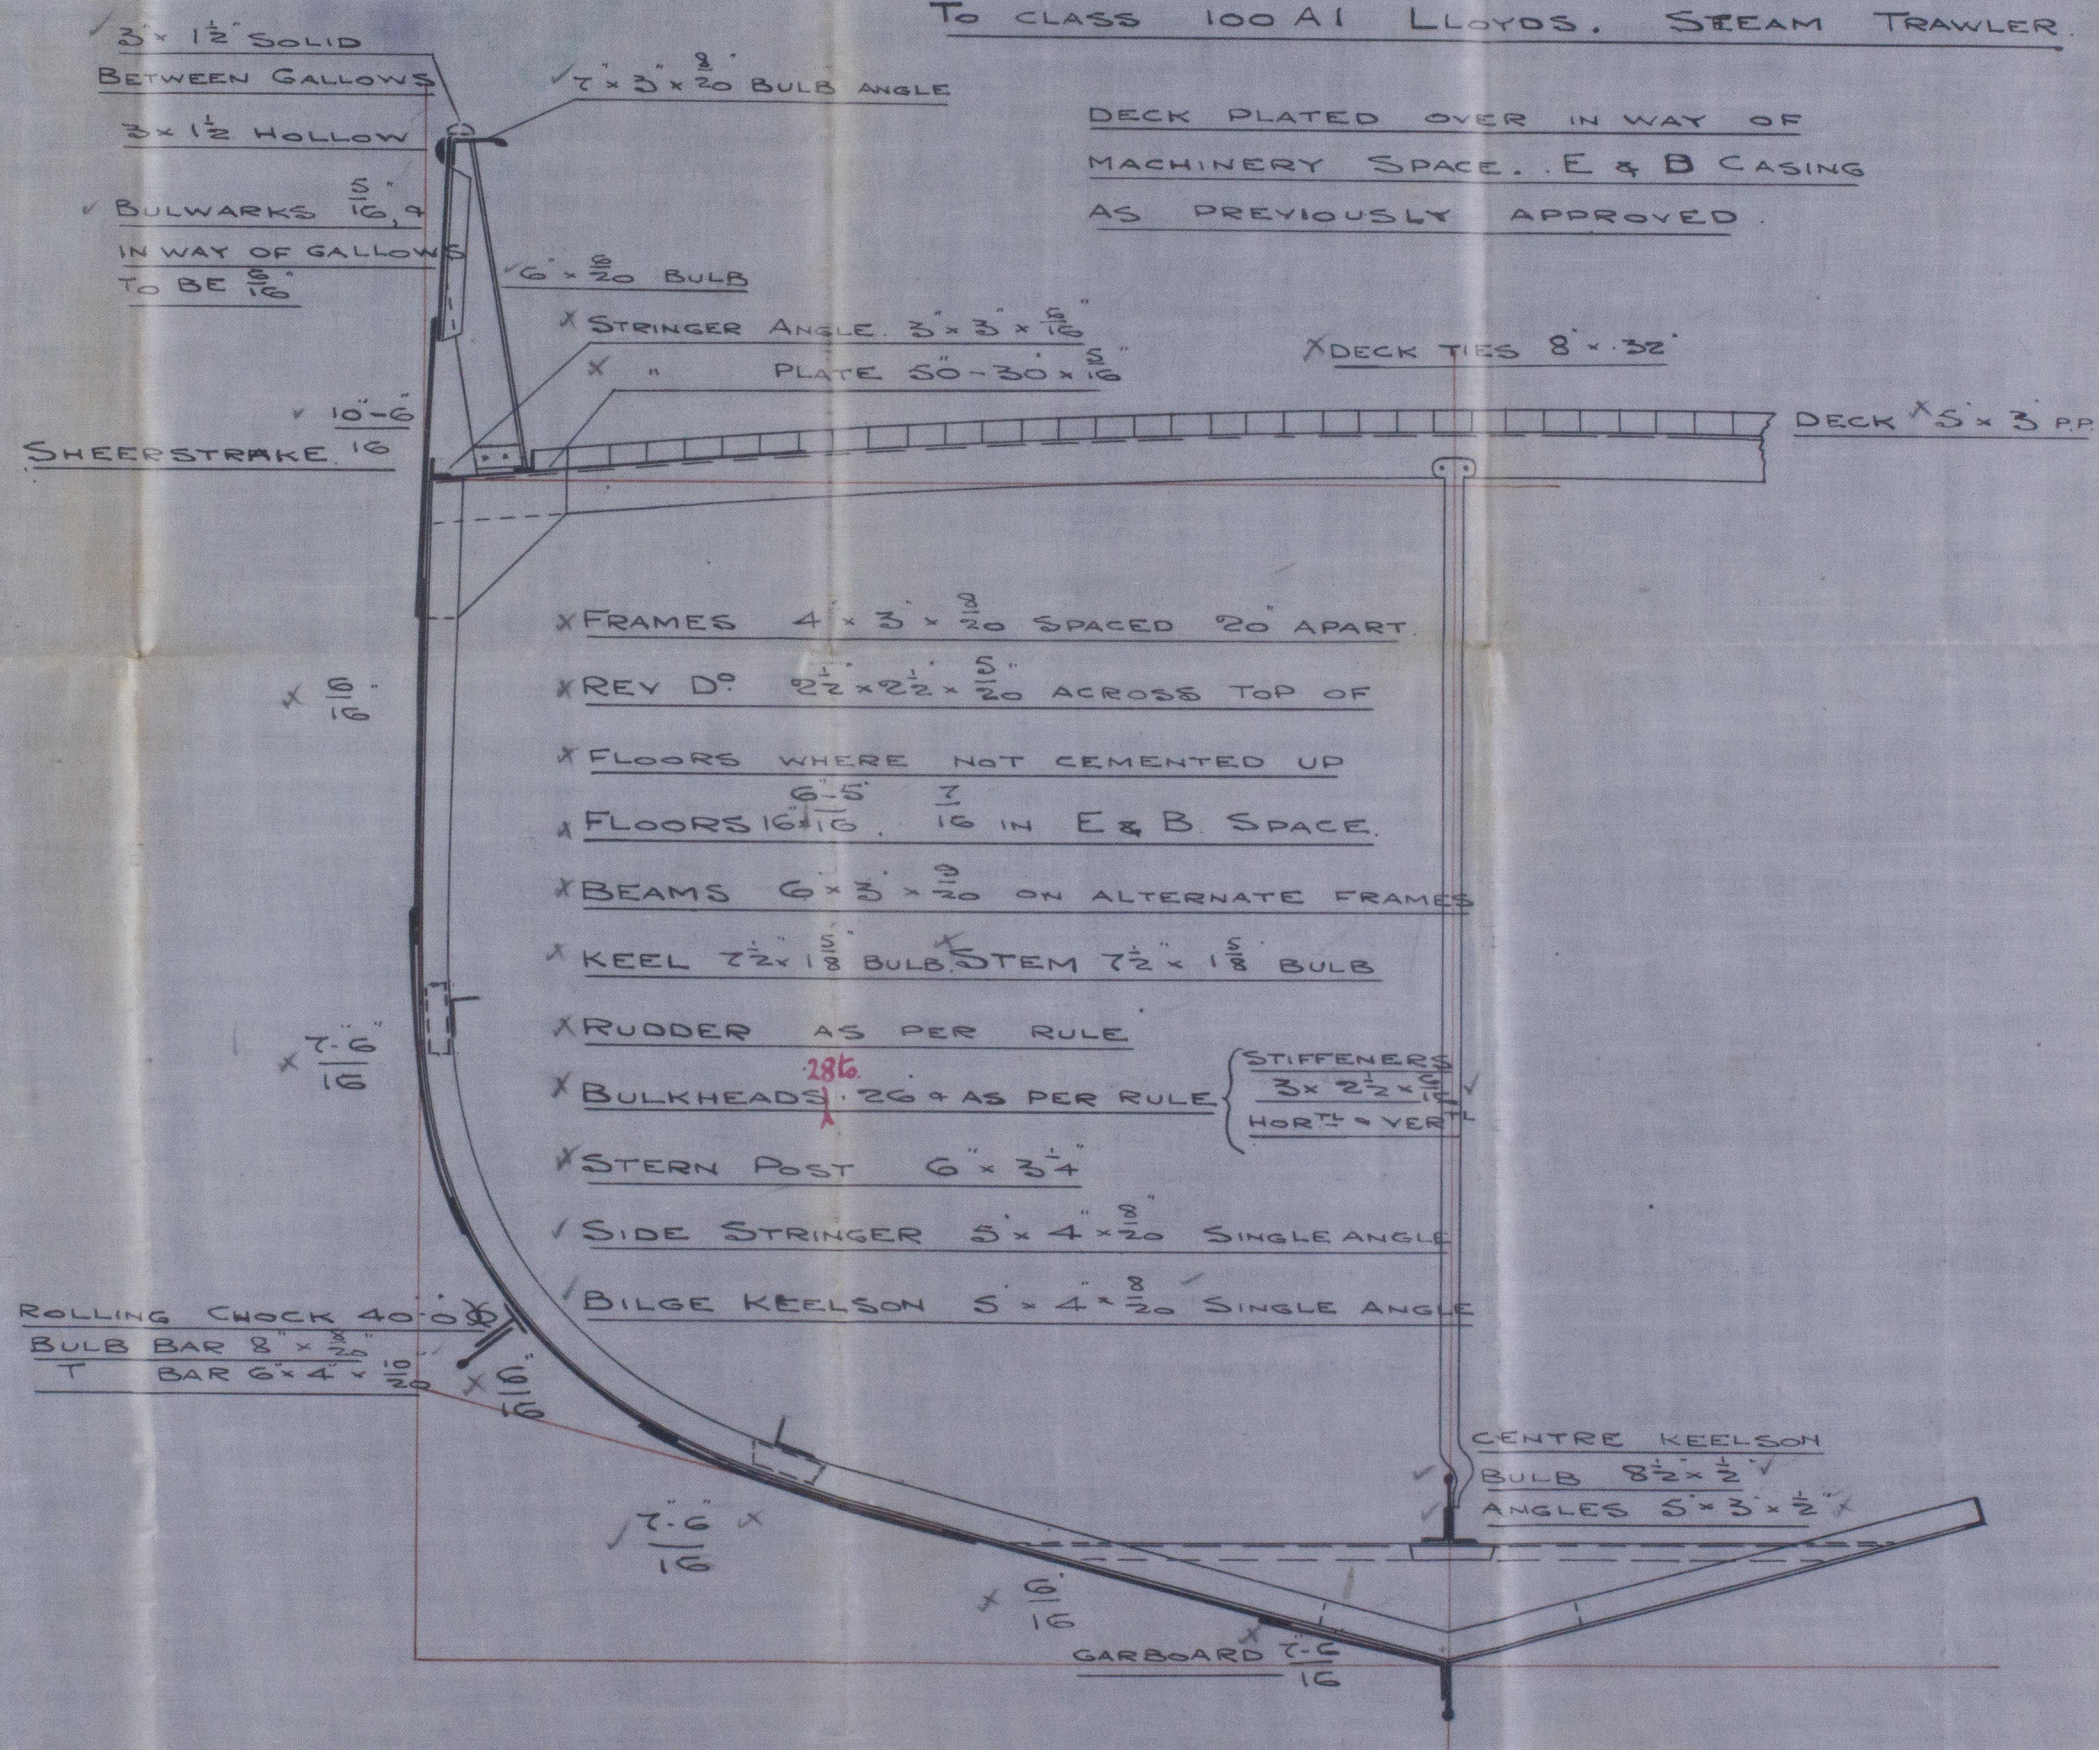

2011
 FOR ENCLOSURE TO
 Messrs Lloyd's Surveyors
 Hull FROM
 COCHRANE & SONS.
 SHIPBUILDERS, SELBY
 DATE 25/9/12. RK

NUMERALS.

B + D = 35.87 ✓
 L x (B + D) = 4782.54 ✓

PROPORTIONS

L / D = 10.25 ✓
 L / B = 5.82

EQUIPMENT.

1 ST BOWER ANCHOR	6 CWT ⁵ EX STOCK ✓
2 ND " "	5 1/2 " " " ✓
KEDGE	3 " " " ✓
120 FATHOMS	2" 116" CABLE ✓
60 " "	6" HAWSER ✓
60 " "	5" WARP ✓

RIVETING.

✓ ALL LANDINGS TO BE DOUBLE
 ✓ RIVETED. BUTTS TO BE LAPPED
 ✓ & DOUBLE RIVETED EXCEPT
 ✓ GARBOARD & SHEER STRAKE WHICH
 ✓ ARE TO BE STRAPPED & DOUBLE
 ✓ RIVETED.

27.9.12

Cochran & Sons.

N^o 552.3.4. and 5.

Midship Section

27 FEB. 1919

LONDON

$\frac{1}{2}$ Diamond Hull Rpt No: 25908

" Sapphire " " 25969

" Pearl " " 26060

" Emerald " " 266*50

© 2020

Lloyd's Register
Foundation