



8/11/27

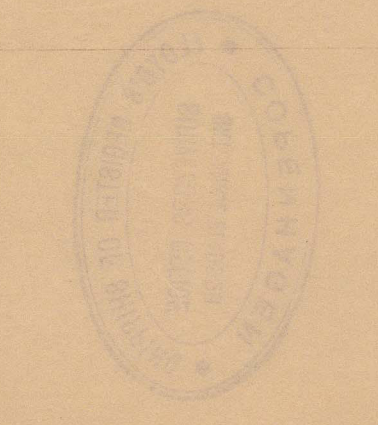


LLOYD'S NUMERALS
L 1575 305 x 15 105 5795 5642
L 1575 305 x 15 105 5795 5642

PROFILE + DECK PLANS
DIMENSIONS: LENGTH 130' 0" BREADTH 15' 0" DEPTH 10' 0"
THE "BRACKETLESS SYSTEM" (PATENT)
SCALE 1/8" = 1 FOOT
WHICHES WINDLASS STEERING GEAR + MASTS SUBMITTED TO SURVEYORS SATISFACTION

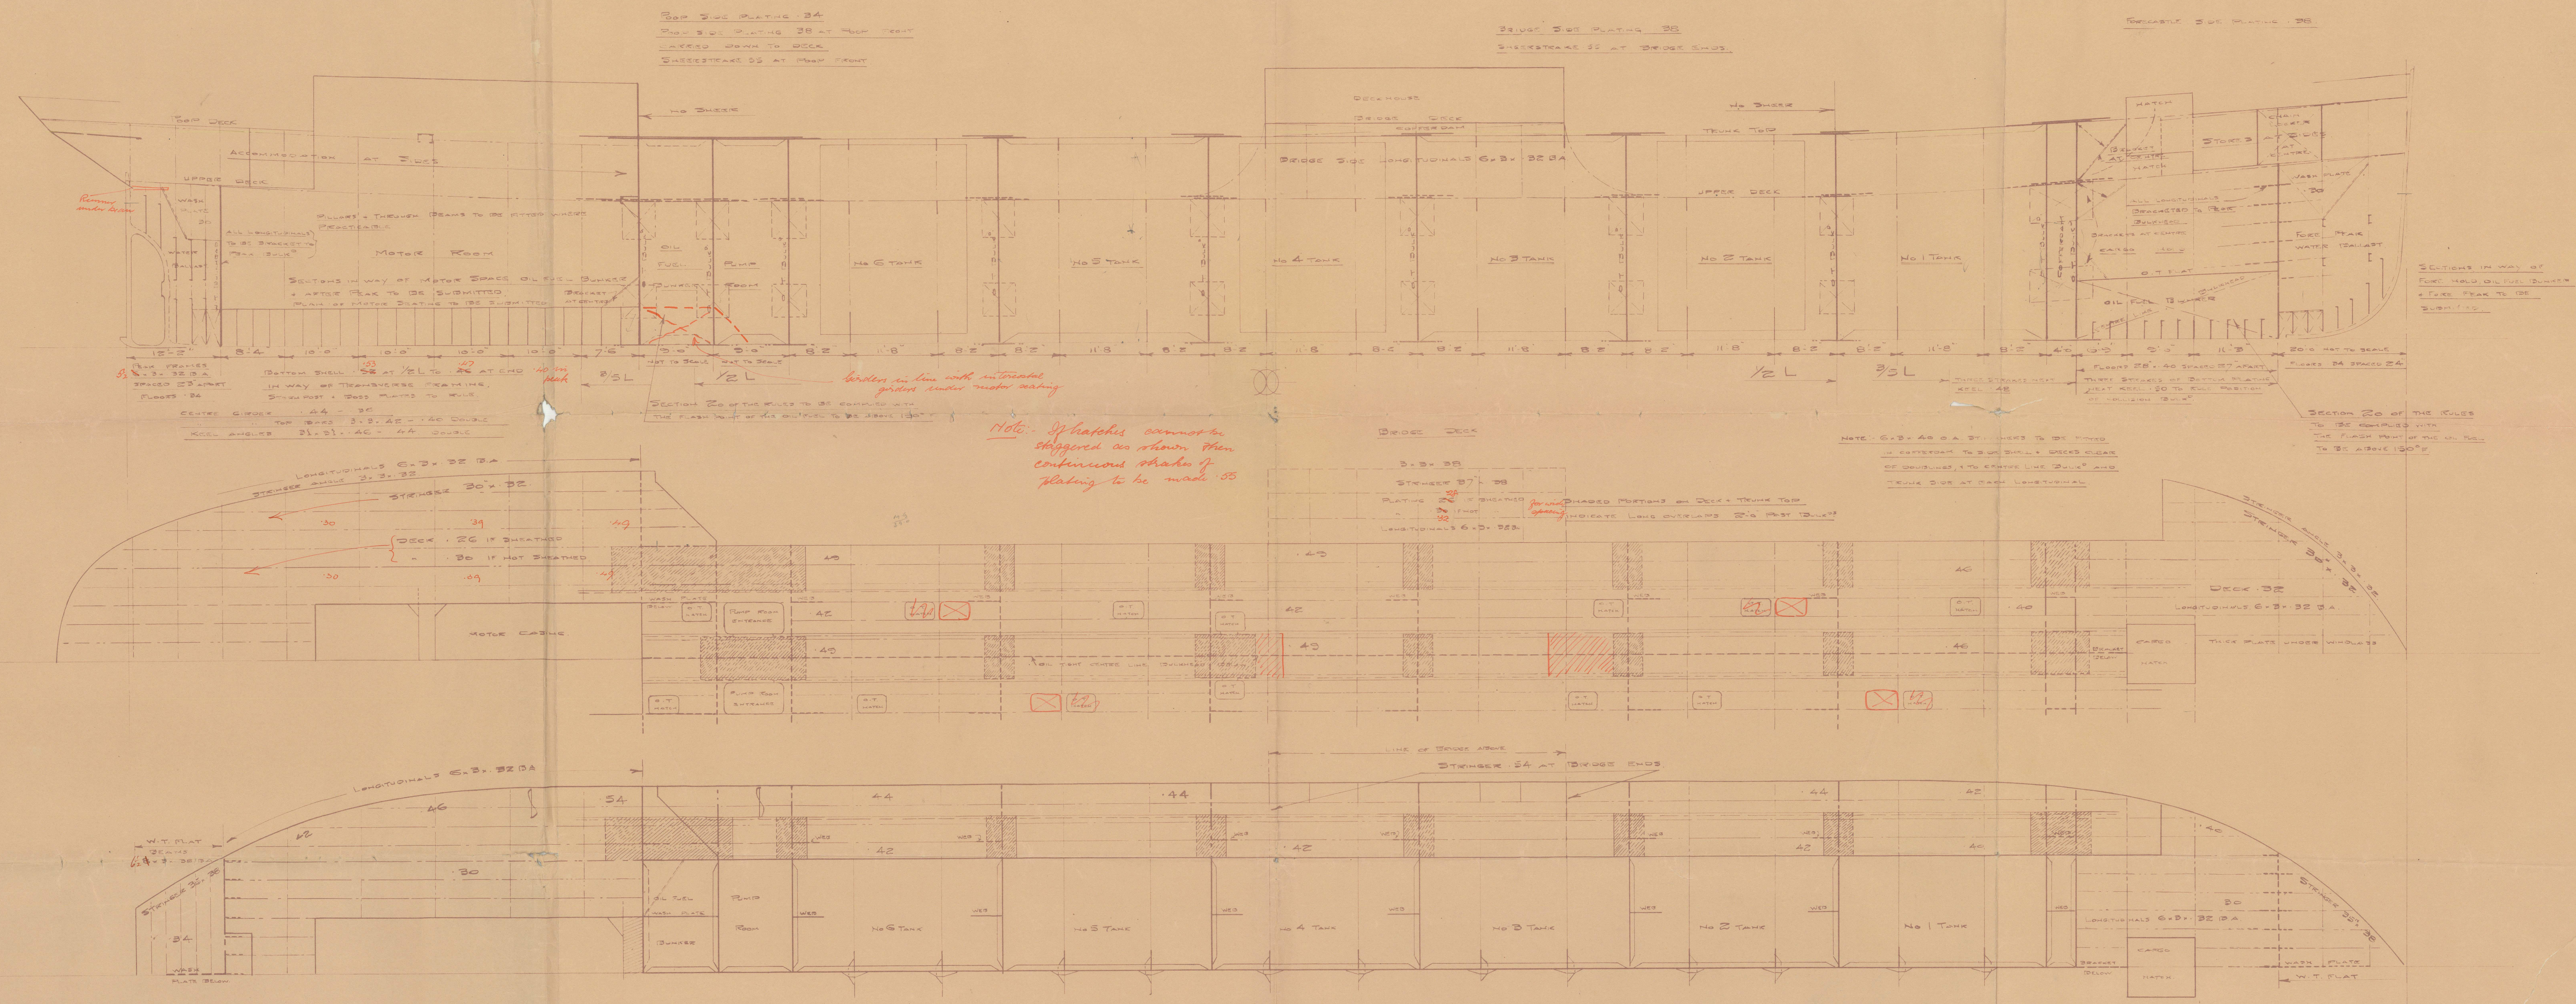

AALBORG SKIBSVAERKT, AKT.
AALBORG, DENMARK
SHEPWOOD N° 1575 PLAN N° 5342
1-11-27

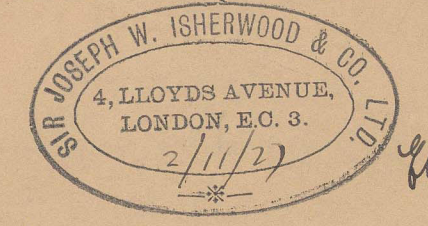

8.11.27

2010-FM


PROFILE & DECKS.

No 37



MESSRS AALBORG SKIBSBYGGERI.

M/s. Borguy.
Cpn. Rpt. No. 7931.

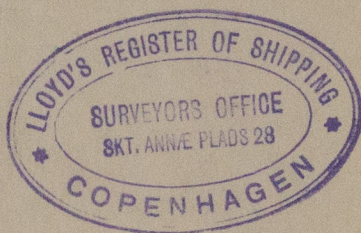

© 2021

Lloyd's Register
Foundation

See latest set of
approval plans
dated 25/1/24

W7-0102



© 2021

Lloyd's Register
Foundation