



Propeller shaft

Intermediate shaft


for  
The vessel yard No. 37.

being built by Messrs.

A/S Aalborg Maskin-og Skibs-  
byggeri, Aalborg.

M/s BORGNY of Oslo.

Cpu. Rpt. No. 7931.

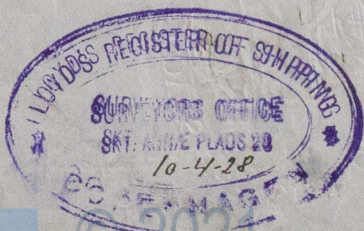

Lloyd's Register  
Foundation

W7-0105