

CRANK SHAFT FOR YARD N°

G-CYLINDER FOUR CYCLE DIESEL-ENGINE


CYL-DIAM. 500 ^M/_M STROKE 1250 ^M/_M

AKTIESELSKABET
BURMEISTER & WAIN MASKIN- OG SKIBSBYGGERI

D. 16-1-2

J. Lohm

© 202

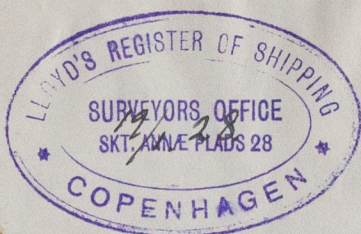

Plan of
CRANK AND THRUST SHAFTS
for the Main Diesel Oil Engine
to be constructed by
AKTIESELSKABET
BURMEISTER & WAIN MASKIN- OG SKIBSBYGBERI
Copenhagen
for the Screw Motor Tank Vessel
Yard No 37
being built by
~~Aalborg~~ Maskin- & Skibsbyggeri.
Aalborg.

M/S "BORONY" of Osl.

Cpr. Rpt. No 7931.



© 2021

Lloyd's Register
Foundation

W7-0107