


# DETAILS OF AIR BOTTLE

ME-88

PRESSURE = 200 lbs

per sq. in.

per sq. in.

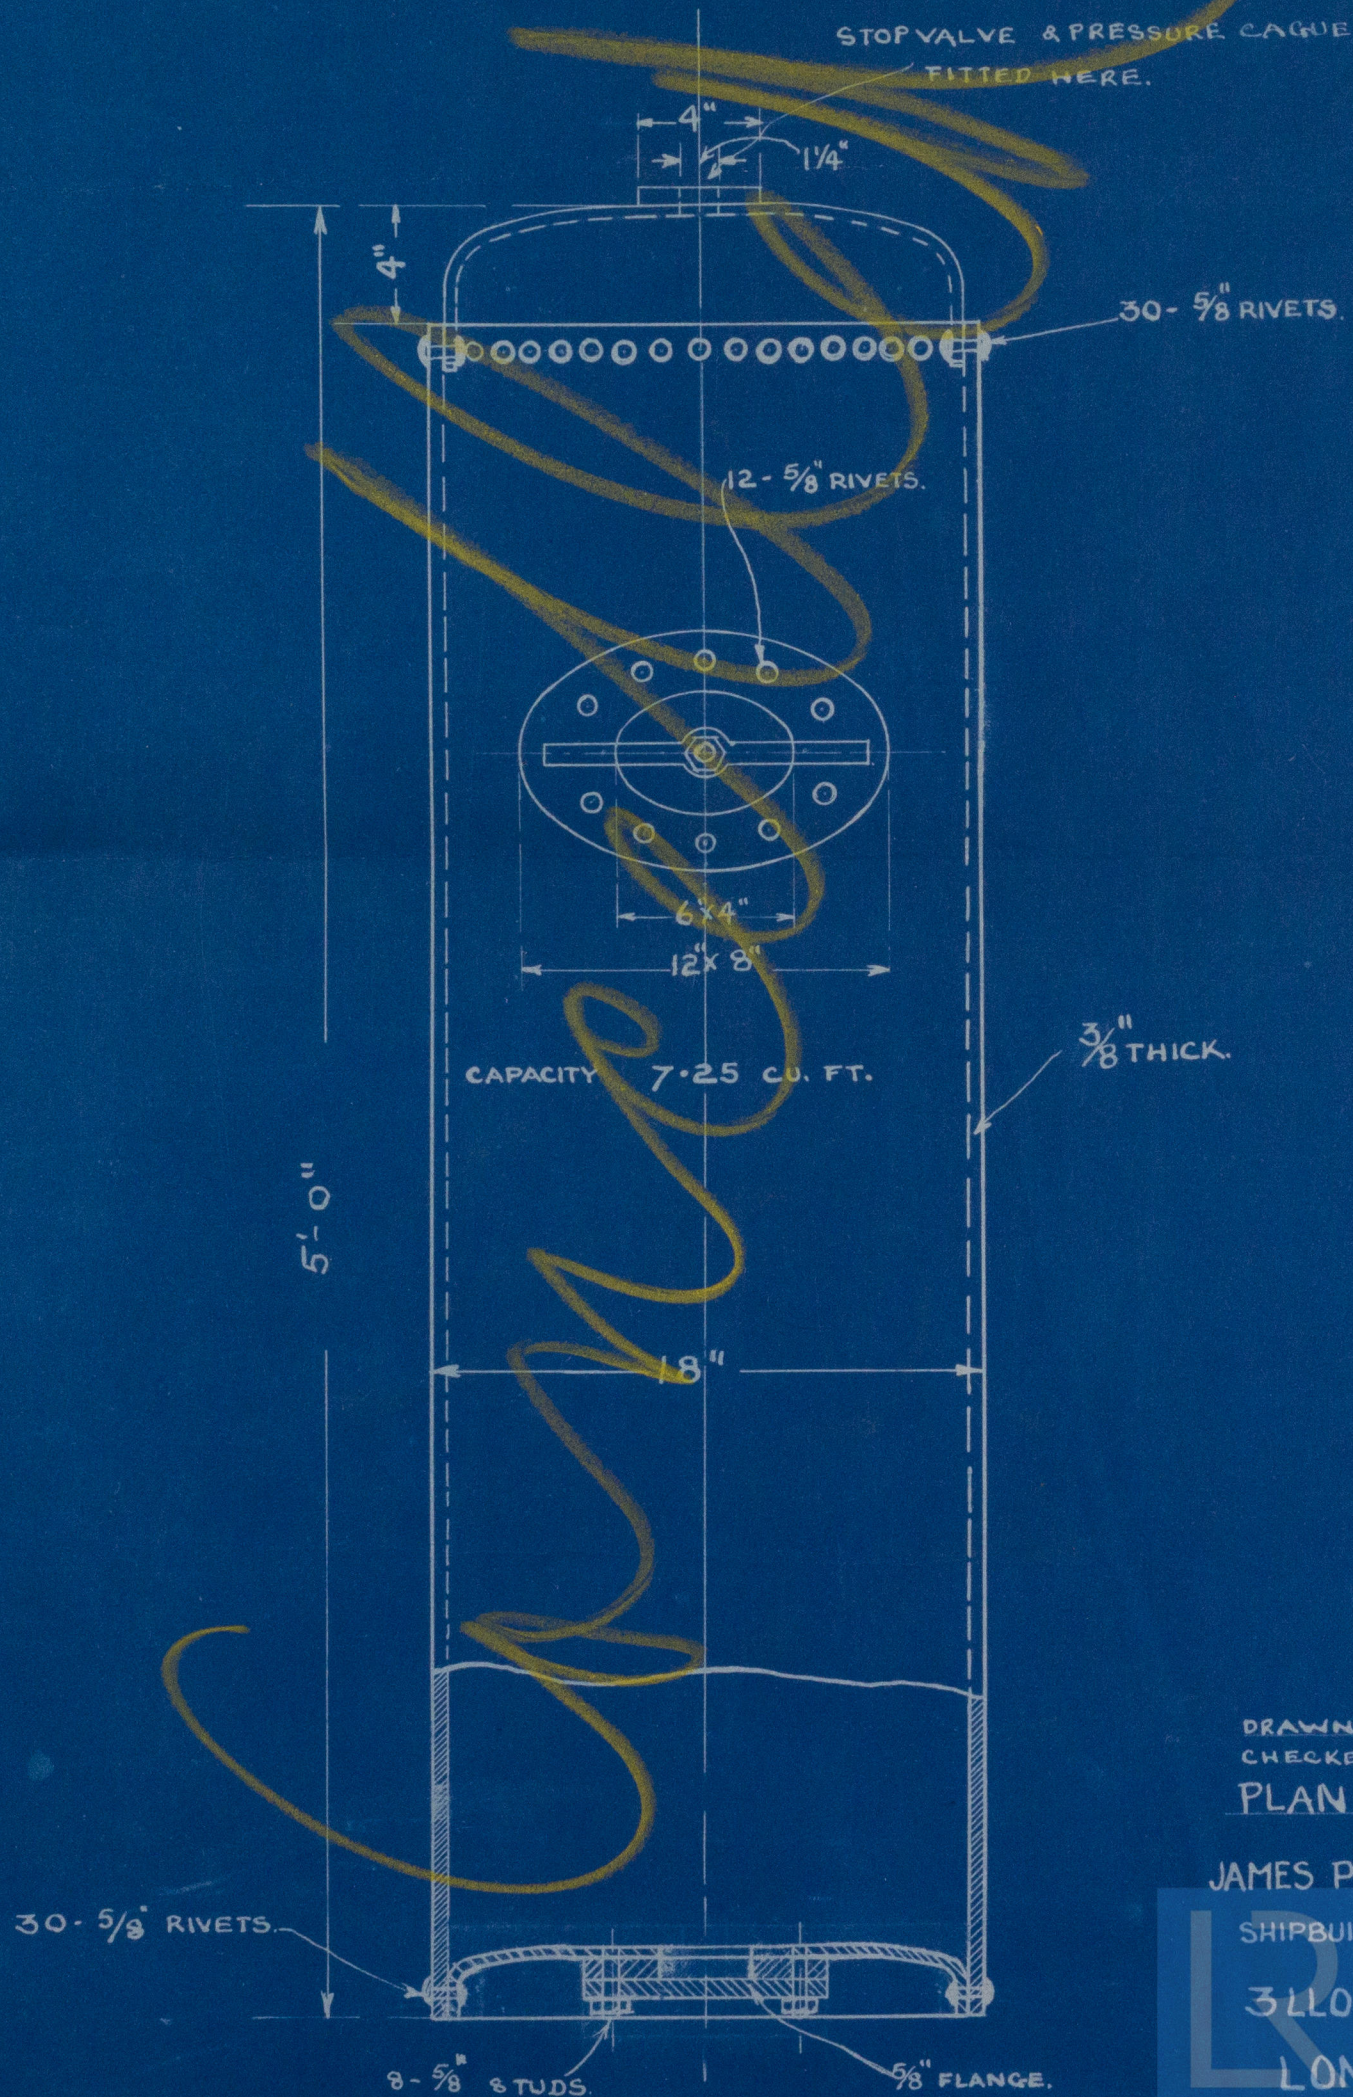

DRAWN BY JREW  
CHECKED BY  
PLAN No 19489

JAMES POLLOCK SONS & Co. LTD.  
SHIPBUILDERS & ENGINEERS.  
3 LLOYDS AVENUE  
LONDON E.C.3.

8110-018