


2 Shrouds made of 3" wire 4 legs  
 Jib Stay " " 3" " Double  
 Fore " " 3 1/2" " "  
~~Stay~~ " " ~~3 1/2~~ " " Single  
 Flying Jib " " 2 3/4" " "  
 Jib Up Sail " " 2 3/4" " "  
 Back " " 2 3/4" " "  
 Topmast Rigging " " 2 3/4" " "  
 Boom Lifts " " 2 1/4" " "  
 Jib Boom Guide " " 3 " "

All Chain Plates 1" x 3" - 8 ft.  
 With Bottom Roll 1 1/2" other two 1"  
 All Turn Buckle 1 1/2"

is 1 Bolt 1 1/2" and  
 2 " 1" in each chain  
 plate

Surveyed and  
 APPROVED  
 MARINE REGISTER OF NEW YORK  
 April 2nd 1911  
 J. Chisholm

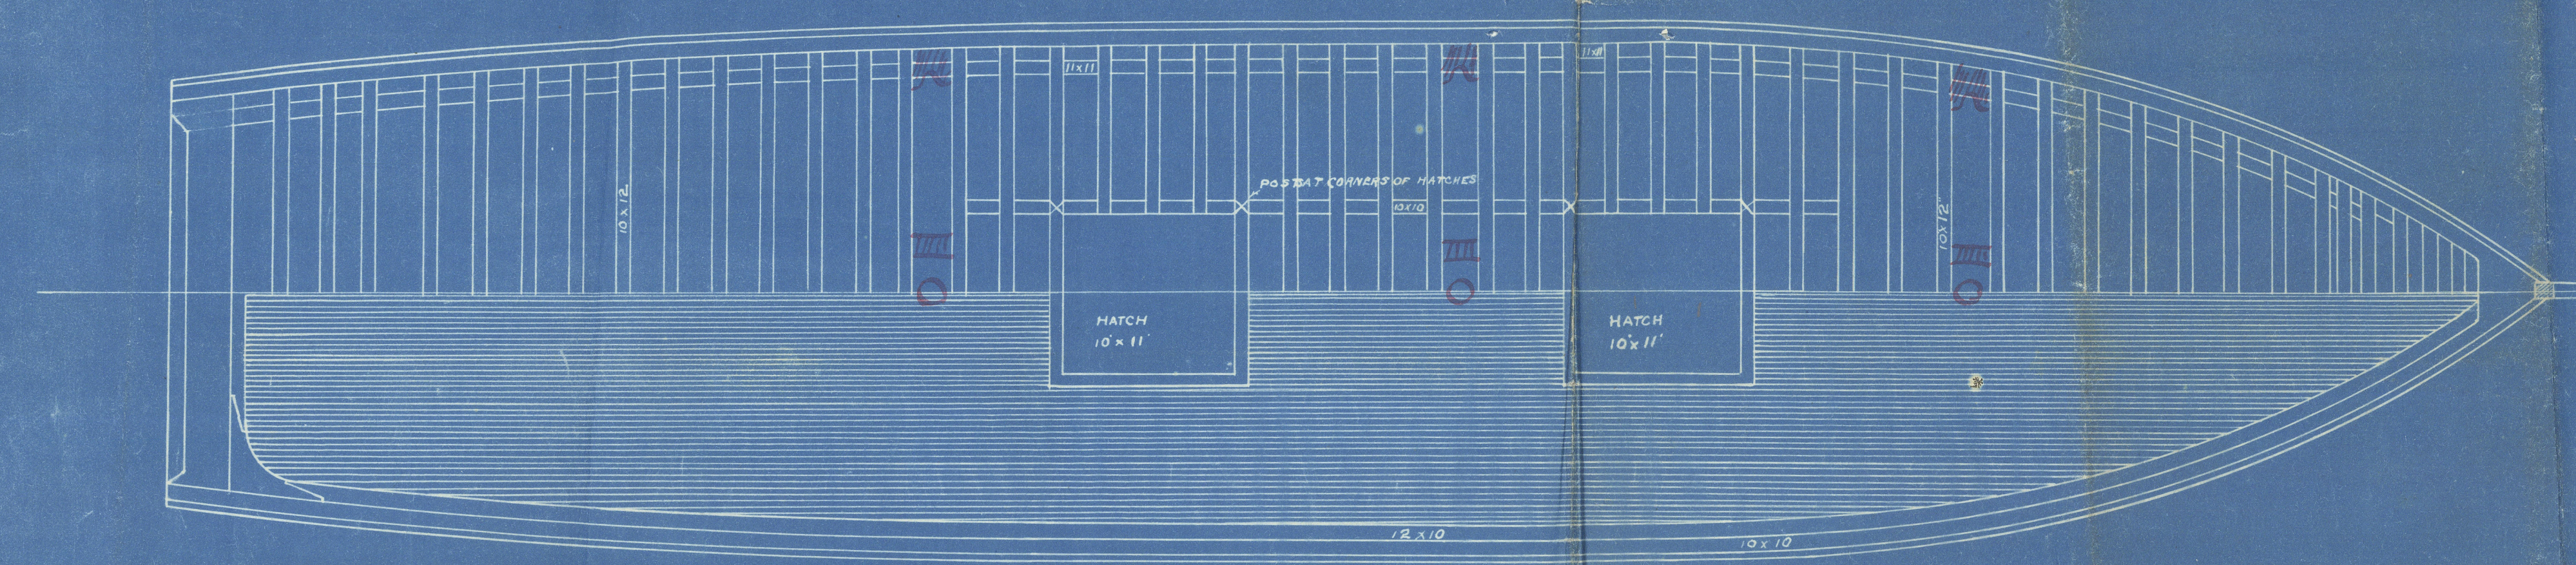



FOR OTHER SCANTLINGS SEE LLOYD'S APP. SECTION  
 SCALE 1/8 INCH TO ONE FOOT





W700-0026

RETAIR

*Lugo*


RETAIR



© 2020

Lloyd's Register  
Foundation



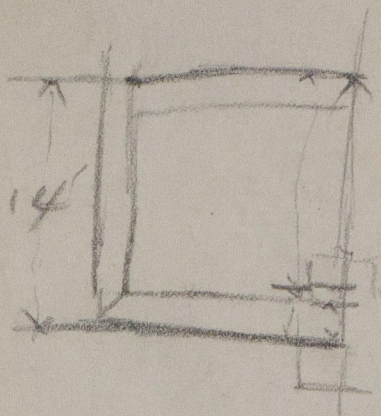

© 2020

Lloyd's Register  
Foundation