

Scale 1/2 inch
 Moulded Depth 14'
 Moulded Beam 33' 2"
 Length OA 143'
 Length Keel 120'

Equipment as per Rules

Not less than 2/3 of members are to be
 drilled thro' the inside flanges, clamps, etc.

(See sketch)

Detail of Hatch to be submitted
 Detail of Hatches to be submitted

10X12 spaced 36"

All ceiling edges bolted
 from keelson

Material of Star Lead yellow pine
 Material of Long Lead yellow pine

10X10 in
 substructure

$130 \times \frac{30.3}{100} \times 14 \times .75 = 420$
 $130 \times \frac{30.3}{100} \times 14 \times .75 = 420$

10X14 spaced 15"

10' sided.

No butt in Centre of floor.
 No butt in Centre of floor.

2 1/2" timber hole

13X13
 13X5

7X12

Surveyor

Pillars at hatches

All ceiling to be edge bolted

From keelson to deck. 12' and 14' and 2' strakes
 of ceiling are to be spaced 30" apart.

J. Chas. Jones

Blair Shreve Building Co

1900-2029 Below by 100' & 100' Can. Bldg.

Midship Section.

Biloxi Bay Oct. 4 S. B. Co.


Eight letters. 14.

Number 6485.

See Copy ltr of Feb 12. 1919.

W700-0029

Luiza

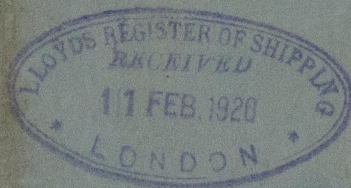

© 2020

Lloyd's Register
Foundation