


10.9.08  
23.12.10 (N629)

Longitudinal Section and Deck plans  
No 594. S.S. 1629  
dimensions 330' x 49' ex. x 48' 9" mld. x 24' 3 1/2" mld.  
To class 100. A.I. at I.Loyds. 3 deck Rule Single dk.  
Scale 1/8" = 1 foot.

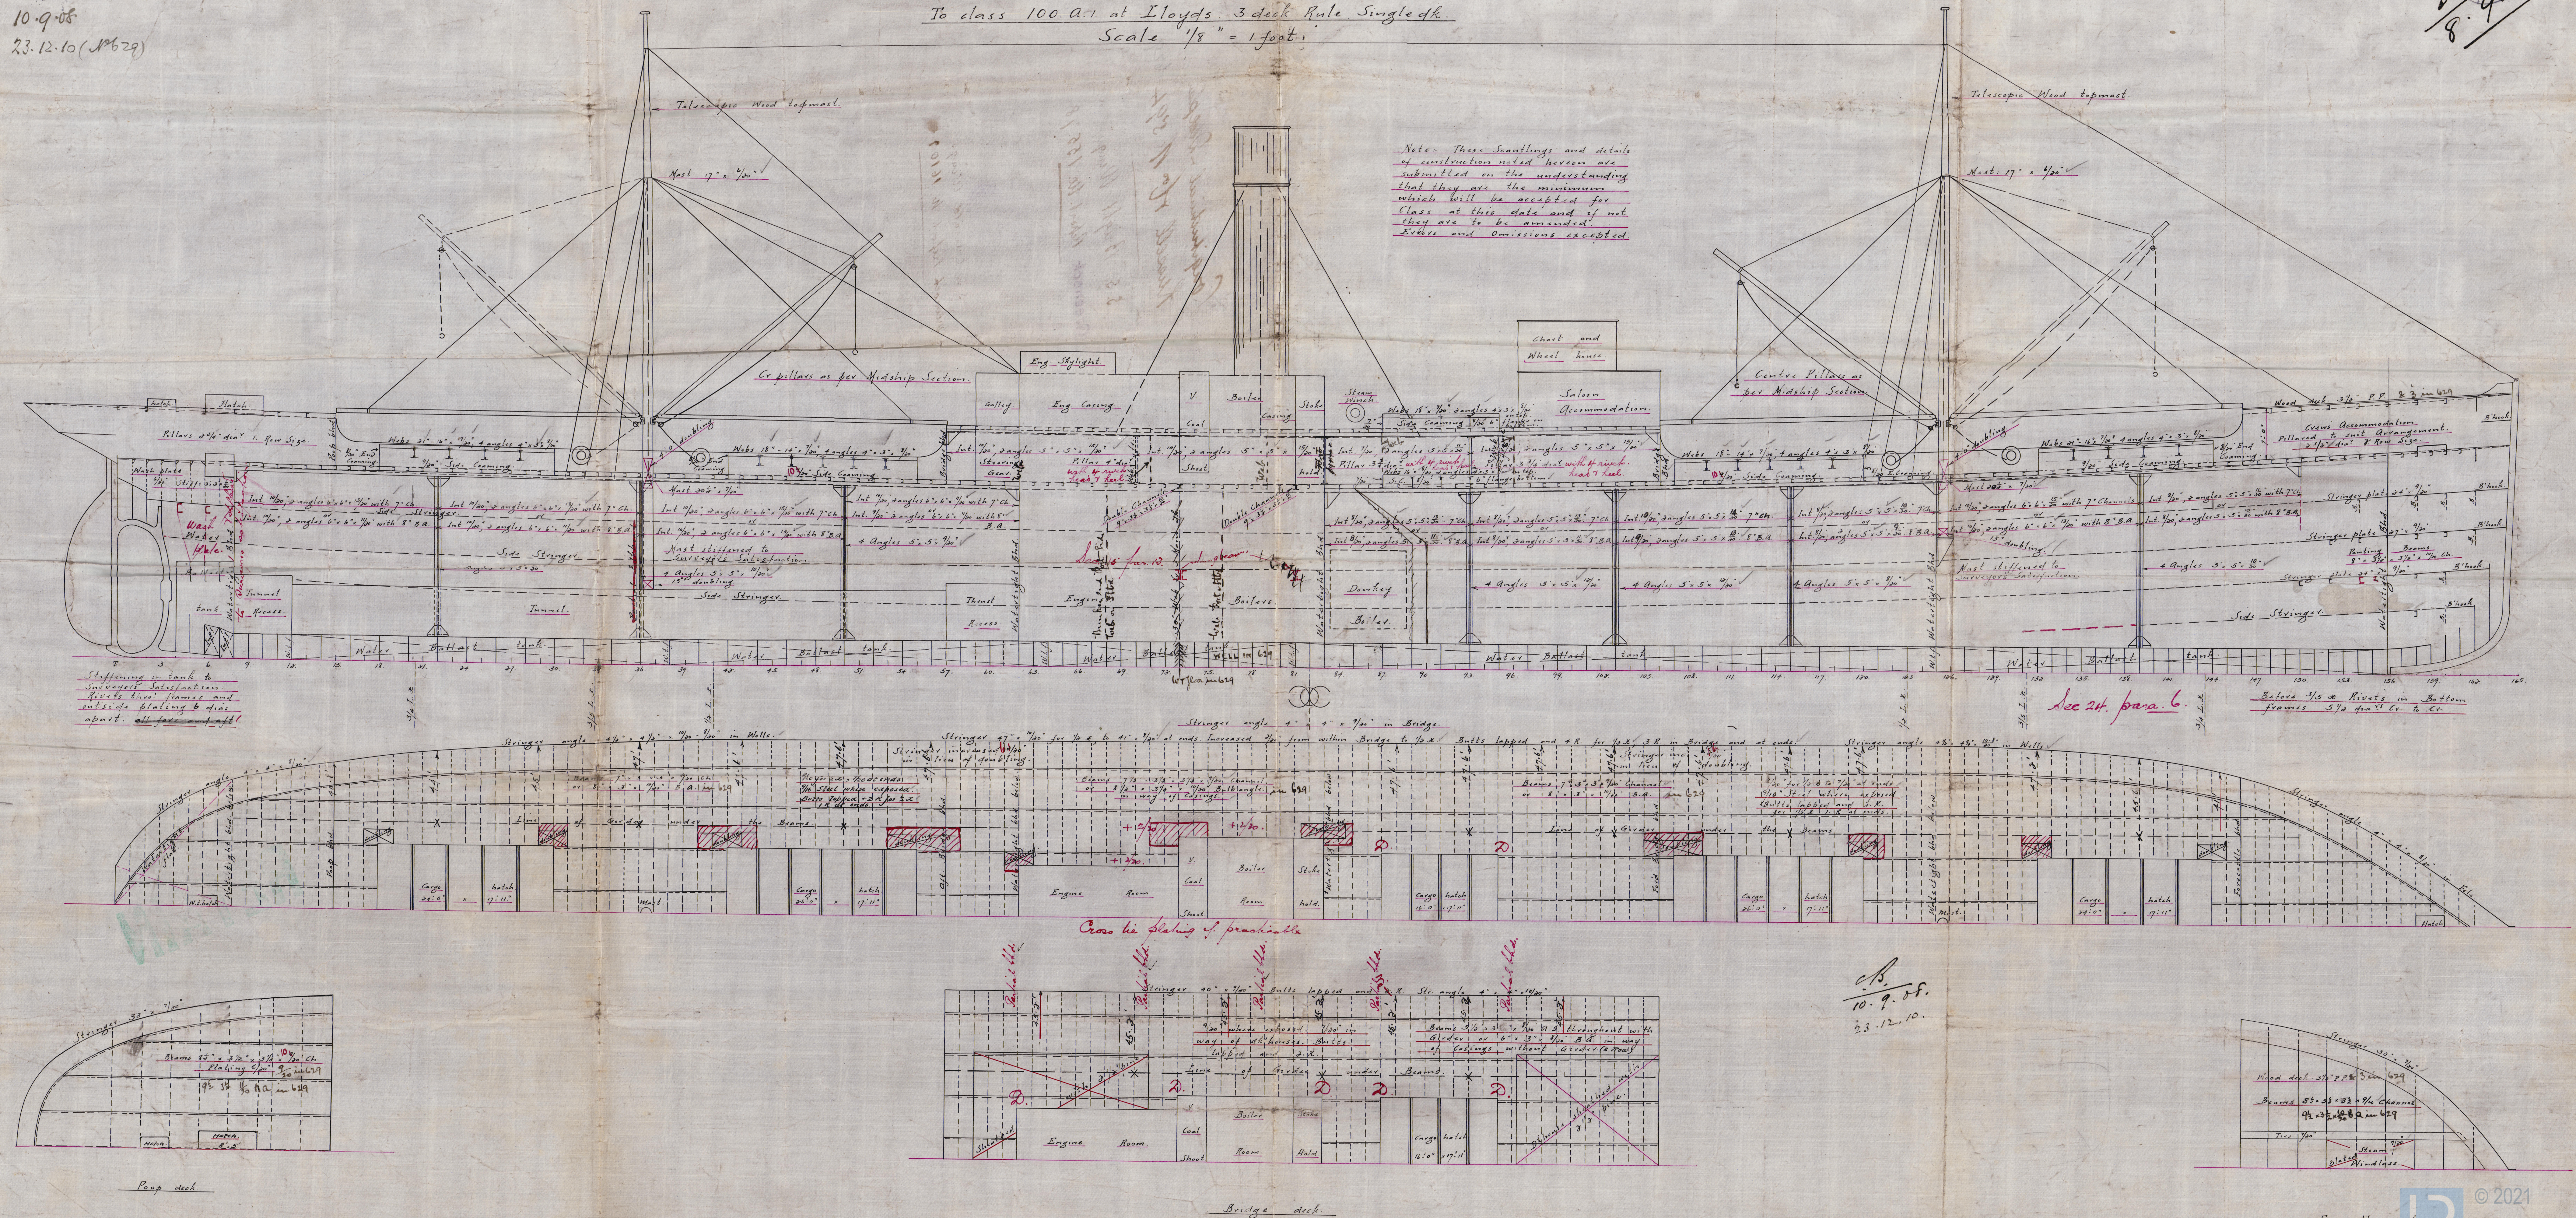

10.9.08  
23.12.10 (N629)



C.B.  
10.9.08  
23.12.10.



Longitudinal & Deck plan  
Russell No 594

S. S. "Bright Wings"

Greenock Report No. 15578

S. S. "Emerald Wings"

Greenock Report No. 16109



© 2021

W402

0010

Lloyd's Register  
Foundation