

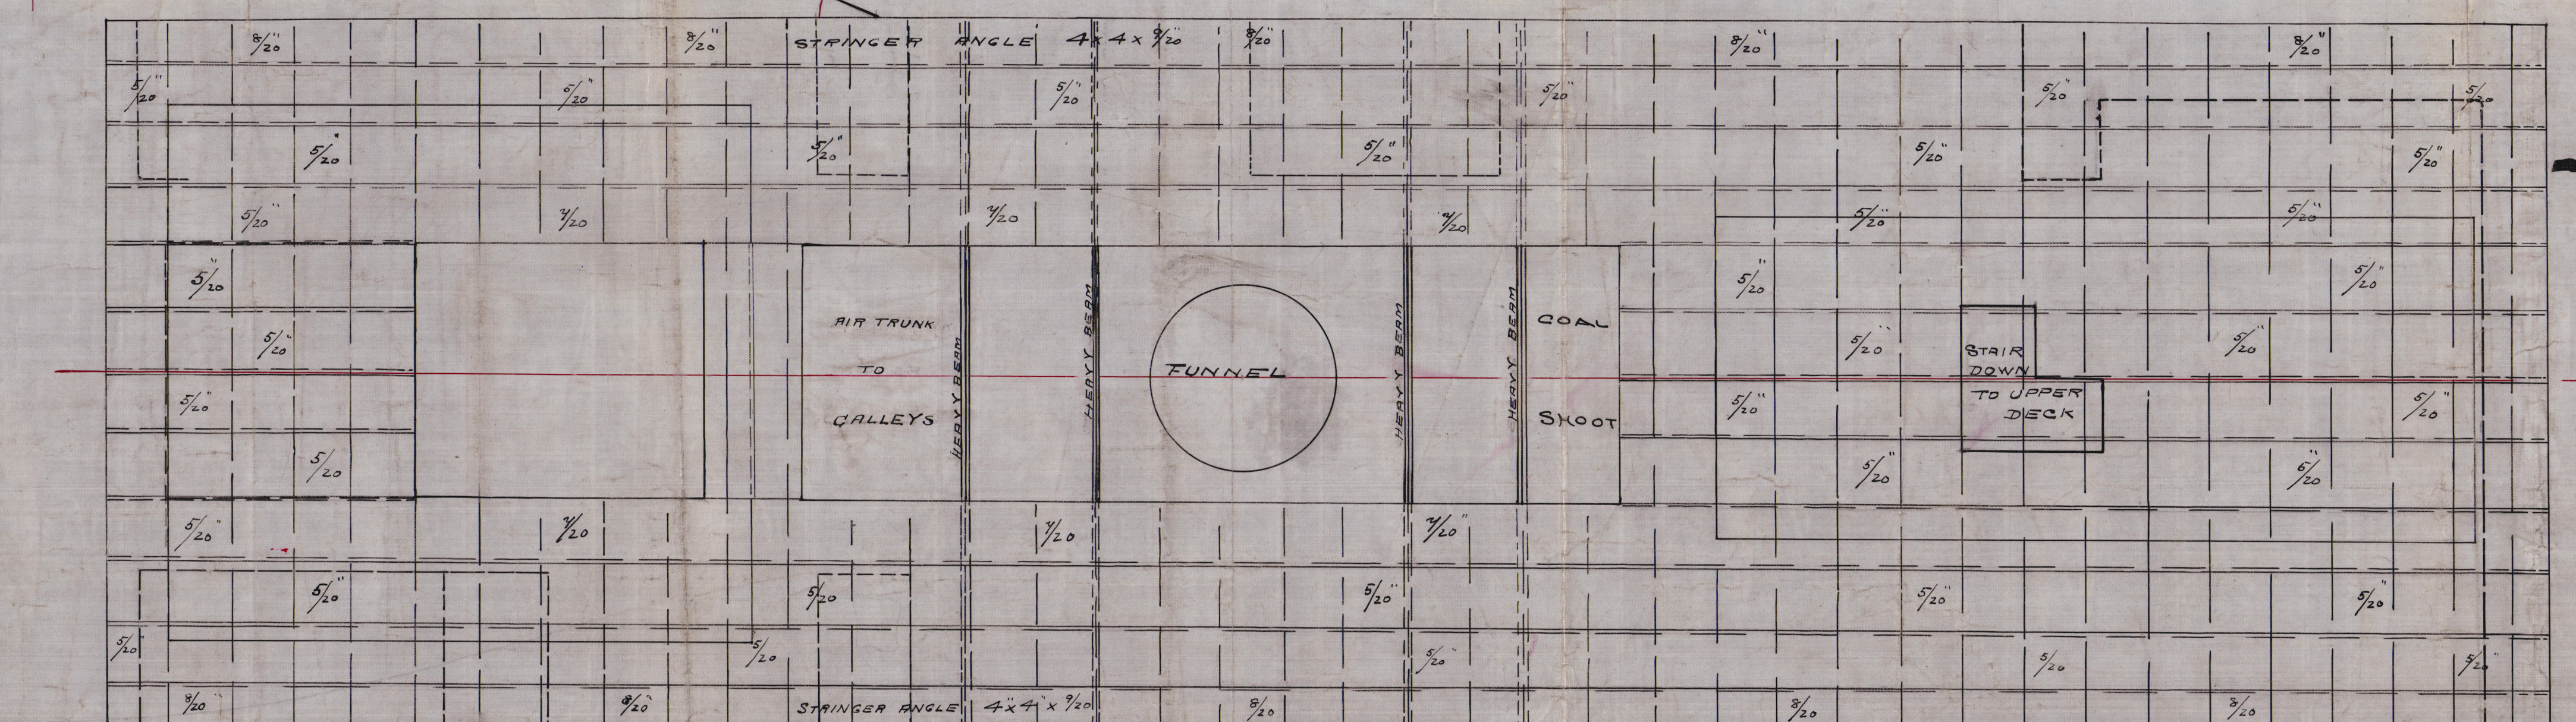
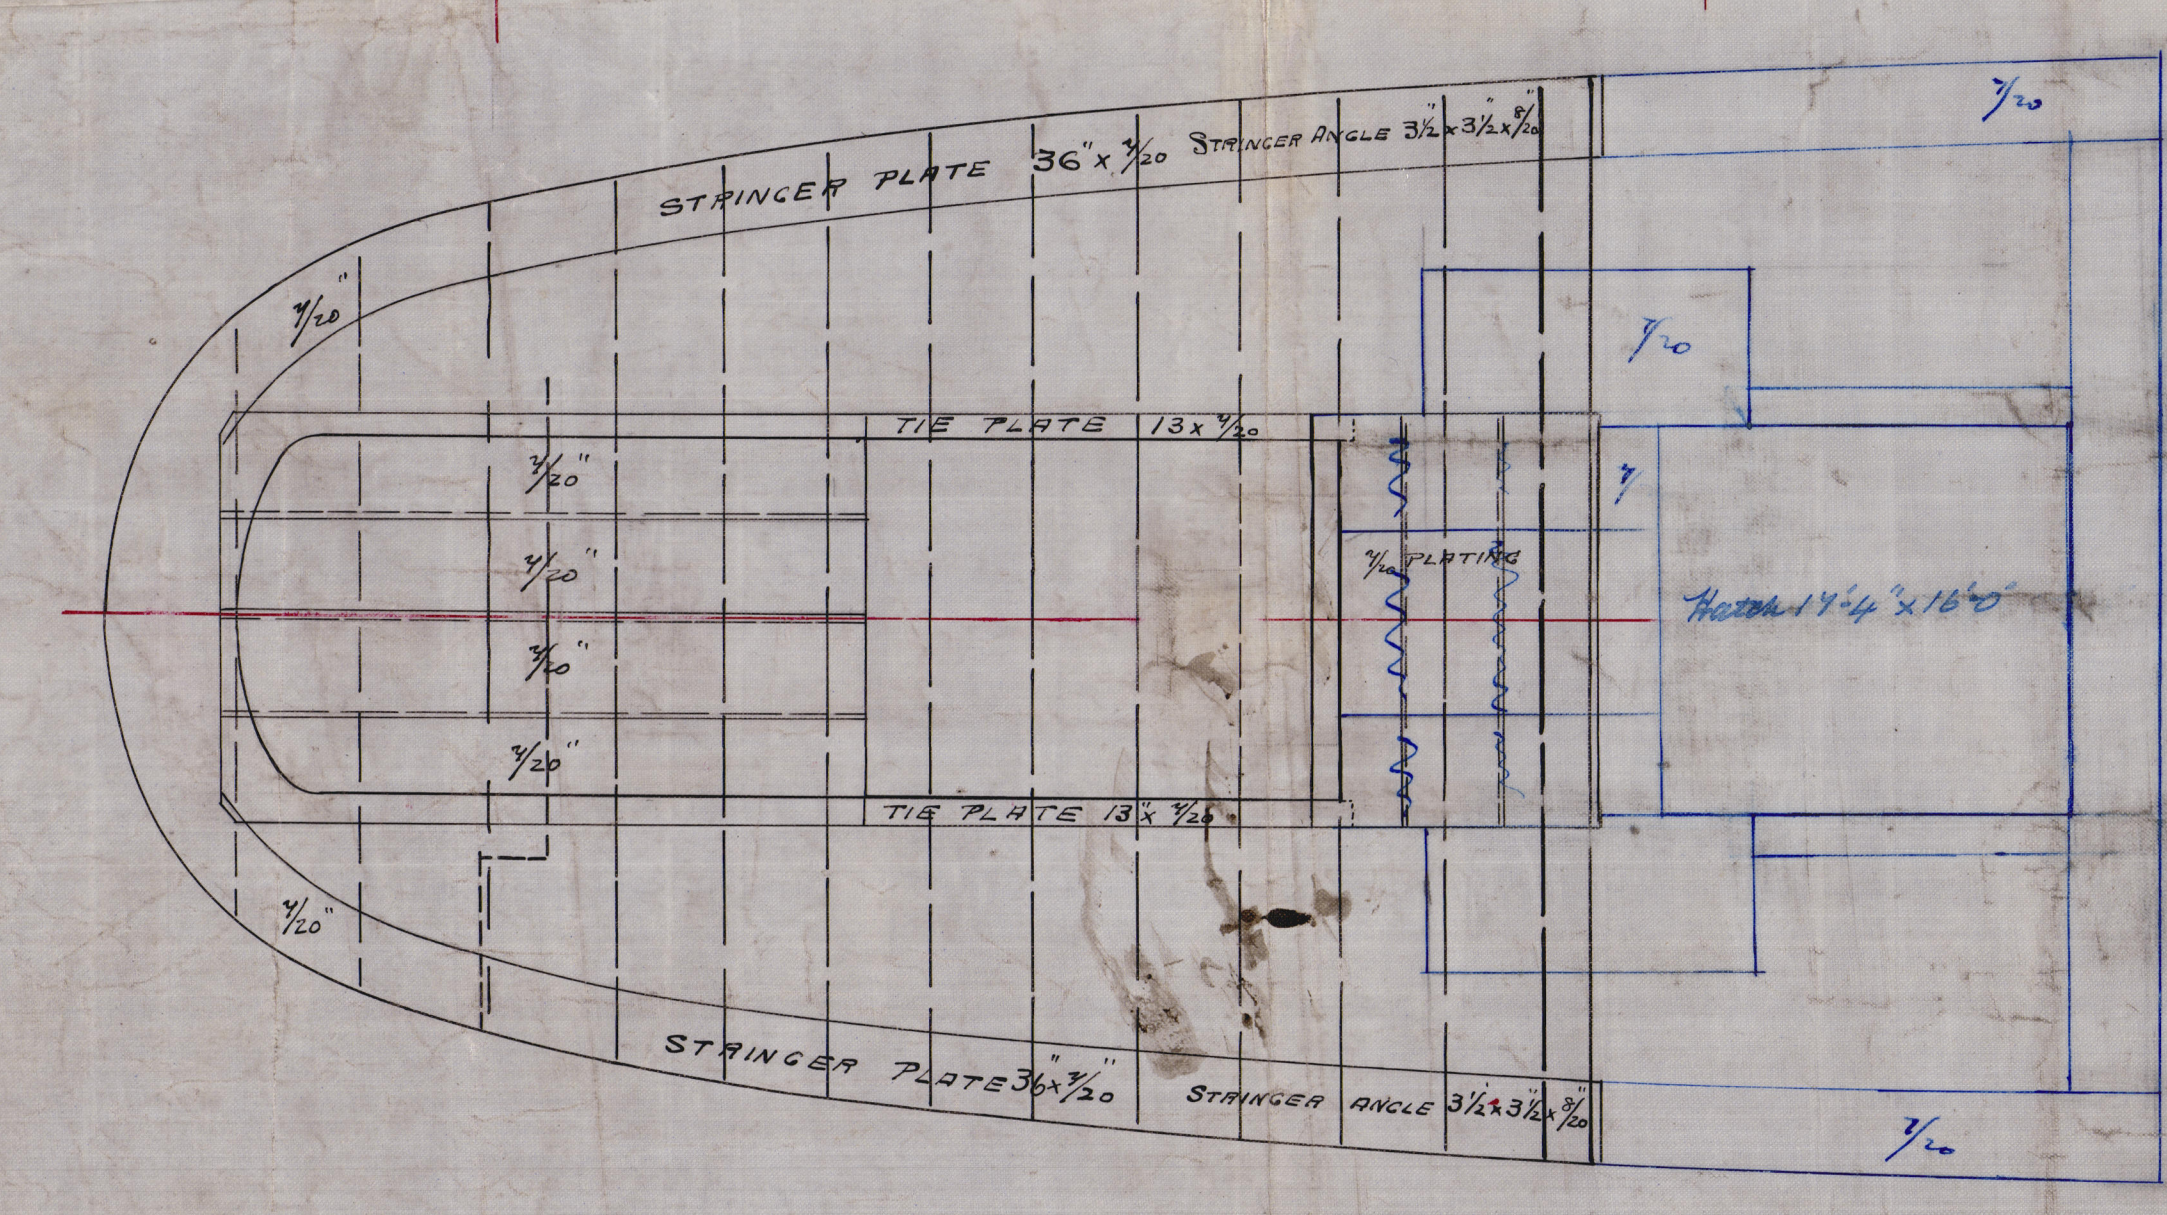


2.10.01
18.10.01
14.1.02
16.1.02
24.1.02
19.6.02
1.7.02

 

- PROFILE & DECK PLAN -
- T.S.S. No. 432 -
scale 1/8" = 1 foot
TO CLASS 100.A1 THREE DECK RULE
MOULDED DIMENSIONS 450' 0" x 52' 0" x 33' 8"

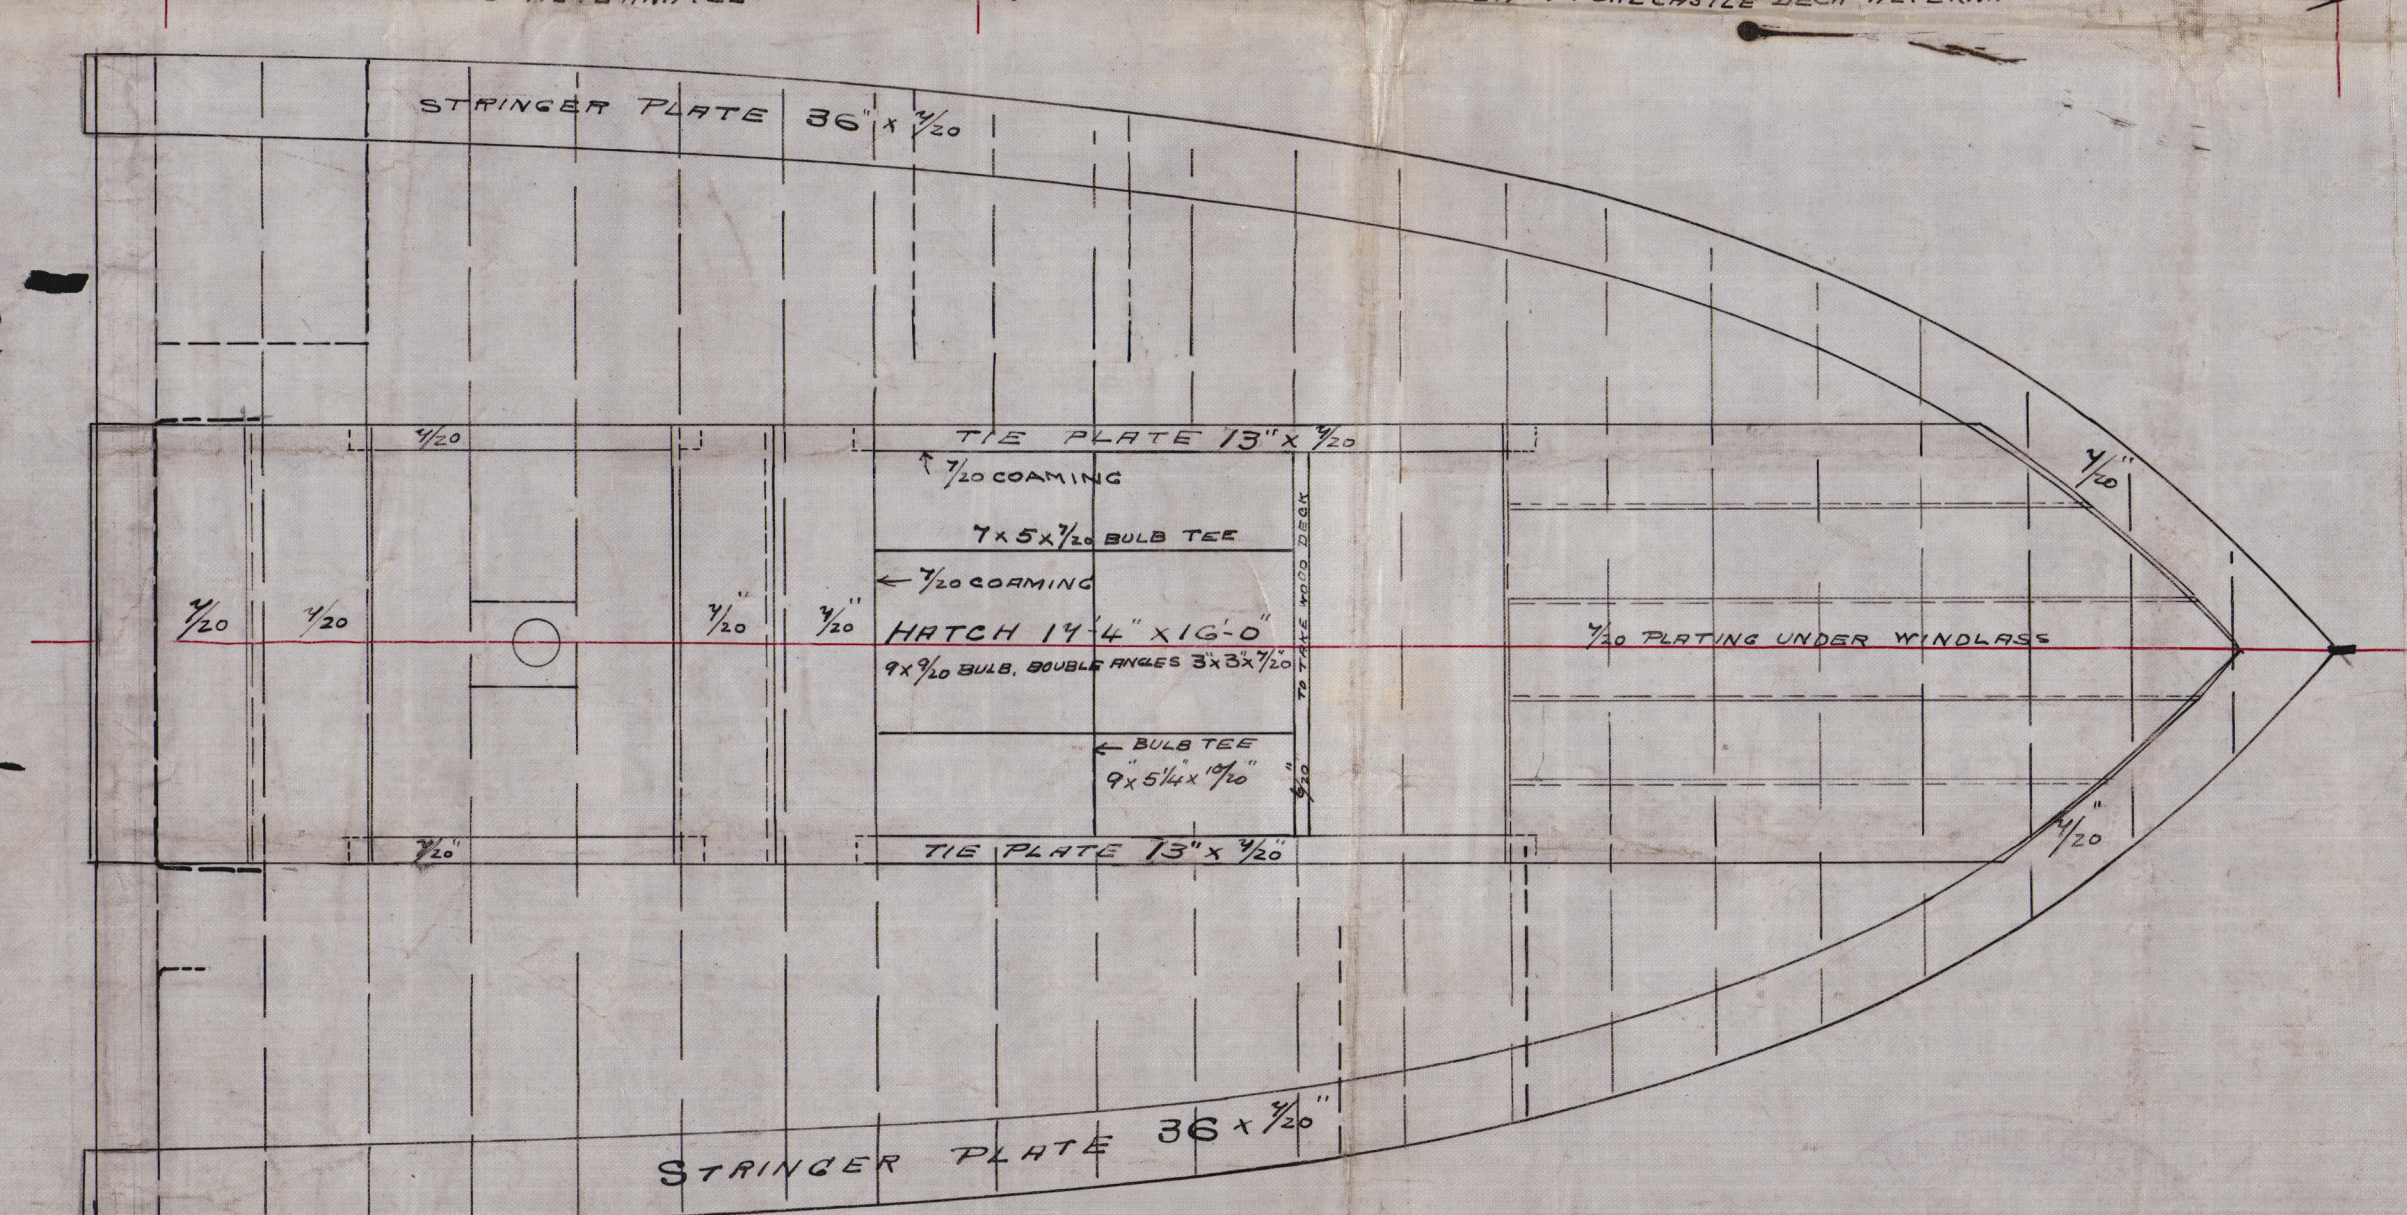


Amended

Profile DR plan

Barclay Curless
No 402 S/S

Commonwealth
Exempt No. 00290

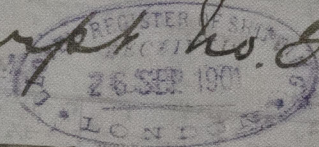

RETAIN



© 2021

Lloyd's Register
Foundation