




2-10-01  
2-11-01  
24-1-02

 

**DECK PLAN**  
**T.S.S. No 432**  
scale 1/8" = 1 foot  
TO CLASS 100, AT THREE DECK RULE  
MOULDED DIMENSIONS 450'0" x 52'0" x 33'6"

 

REVIEW

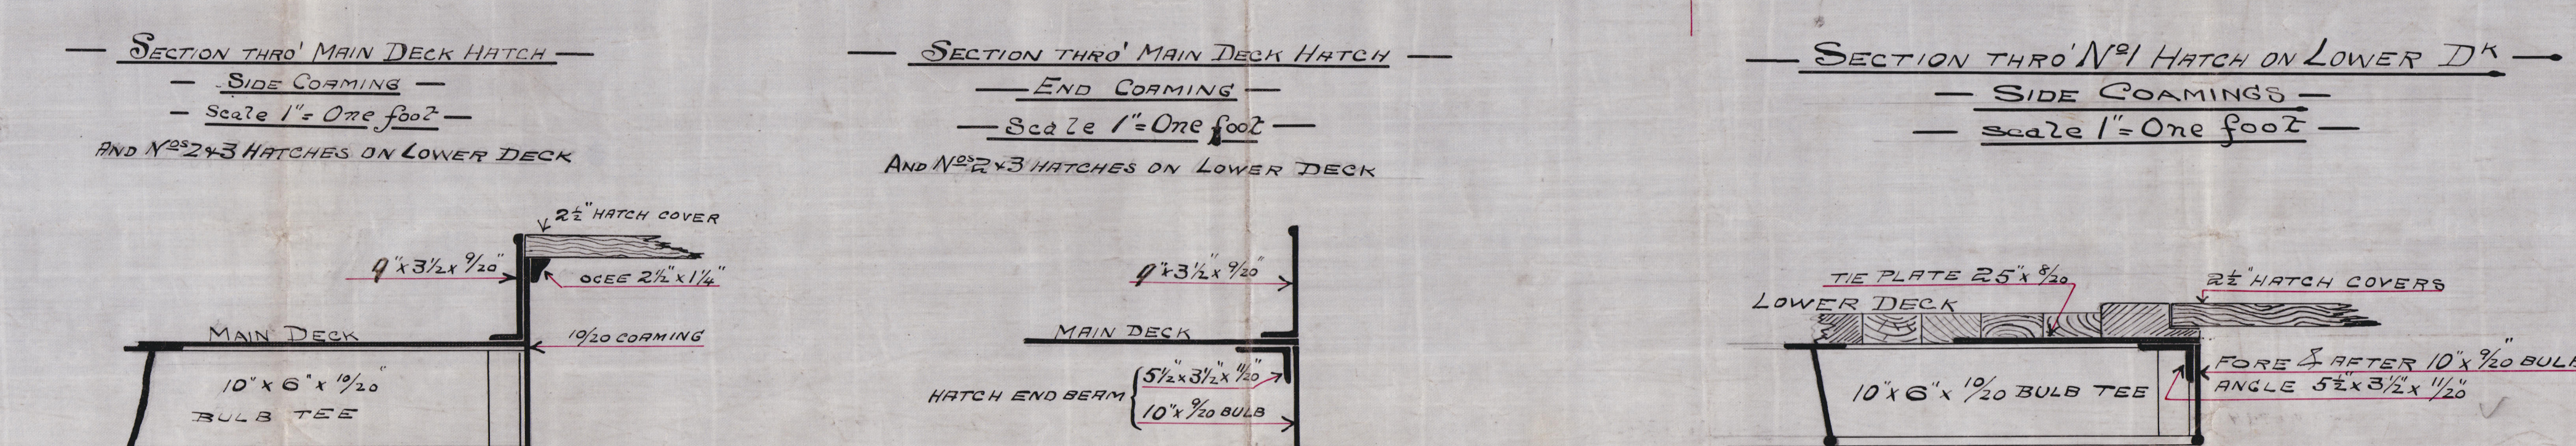


Well plates increased in depth at middle of length as per rule.



Amended  
Deck plan

Barclay Curlew  
No 41245 Commonwealth  
Grant No. 10290

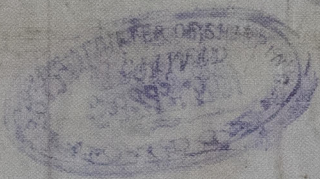

RETAIN



© 2021

Lloyd's Register  
Foundation

W 702-0172