

Lloyd's Register of Shipping.

(Report on Vessel No. 27/60 Port Sunderland)

Hopelyn

No. 16069 SHIP FORGINGS OR CASTINGS.

I have to report that the undermentioned ~~Iron or Steel Forgings or Castings~~, manufactured by Widdall's Slipway & Graving Dock Co. of Wilmington Quay for the Vessel No. 1041, being built by Burns, Hunter & W. Richardson & Co. of Sunderland have been inspected by me as set forth below and found to be, so far as can be seen, Sound

Mark on Forgings or Castings.

Lloyd's

No. 2509N

W. C.

McC Campbell


Newcastle

	STERN FRAME.	RUDDER FRAME.	STEM.
Material*	Scrap Iron	Scrap Iron	
How made	Forged & Smithed	Forged & Machined	
Dimensions	9 x 5 1/2	7 1/2	
Progress on Inspection	Smithing finished.	Machined & Built	
Date when Inspected	July 30, to August 7-1917. November 12-1917.		
CASTINGS.			
Tests on Standard Test Pieces.			
<u>Tensile Test—</u>			
Tons per square inch			
Extension per cent.			
<u>Cold Bending Test—</u>			
Angle before fracture			
<u>Drop Test—</u>			
Height from ground			
<u>Hammering Test—</u>			
If made according to Rules and found satisfactory ...)			

SKETCHES OF FRAMES SHOWING POSITION AND DESCRIPTION OF WELDS OF FORGINGS.




WELDS

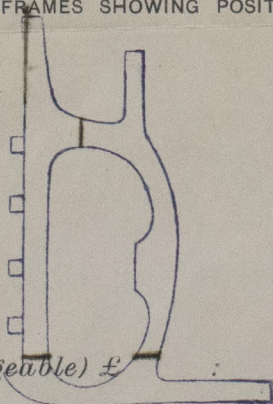

Fee (if any chargeable) £ : :

To be paid at

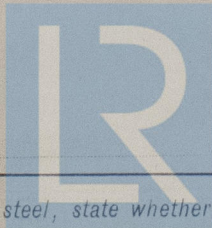

© 2021

Lloyd's Register

Foundation

W702 - 0220

* If of Iron, state whether scrap or puddled Iron. If of steel, state whether made on the Open Hearth process.

'Hapelyn'
Ship forgoing

SUNDERLAND RPT. No. 27160.
dated 19.2.18

Send to
London



© 2021

Lloyd's Register
Foundation