


N^o 1039 1041

285' 0" BP x 41' 6" EX x 21' 4" MD

PROFILE AND DECK PLANS

Scale 1/8" = 1 Foot

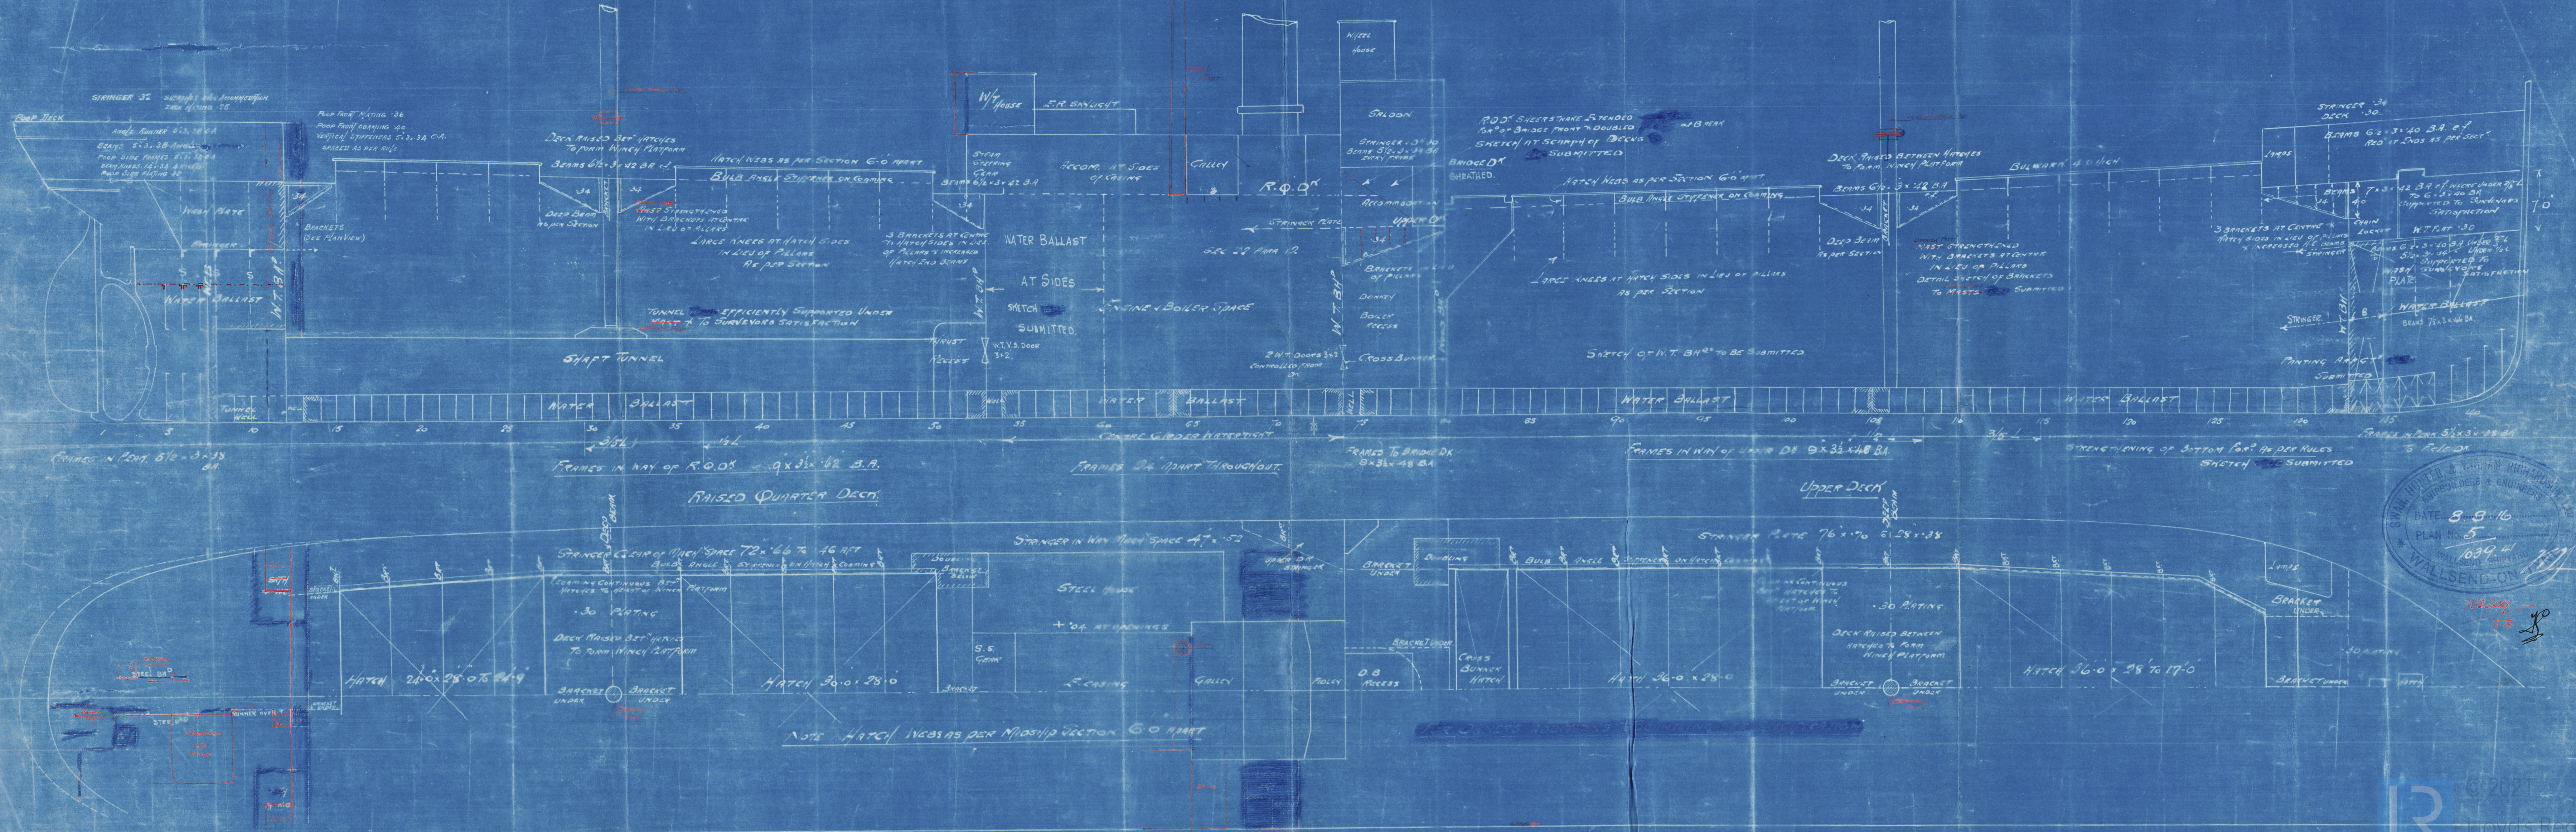

1039 1041
WILLSEND & CO

RECEIVED
JAN 10 1918
NEW YORK



© 2021

Lloyd's Register
Foundation

PROFILE AND DECKS
(AS FITTED)

SWAN HUNTER AND WIGHAM RICHARDSON

Nº 1041

S.S. HOPELYN. SLD RPI Nº 27 160

RECEIVED



© 2021

Lloyd's Register
Foundation

W702 - 0224