

Lloyd's London
 Stamp
 8-12-05 = (521)

MIDSHIP SECTION

N^{os} 504

LLOYD'S NUMERALS.

1/2 GIRTH	20.150
1/2 BREADTH	11.437
DEPTH	12.418
	44.005 1 st N ^o
	147.04
	6470.4952 2 nd N ^o

DIMS 148'-4" x 23'-0" EX. x 22'-10 1/2" x 11'-9 1/2" ML^o


SCALE 1/2" = 1 FOOT.

STEEL. CLASS 100 A.1.

FOR FISHING PURPOSES.

EQUIPMENT.

- ONE ANCHOR 6 1/4 CMT. EX. STOCK.
- " " 5 3/4 " " "
- " " 3 1/4 " " "
- 120 FATHOMS 1 1/8 CHAIN STUD LINK
- 60 " 6" HANSER
- 60 " 5" HANSER.

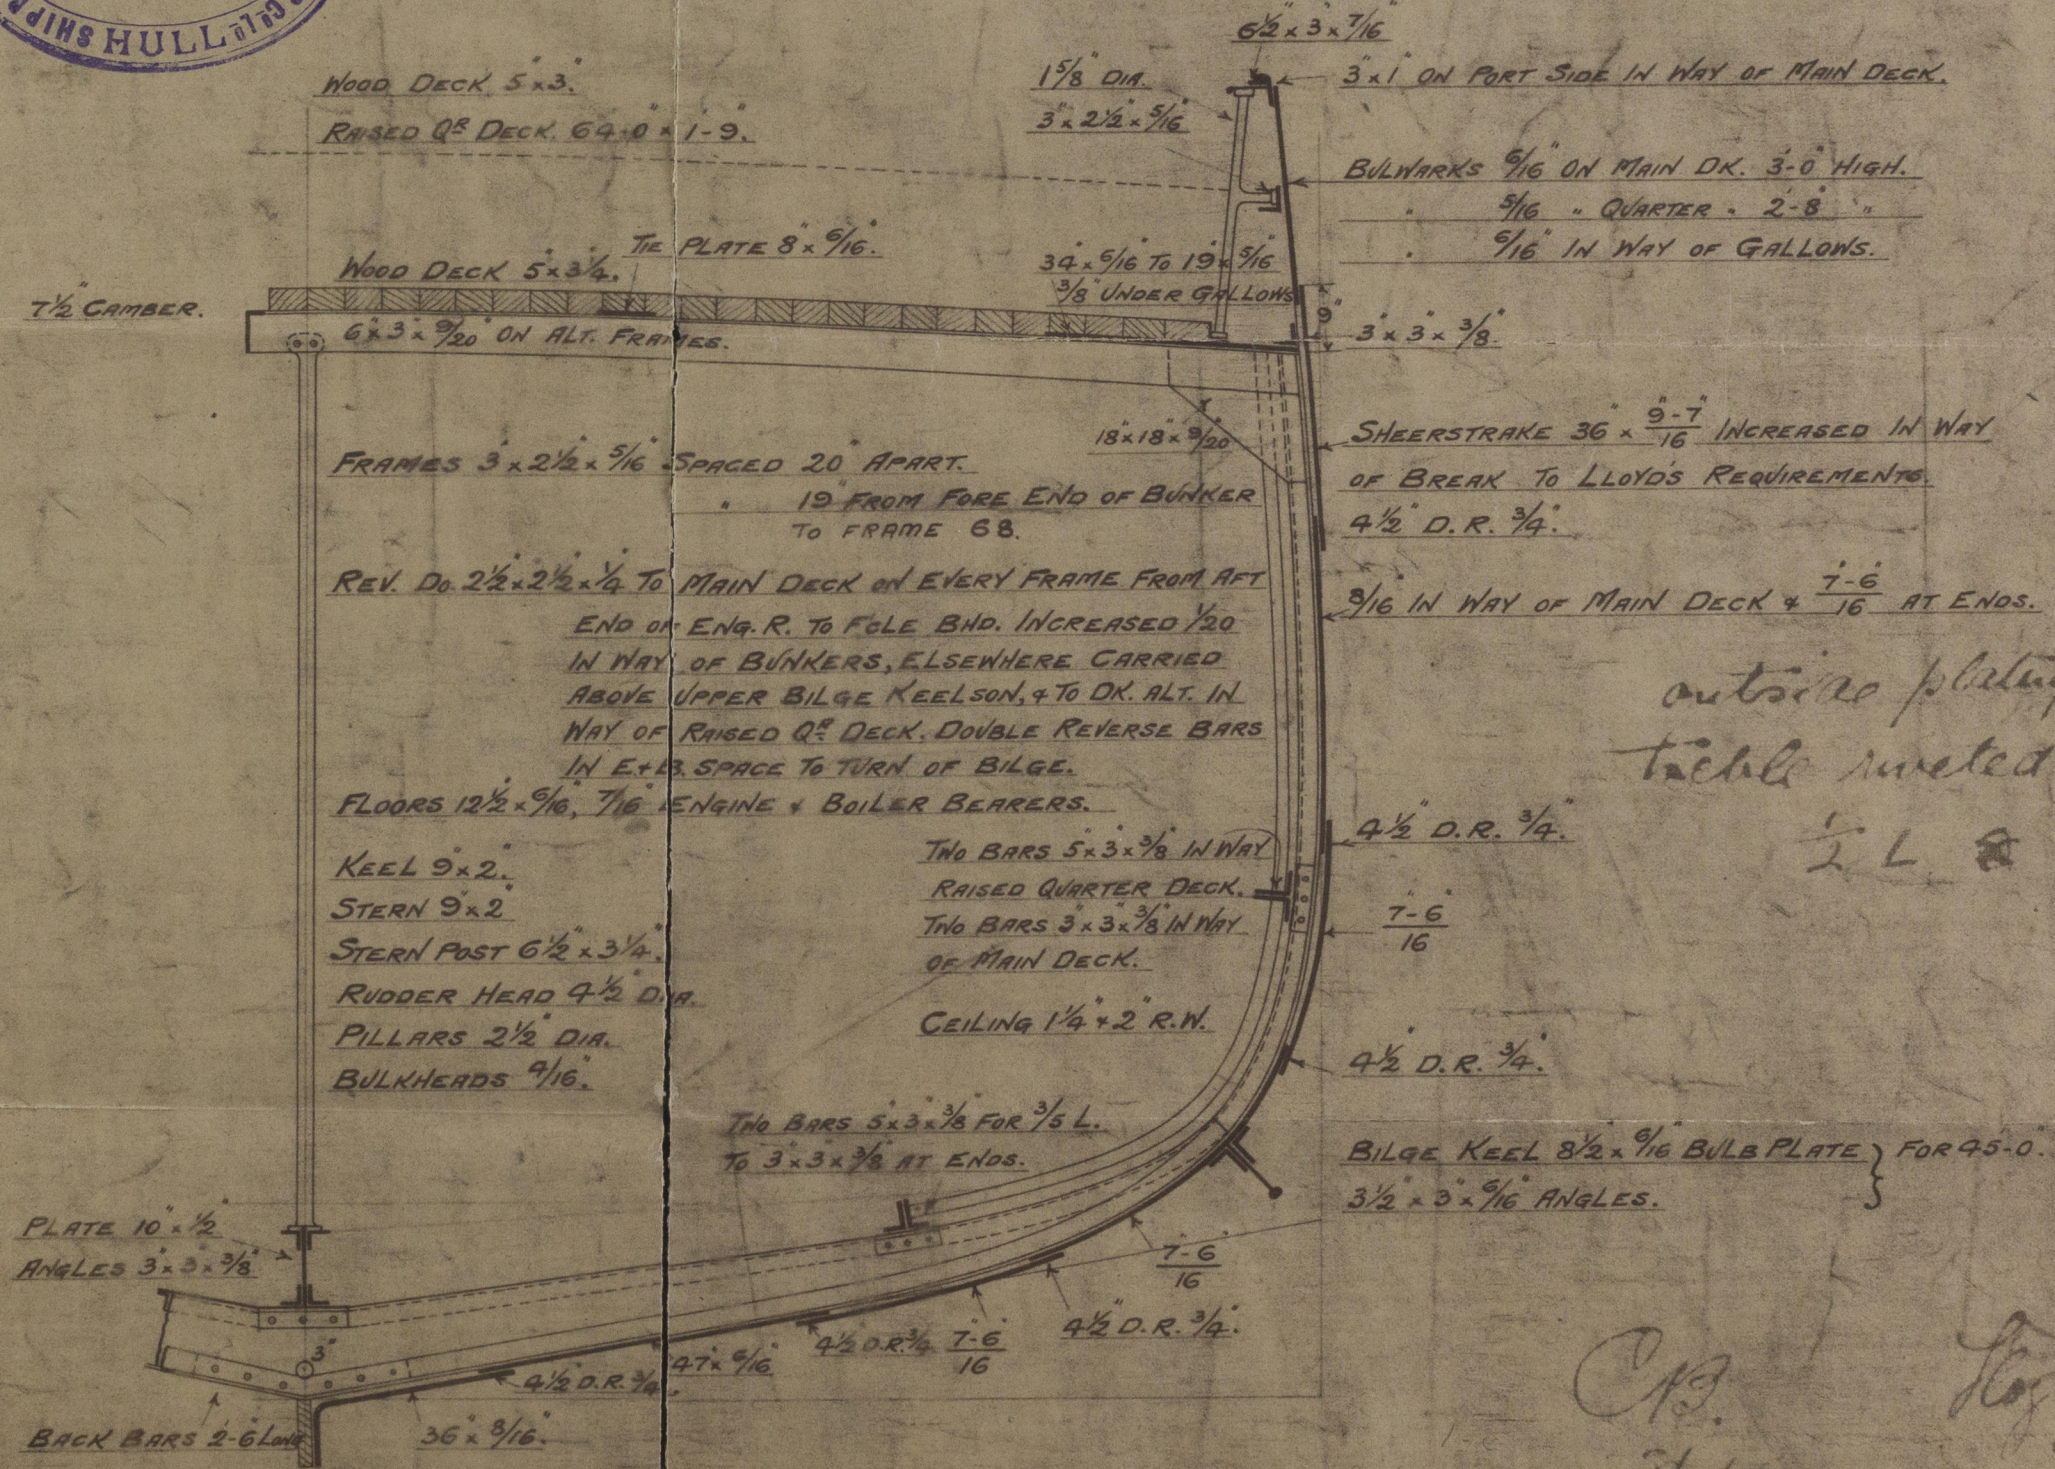

outside plating back
 table riveted for
 S.L. &

C.P.
 8/3/08

Lloyd's
 Hull Stamp

Earle's S. & R. Co. Ltd.

No 504.

Duplicate
Midship Section.

s/s Hamlet

Hull Report No. 17567



RETAIN



© 2020

Lloyd's Register
Foundation

W 703 - 0028