






27/11/22

ENCLOSURE.
To Lloyd's Register of Shipping

CIRCUM SEAMS DOUBLE RIVETTED
18 HOLES 3 3/8" PITCH

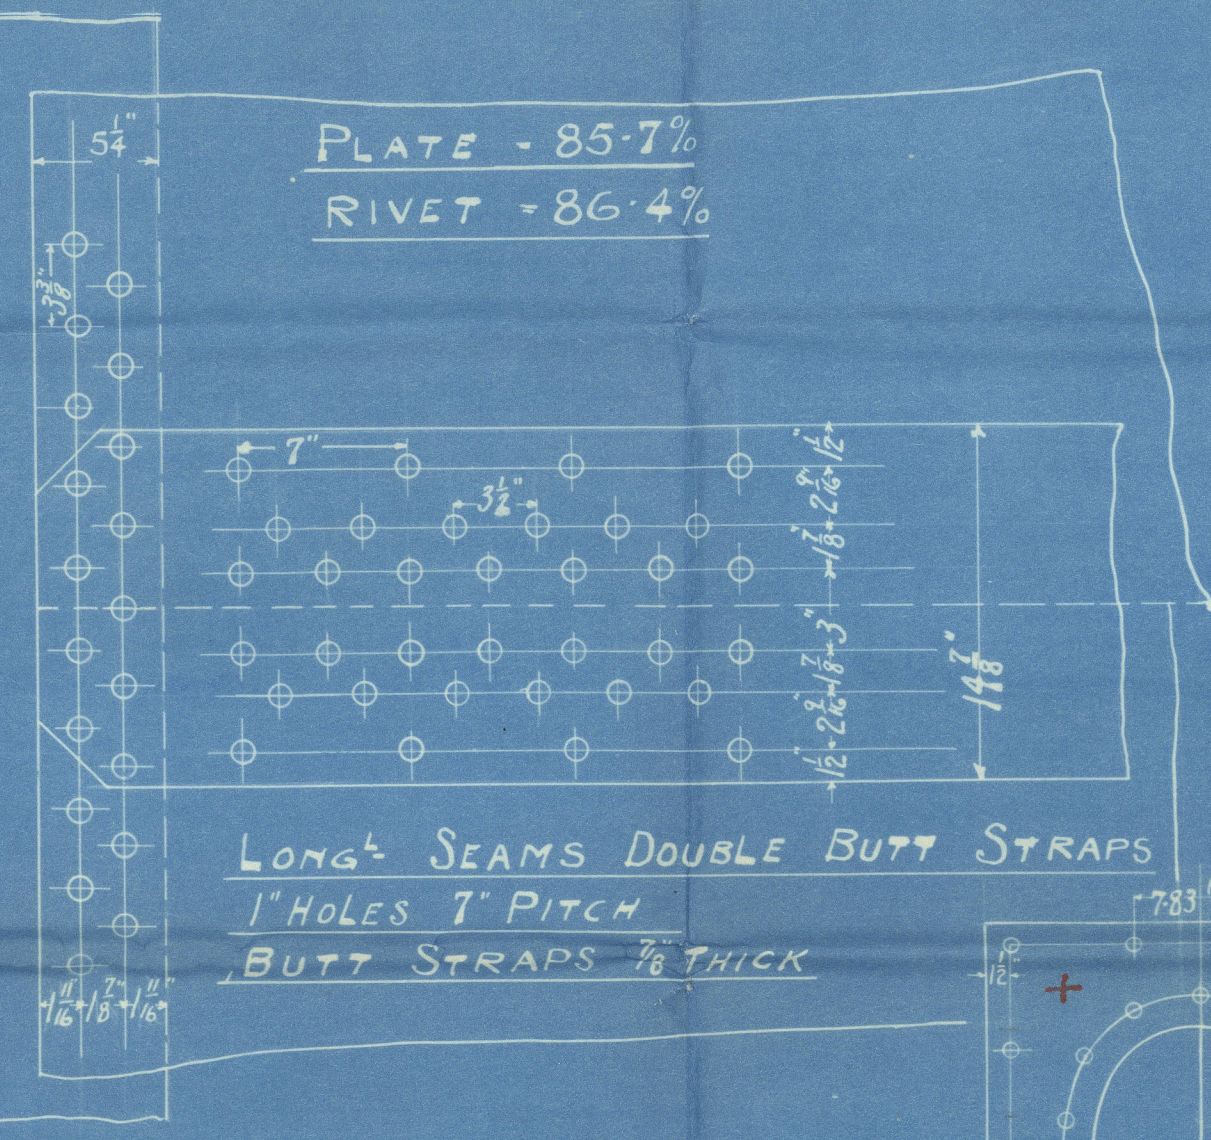

STEEL PLATES, BARS AND RIVETS
IRON TUBES
TENSILE STRENGTH OF SHELL, BUTT STRAPS, GIRDERS
AND MANHOLE RING 28 TO 32 TONS PER SQ INCH
ALL HOLES DRILLED IN PLACE

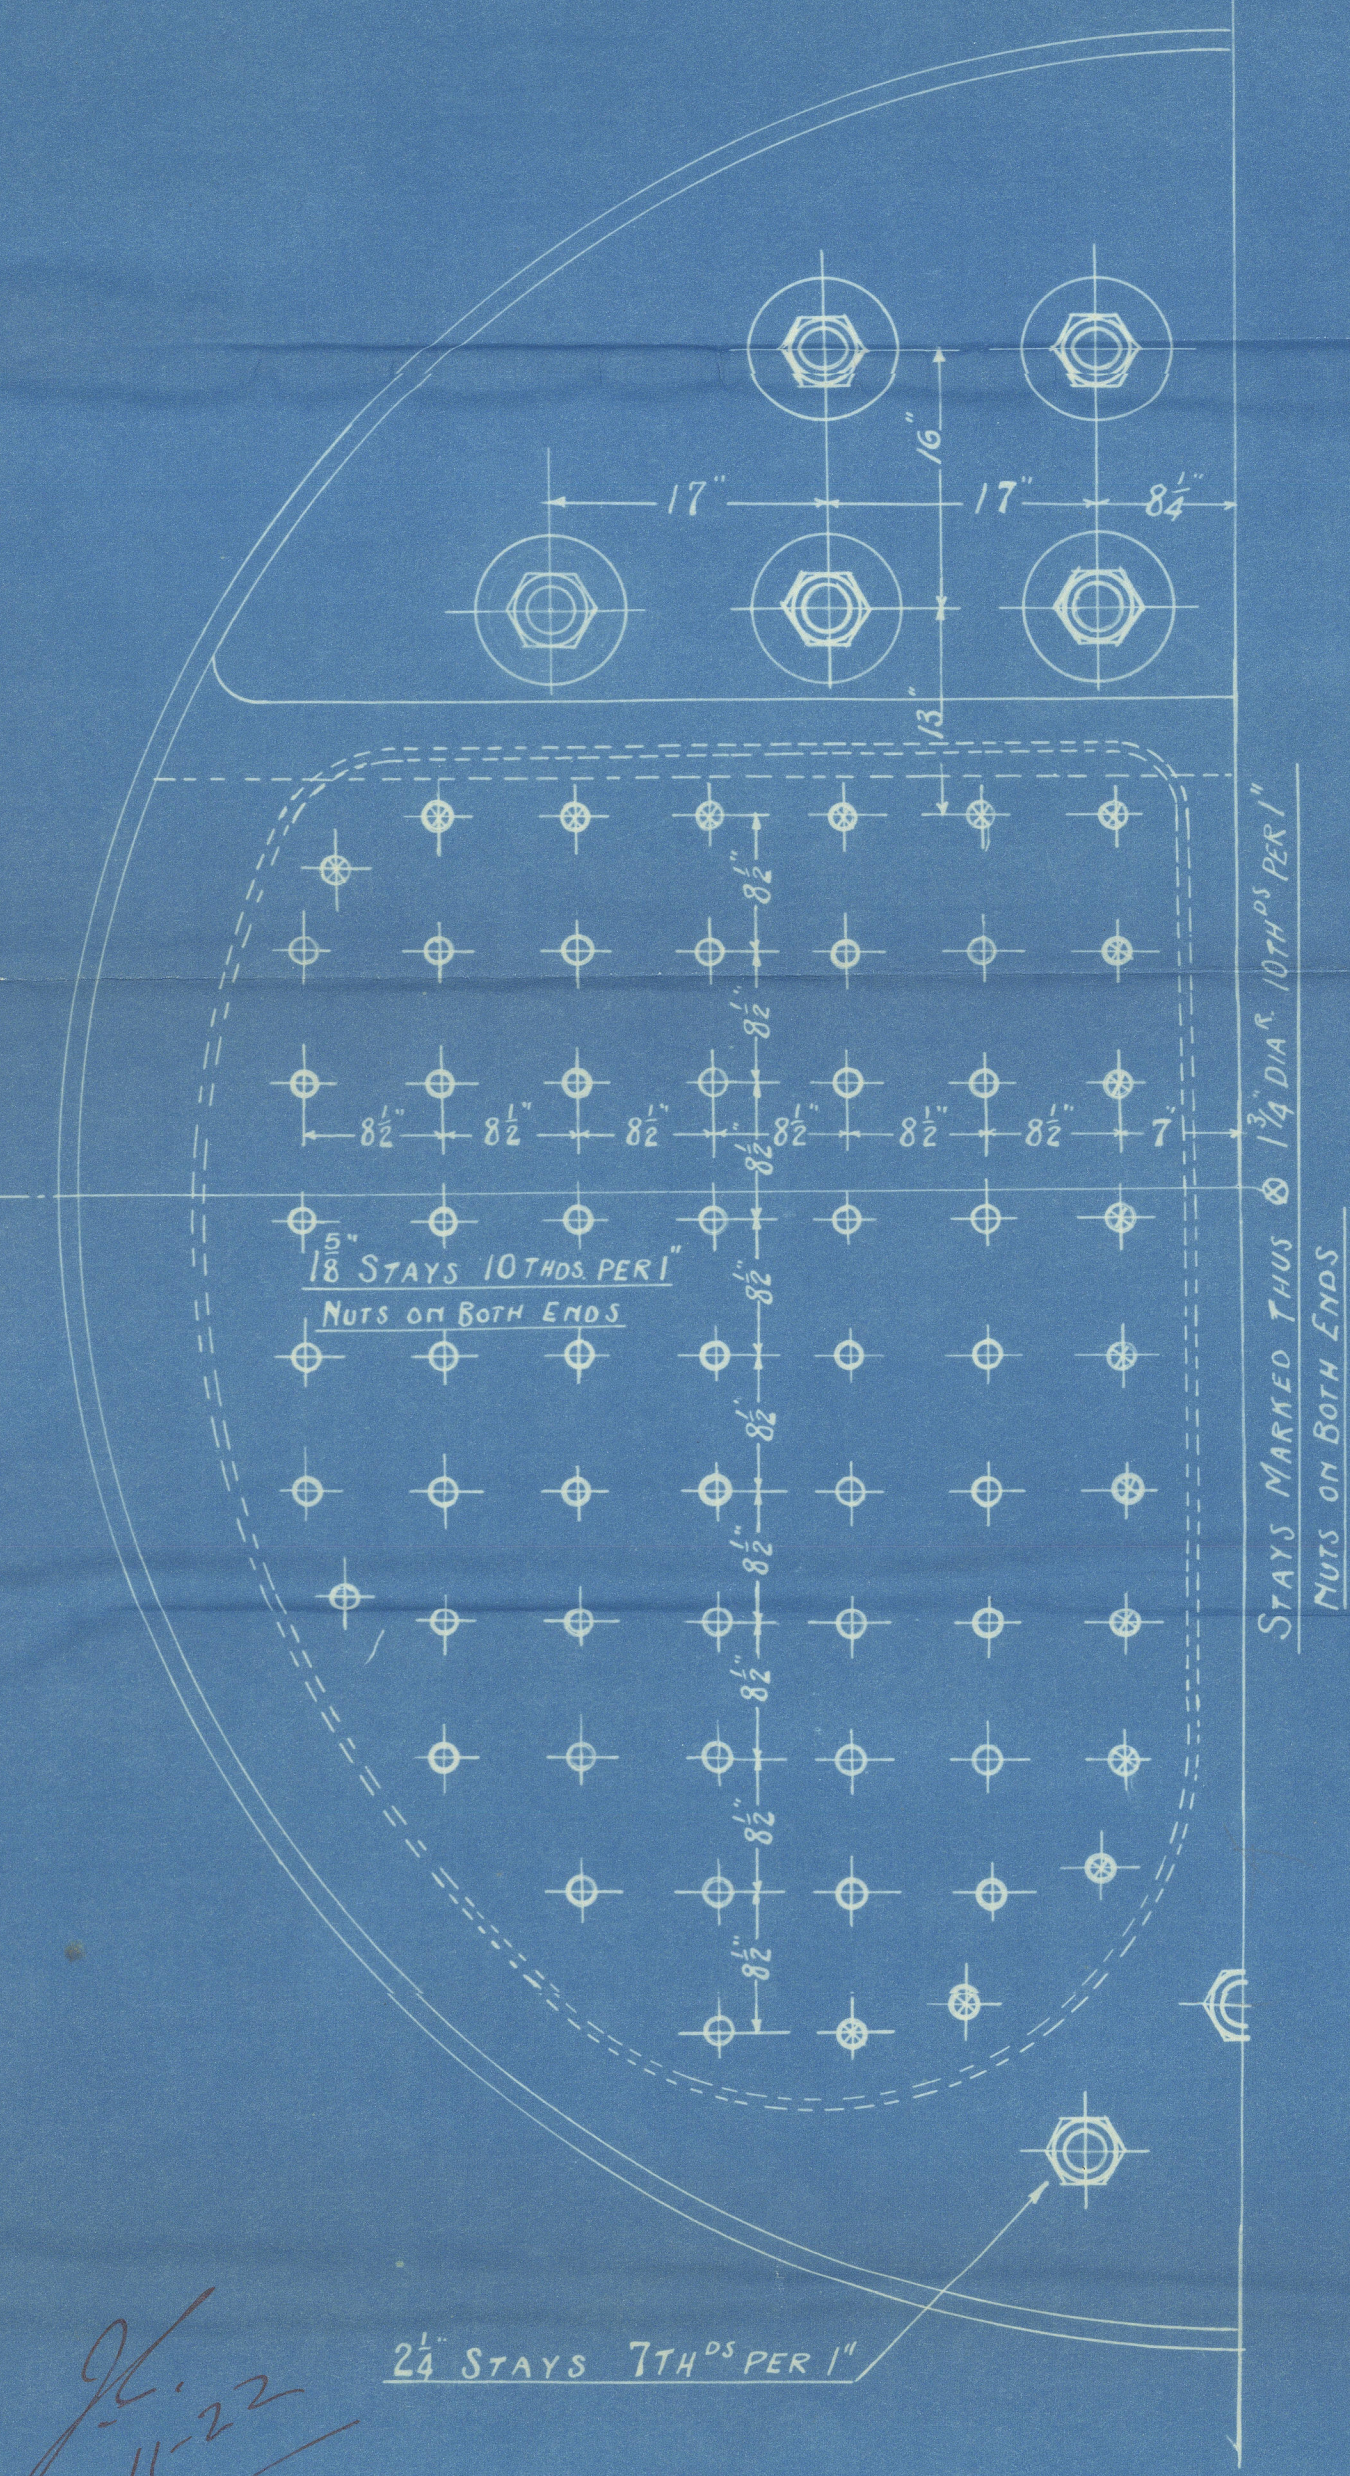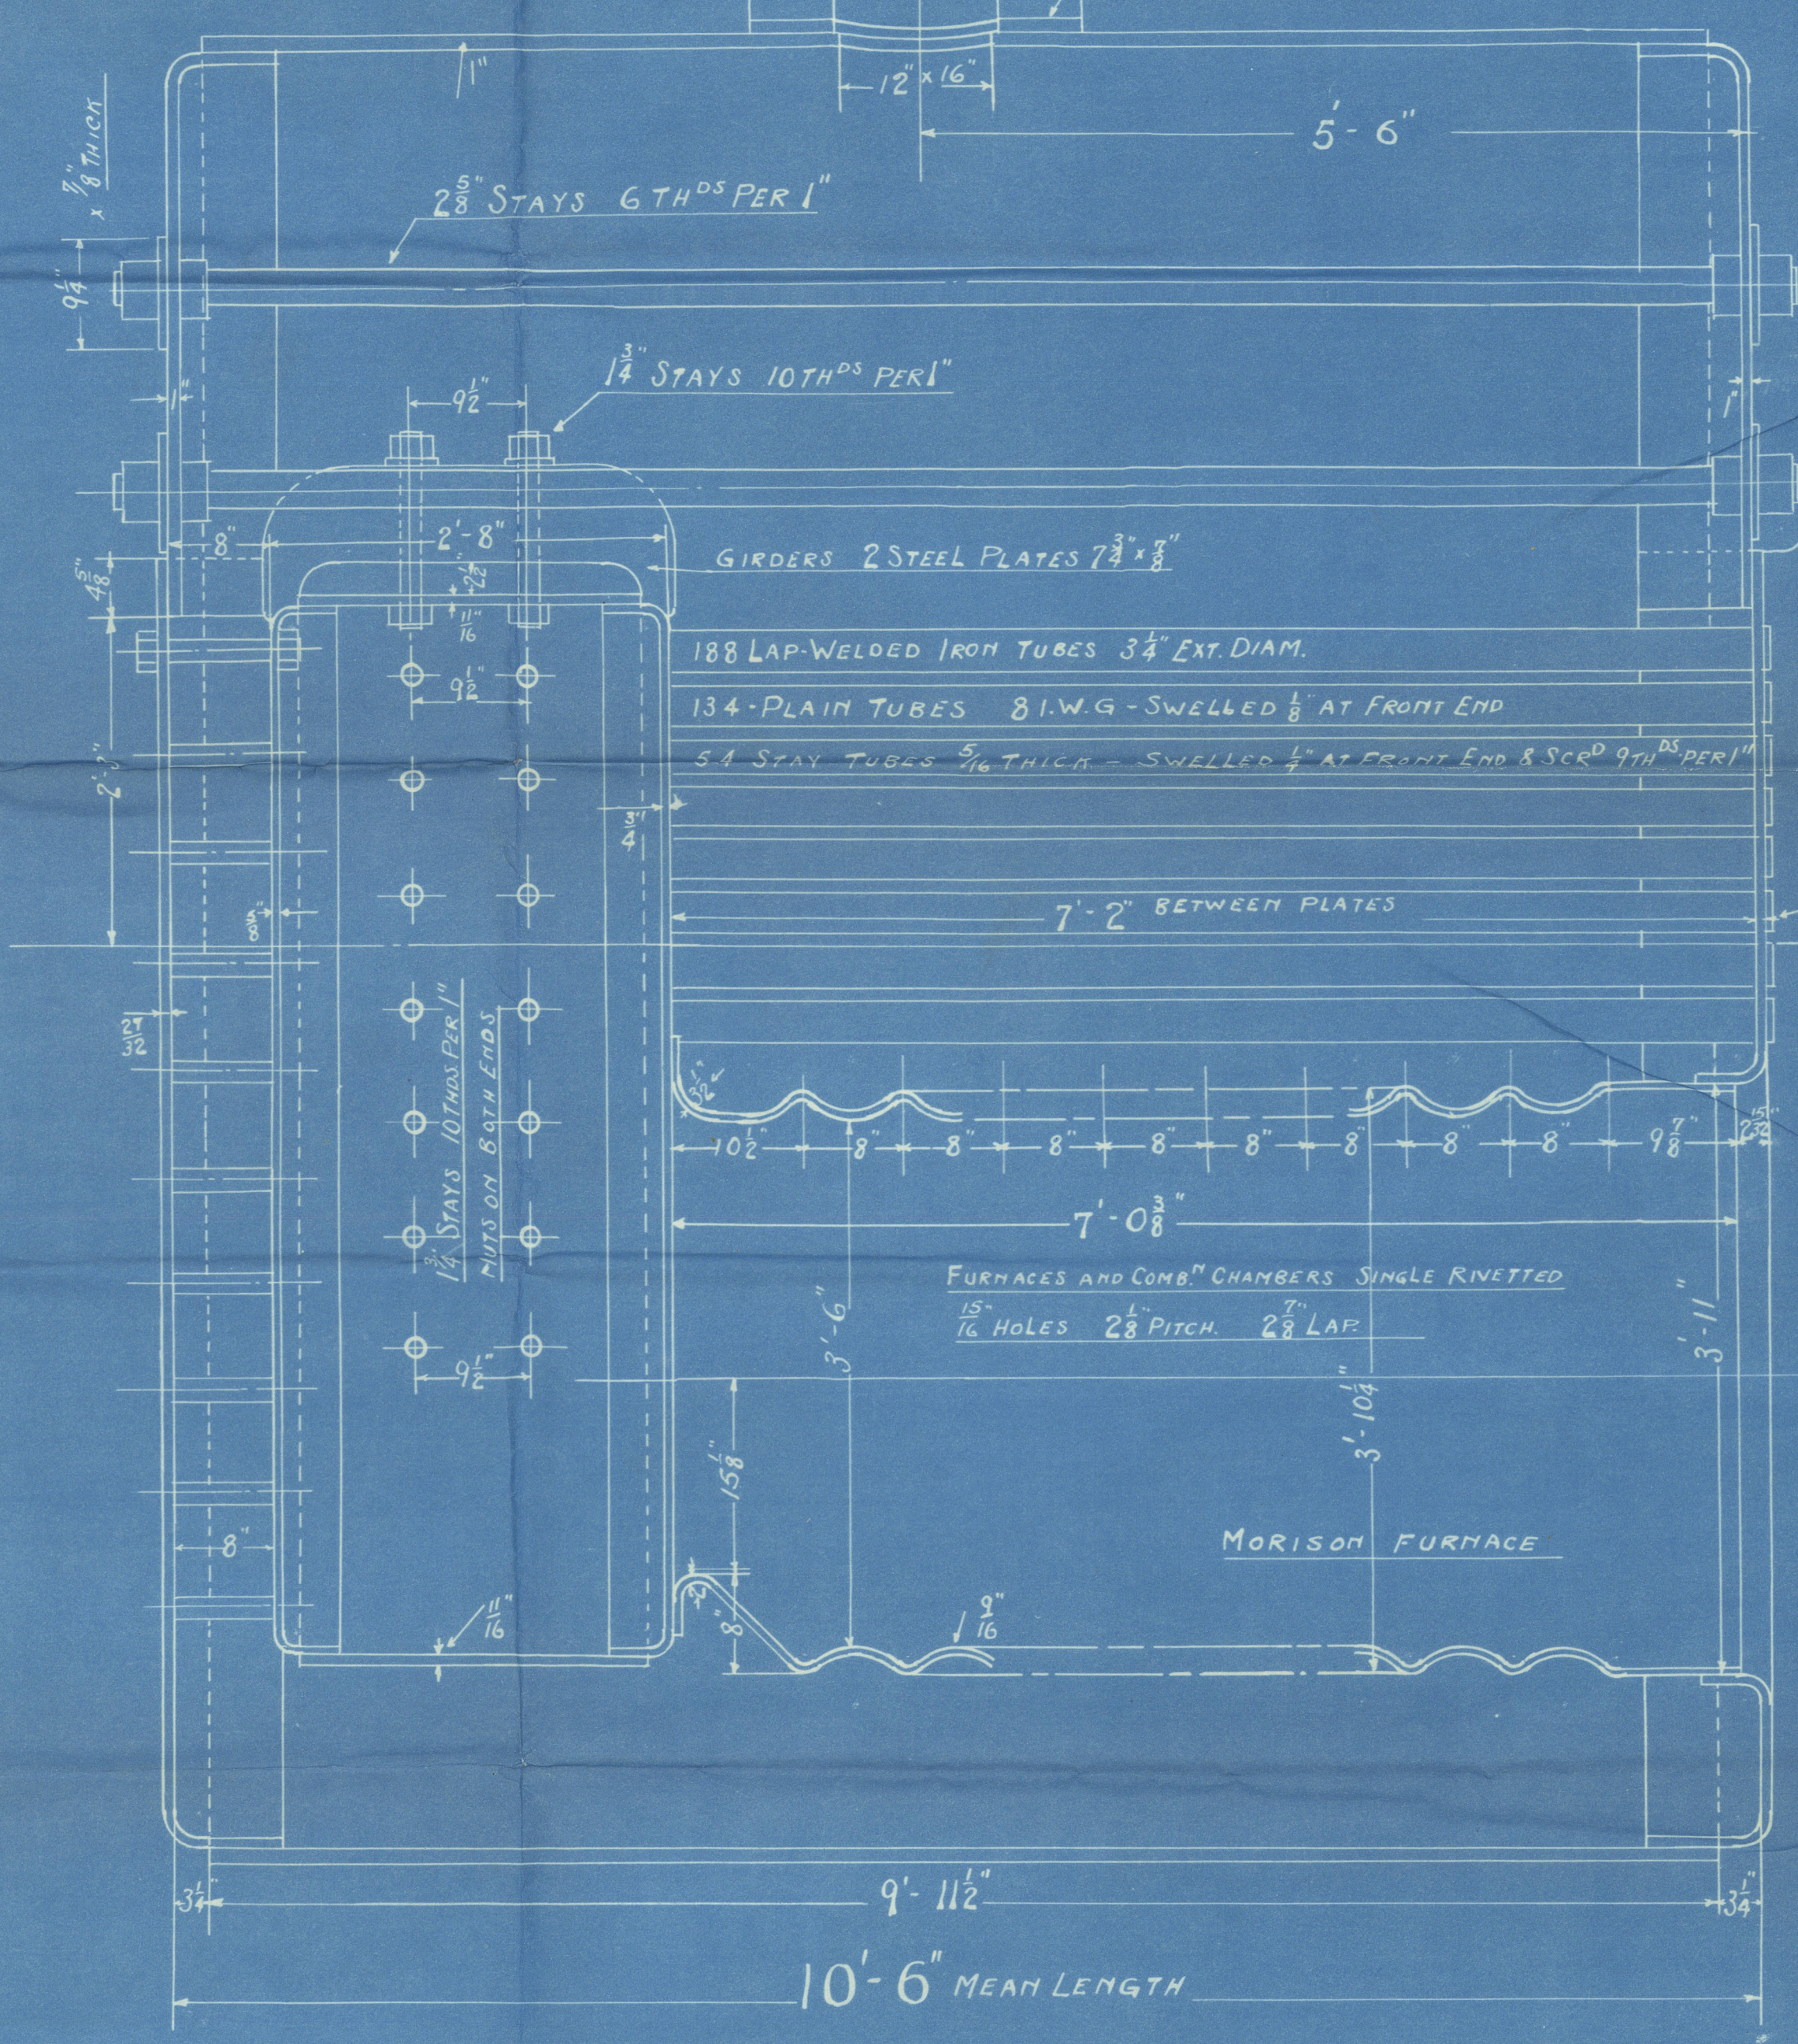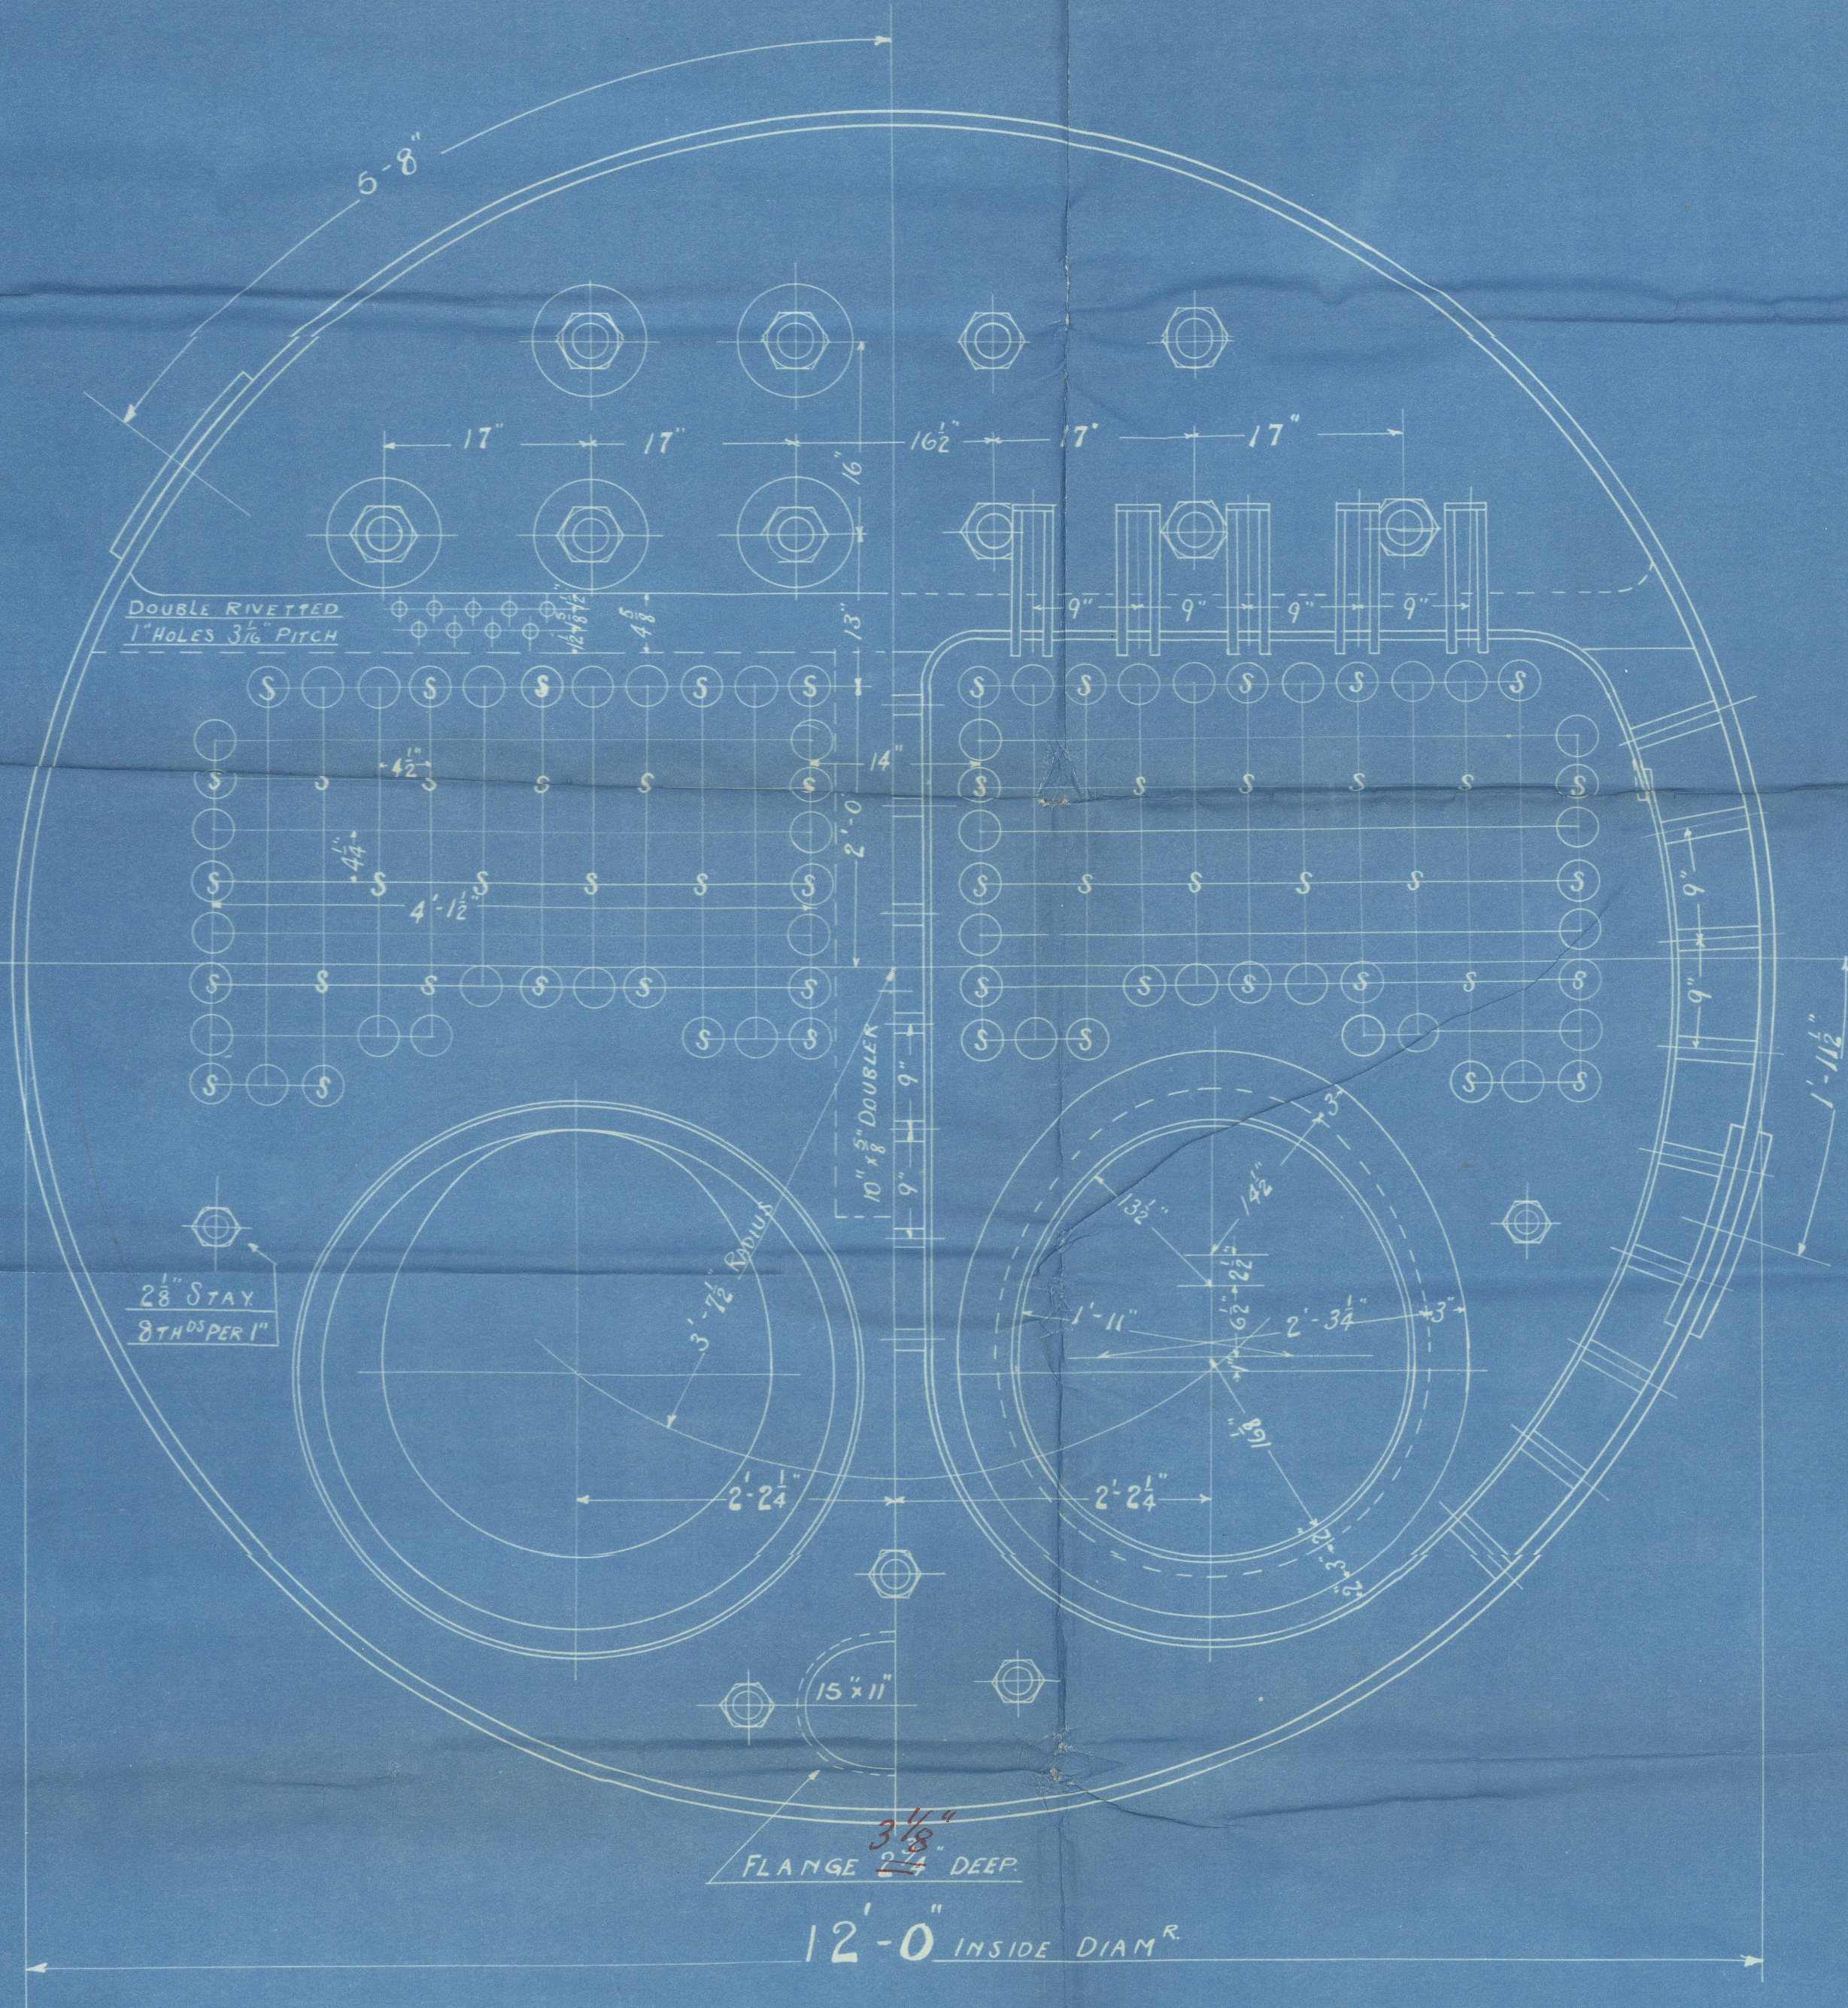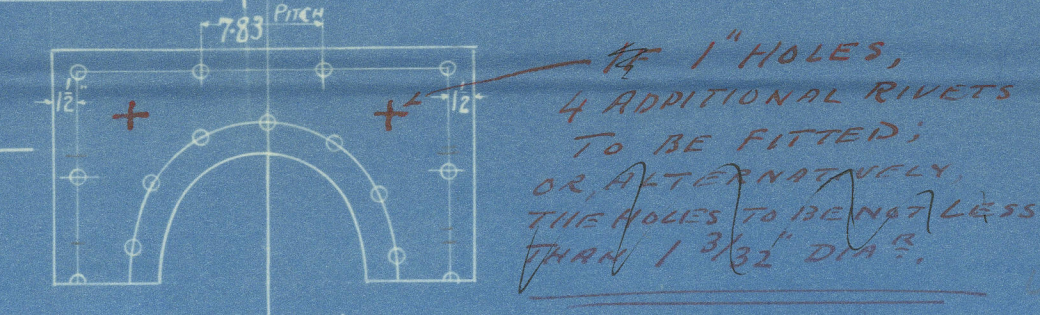

STAYS MARKED THUS @ 1 1/4 DIA 10 THDS PER 1" NUTS ON BOTH ENDS

27-11-22

BOILER N^o 16767

WORKING PRESSURE 180 LBS. PER SQ INCH
SCALE INCH = 1 FOOT

GRATE SURFACE (5'-6" BAR)	39.5
TUBE HEATING SURFACE	1147.5
OTHER " "	255.5
TOTAL " "	1403
RATIO H.S. TO G.S. =	35.6:1

TO HAVE LLOYD'S CERTIFICATE



ENCLOSURE.
From ROSS & DUNCAN,
To Lloyd's Register of Shipping

Glasgow.

Ross & Duncan.

Boilers nos 1676/7.

W.P. 180 lbs.

1676
No 1626
LLOYD'S TEST
320 lbs
W.P. 180
J.S.C. 17-5-22

1677
No 16257
LLOYD'S TEST
320 lbs
W.P. 180
J.S.C. 17-5-22

For Engine no 1112

GLASGOW REPORT No. 42744



© 2020

Lloyd's Register
Foundation























1112

PORT No.

42744

LR

© 2020

Lloyd's Register
Foundation

W703 - 0084