

CIRCUMF. SEAMS, DOUBLE RIVETED  
 1 1/8" HOLES 3 3/8" PITCH.

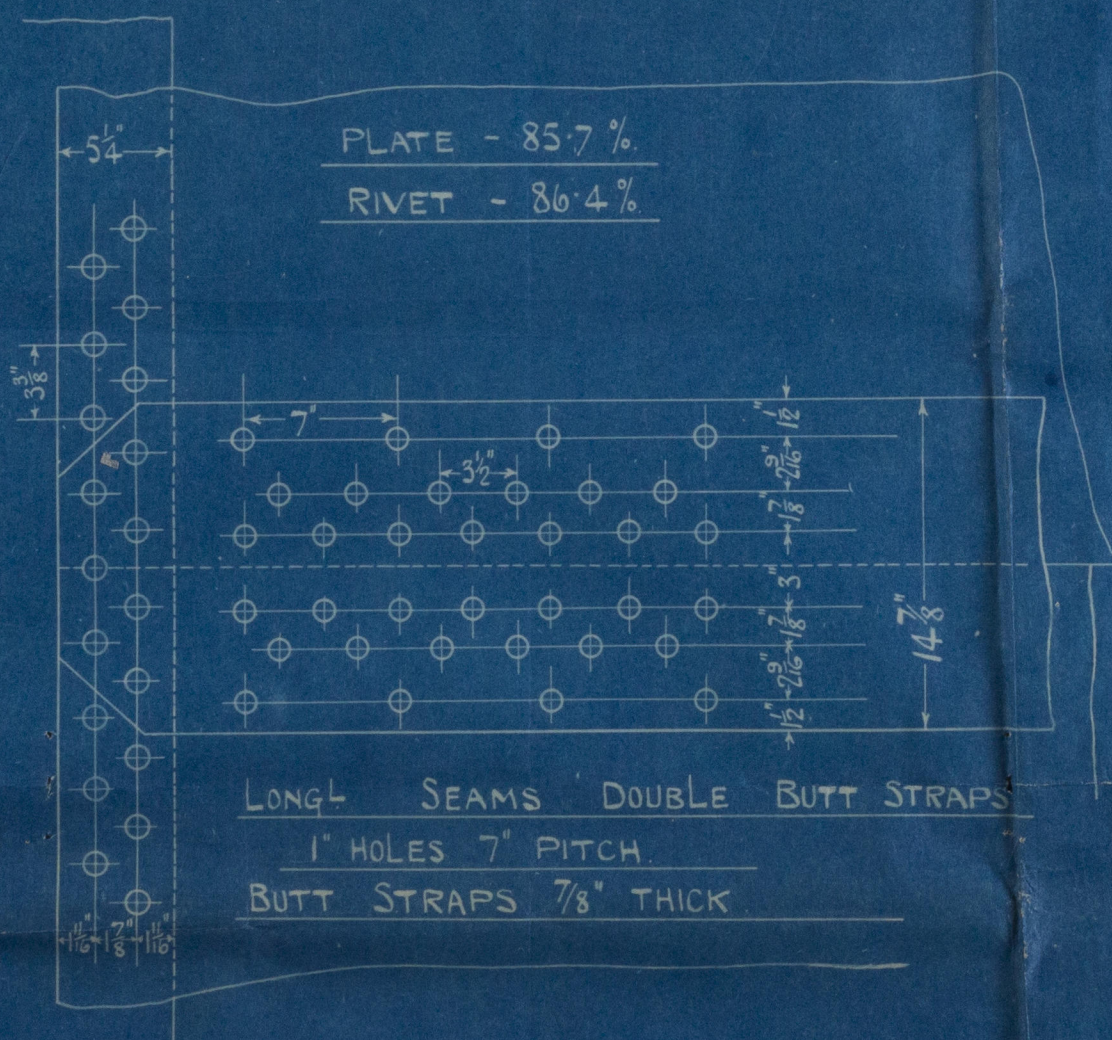


PLATE - 85.7 %  
 RIVET - 86.4 %

LONG SEAMS DOUBLE BUTT STRAPS  
 1" HOLES 7" PITCH.  
 BUTT STRAPS 7/8" THICK

Approved 9/12/22

SKETCH SHOWING ALTERATION TO RIVETING

BOILER NOS 1676 & 7

SCALE : 1 1/2" = 1 FOOT



W703-0086