





Mess Turner Ship & Co


No. 42

S.S. Bishopston.

Profile & Deck Plans  
as built

Middlesbro' F.R. Vpt.  
11630

RECEIVED

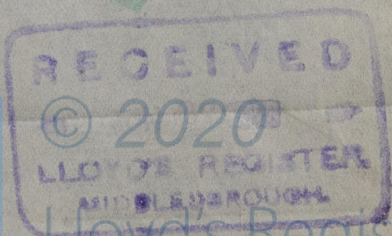

Lloyd's Register  
Foundation

W703-0087