






Messrs Furness Ship & Coys No. 42

S.S. "Bishopston"

Midship Section  
(as built).

Middlesbro' Y.L. Rpt. 11620

RECEIVED

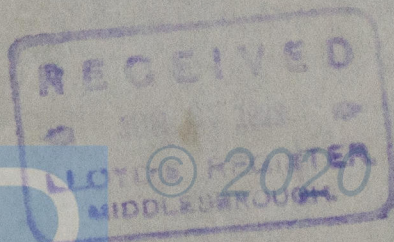

W703-0088

Lloyd's Register  
Foundation