

TRACING N° 1727.

DUPLICATE MIDSHIP SECTION SS N° 193.

LENGTH 140.0 BREADTH 23.10 DEPTH MOULDED 11.9

SCALE $\frac{1}{2}$ INCH = 1 FOOT.

TO CLASS 100A1 AT LLOYDS.


R. WILLIAMSON & SON.

SHIPBUILDERS.


WORKINGTON.

NUMERALS.

$\frac{1}{2}$ BREADTH 11.9
DEPTH 12.25
 $\frac{1}{2}$ GIRTH 22.25
FN 46.40 x 140.0 = PN 6496.
DEPTHS TO LENGTH... 11.42.
BREADTHS TO LENGTH... 5.87.

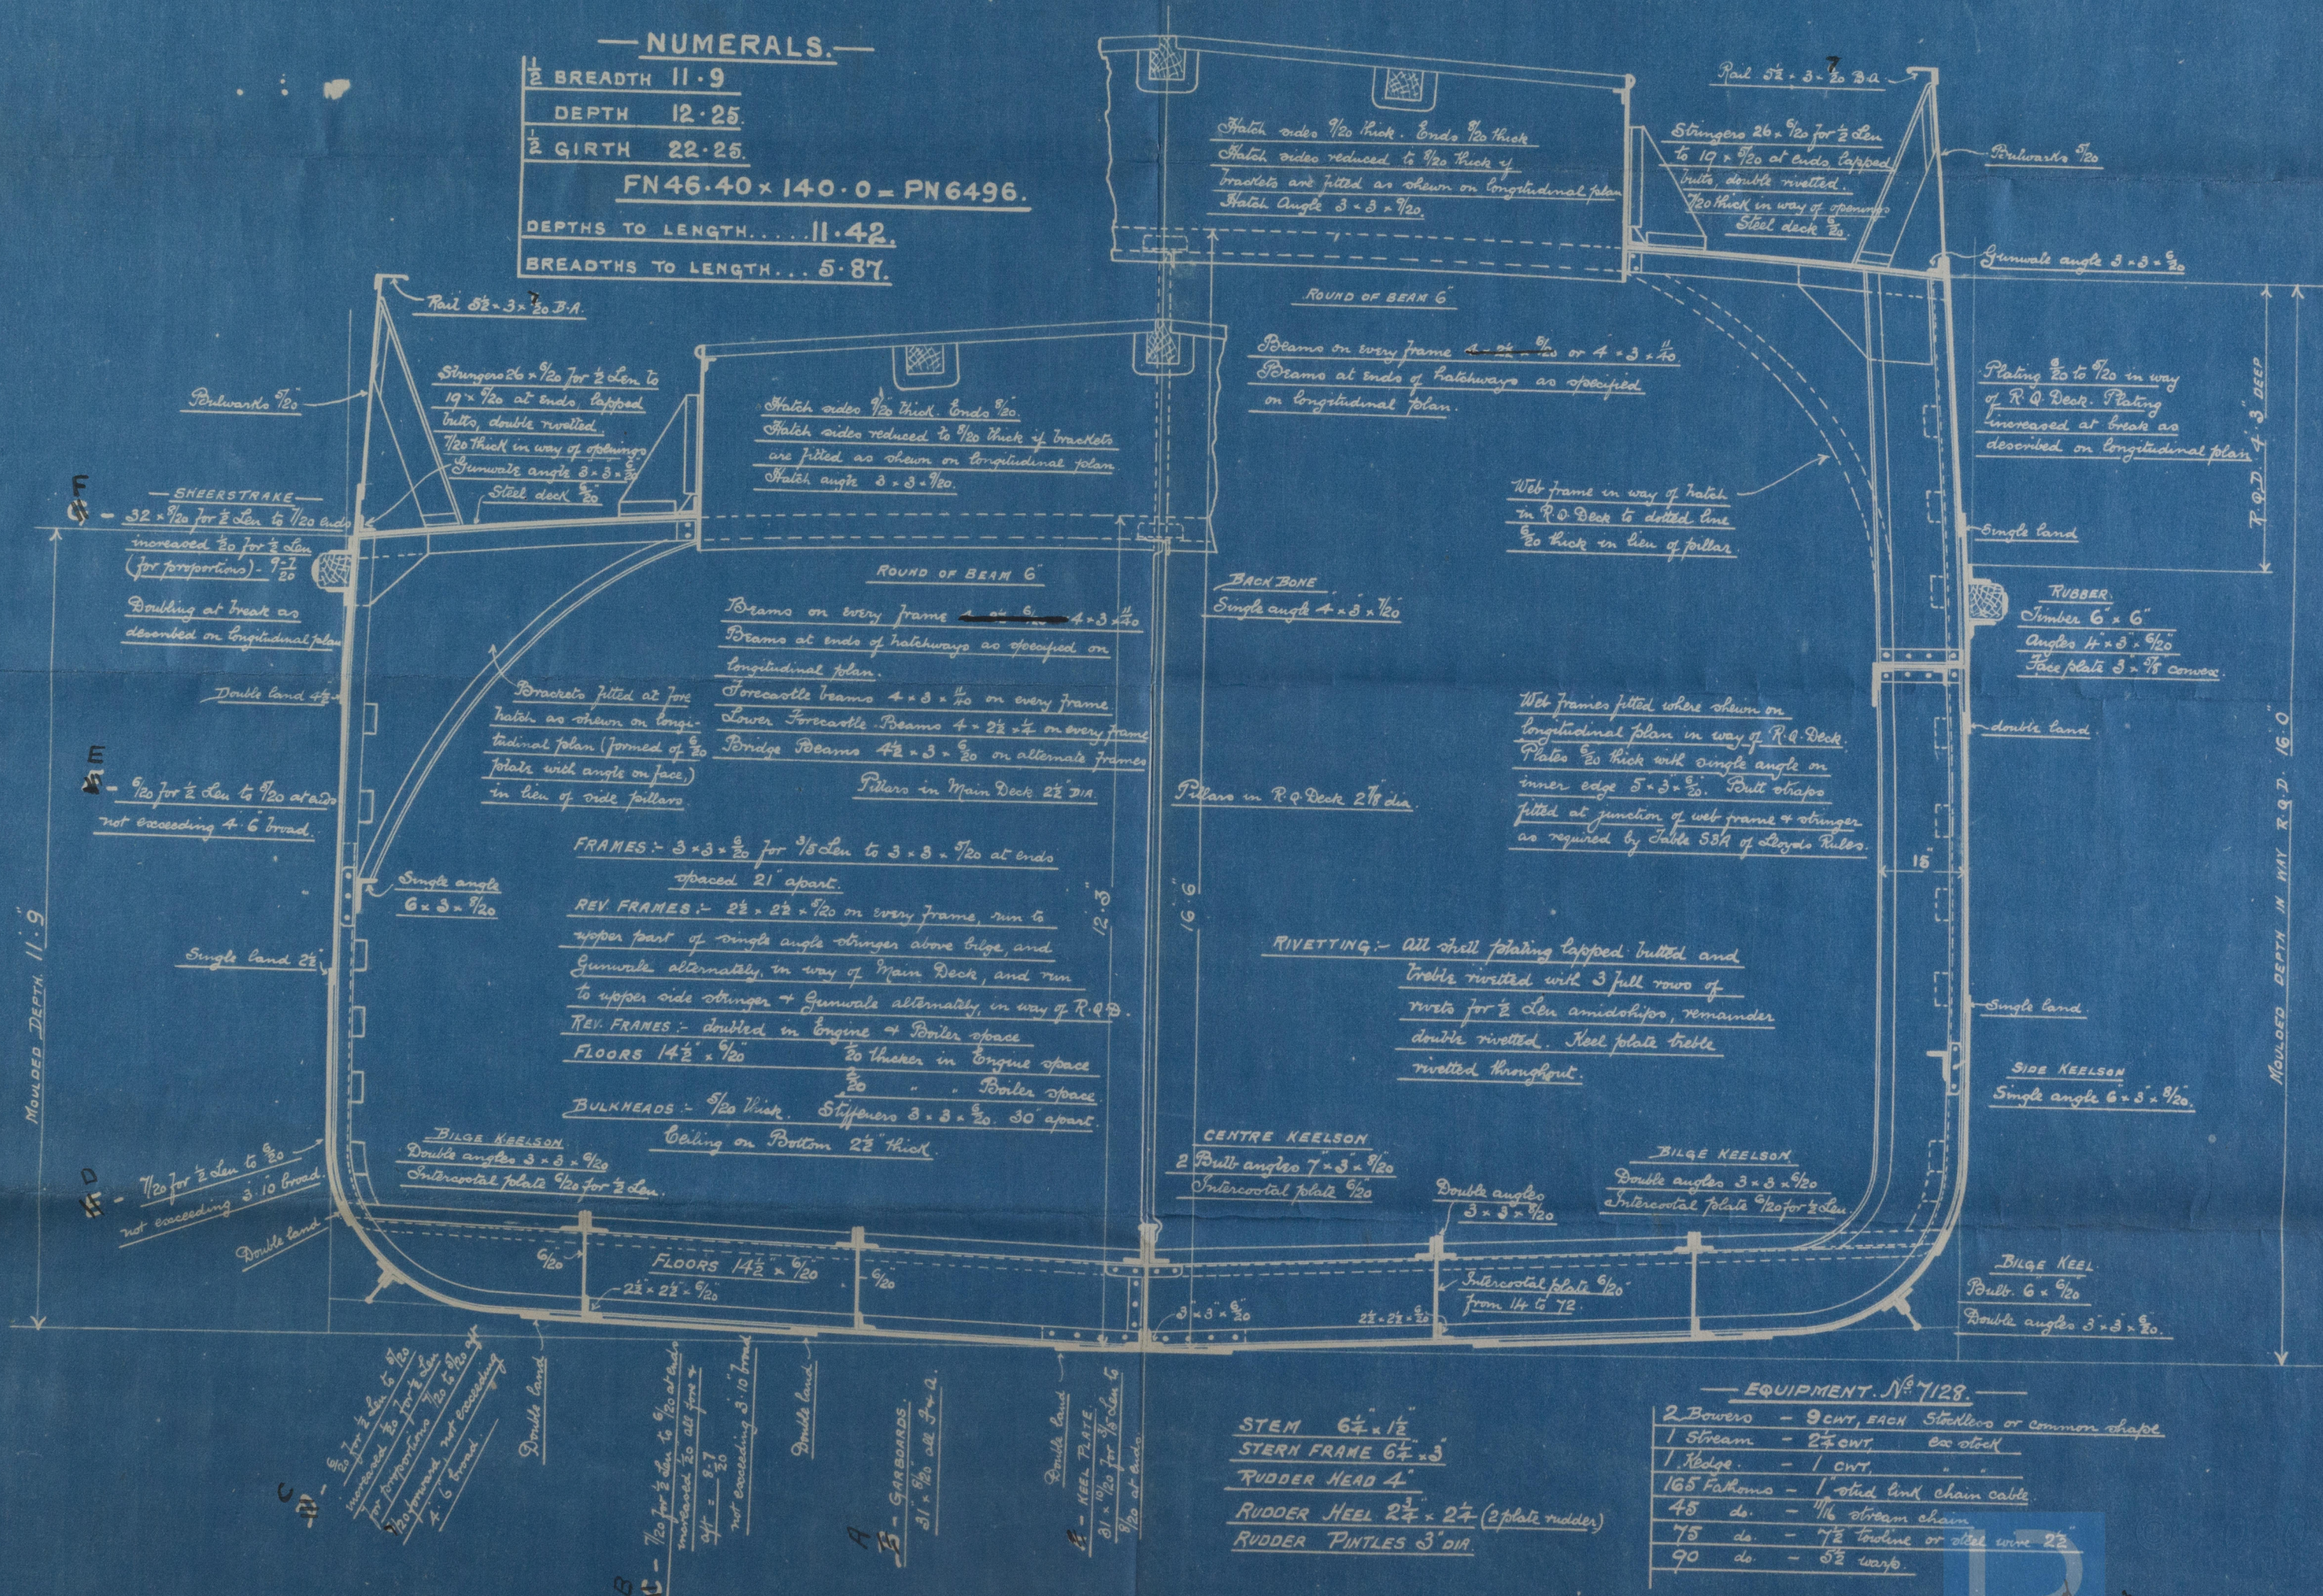

W203-0168

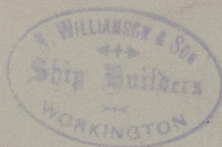

R. Williamson & Son

No. 193.

Midship Section

Nov Rpt 1294.



RETA



© 2020

Lloyd's Register
Foundation

W703-0168