

— S.S. N^o 773 —

18.2.05

— LLOYDS NUMERALS —
 1/2 GIRTH 19.42
 1/2 BREADTH 10.67
 WHOLE DEPTH 10.45
 1ST N^o 40.54
 LENGTH 118.60
 2ND N^o 4808.04

$$\frac{L}{B} = 5.6 \quad \frac{L}{D} = 11.3$$

MIDSHIP SECTION OF A STEEL SCREW STEAMER. — TO CLASS 100A1 AT LLOYDS. —

— DIMENSIONS —

LENGTH B.P. 120'-0"
 BREADTH EXT. 21'-6"
 DEPTH MLD. 10'-0"

— SCALE 1/2" = ONE FOOT. —

— EQUIPMENT N^o = 5398.59 —

1 BOWER 6 1/4 CWTs. (Stockless)

1 STREAM 1 3/4 " (Ex. Stock)


1 KEDGE 3/4 " " "
 135 FMS. 13/16 STUD LINK CHAIN CABLE.

75 " 2 1/2 WIRE.

90 " 4" MANILLA

75 " 3 " "

2 AT 30 FMS 3" FLEXIBLE STEEL HAWSER.

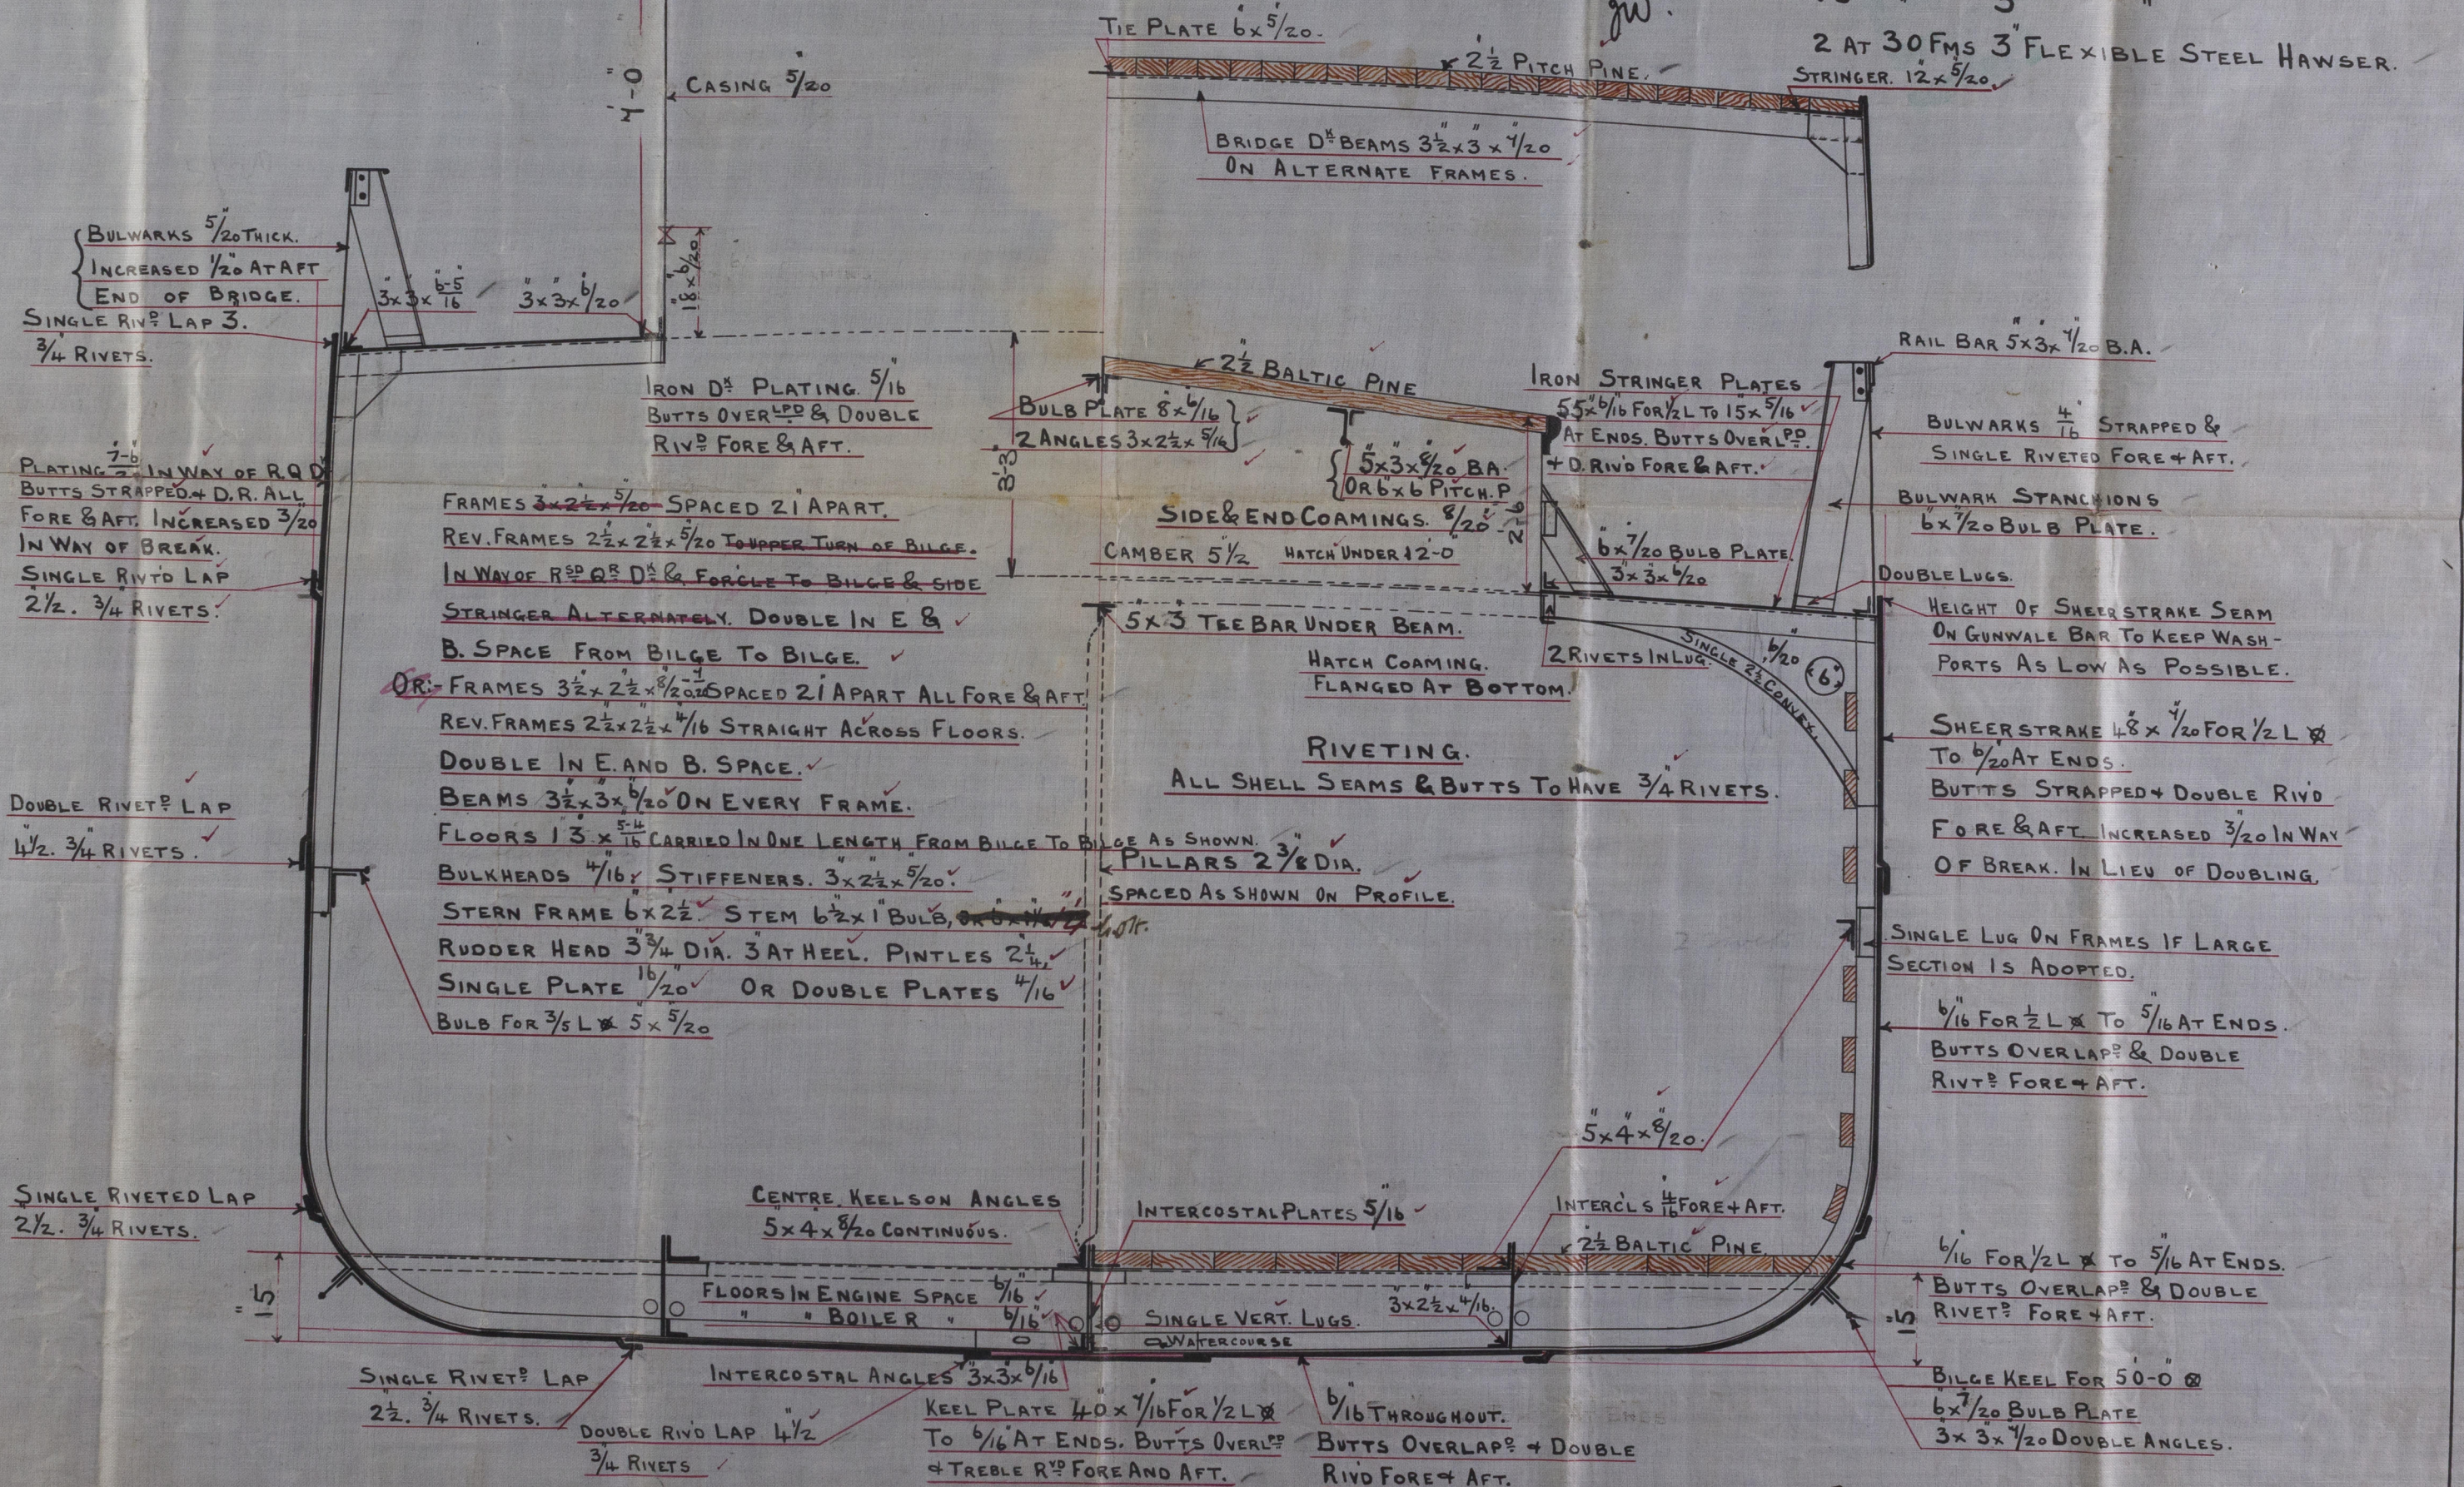

C.B.
 18.2.05

Rockside

SMITHS DOCK CO L^d

No 773

MIDSHIP SECTION

L. S. Lockside

Newcastle Report

No 49.312

© 2020

Lloyd's Register
Foundation

W703-0237