



ALTERNATIVE ARRANGEMENT OF DOUBLE BOTTOM. *with floors to ev 2nd frame.*

N^o 346. SCALE 1:25.

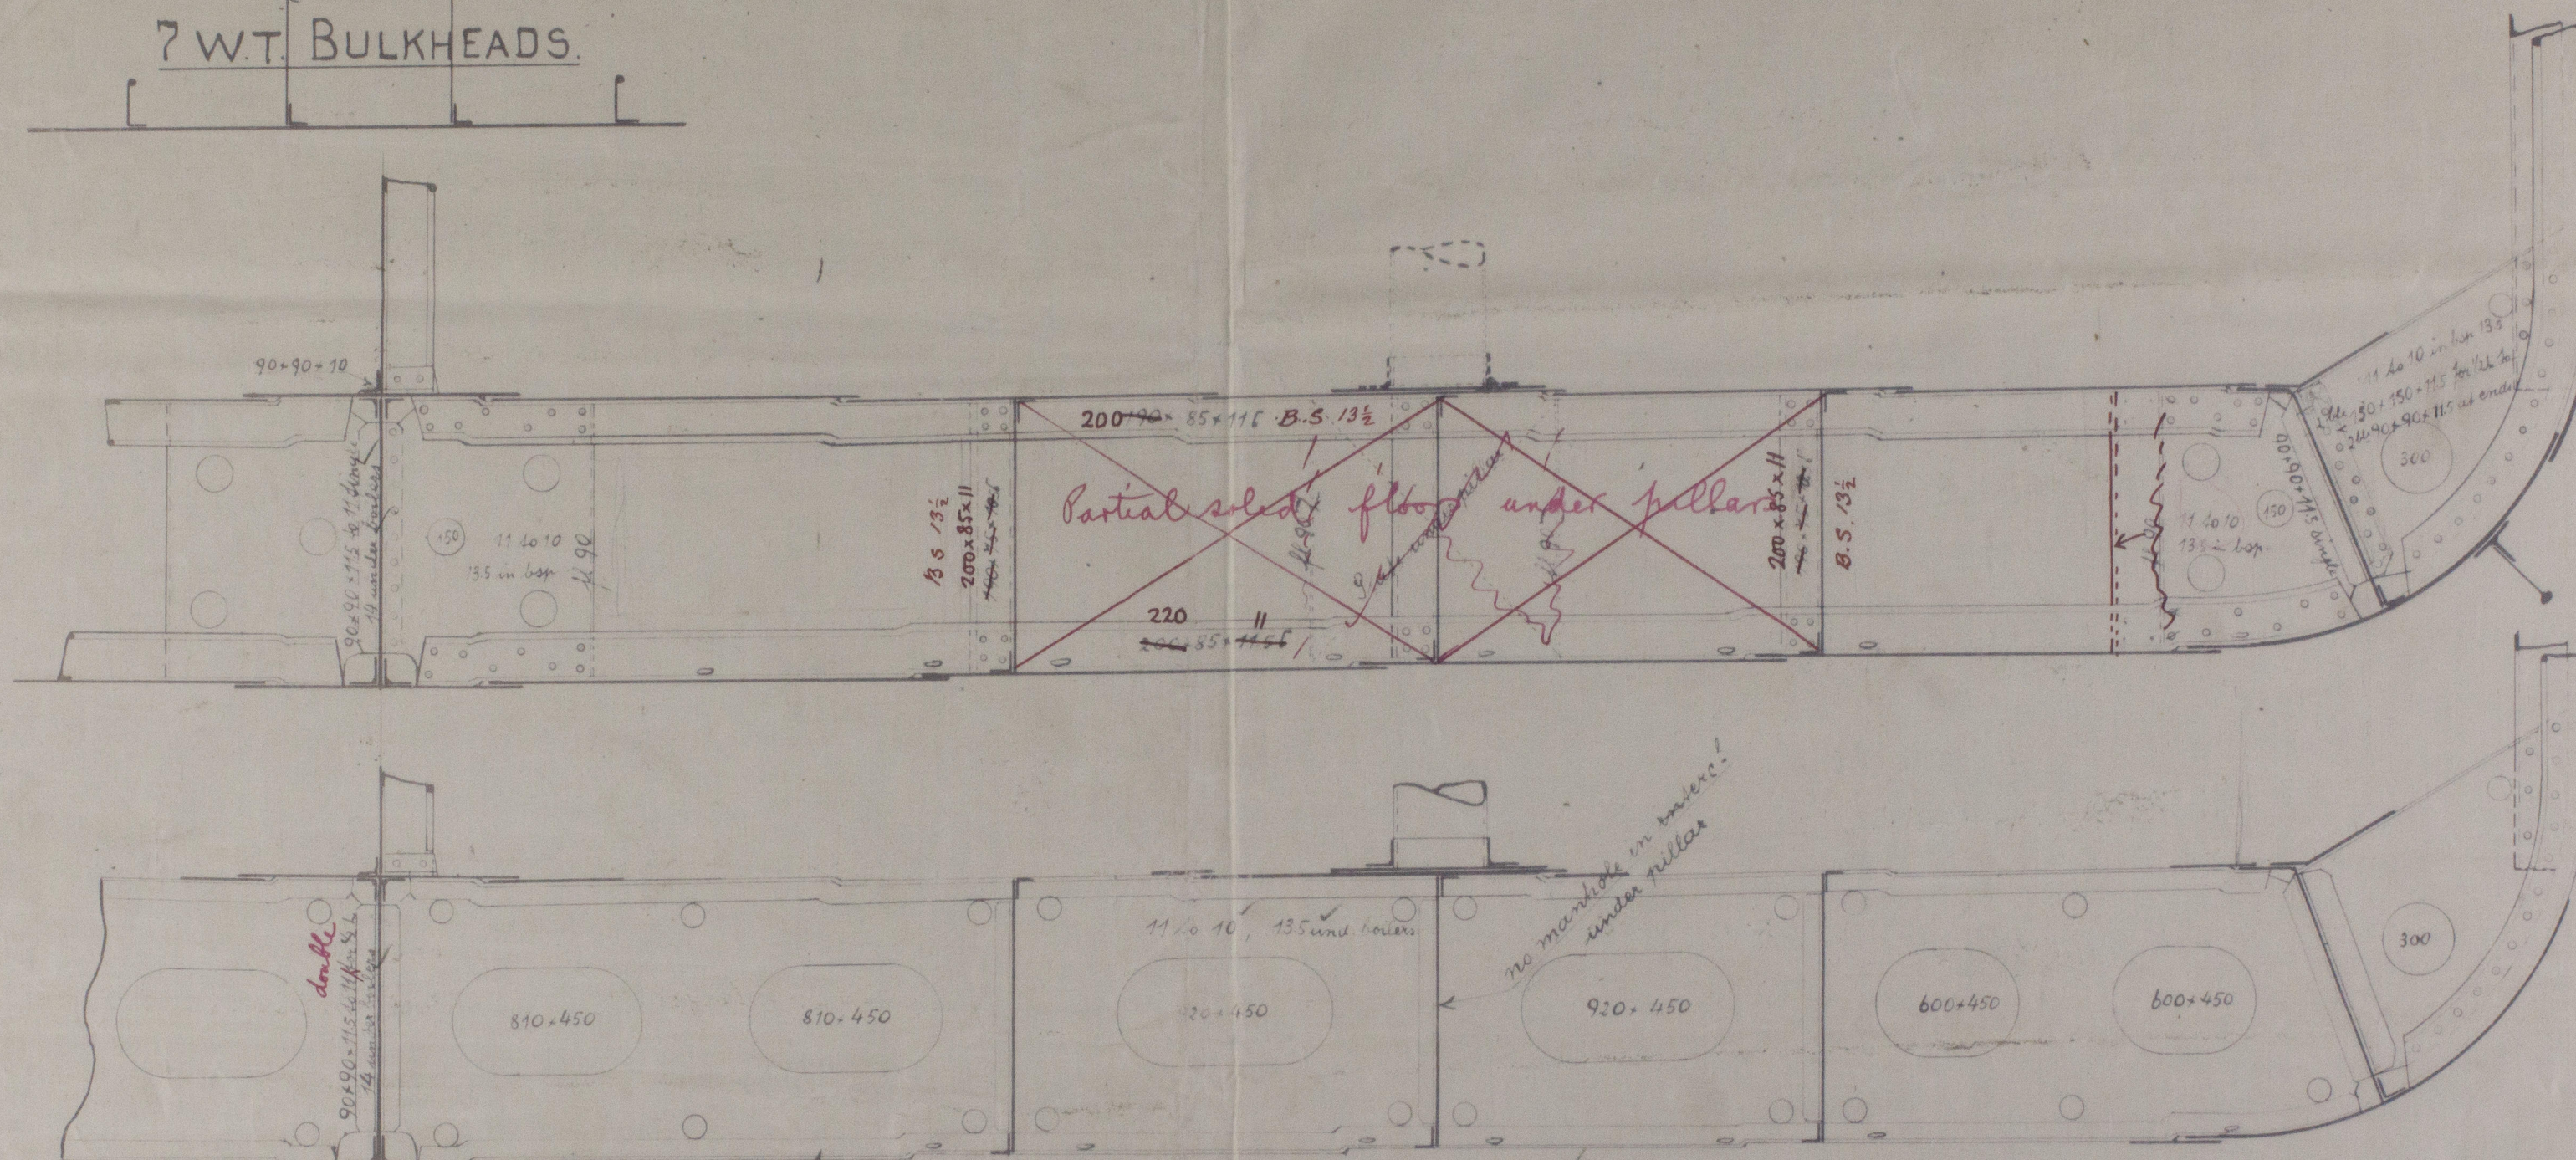

NOTE: Solid floors to ev 2nd frame, at ev frame under engine space and for 1/5 L from forward. also solid floor under w.t. bds and under boiler bearers!

C.F.
18.5.14

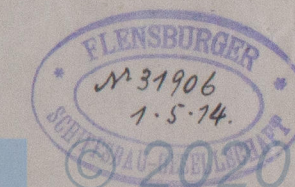

Lloyd's Register
Foundation
W704-0230