

18.5-14


LONGITUDINAL ARRANGEMENT SCALE 1:100

470'-0" OUTS. SS x 61'-10" x 28'-1" DEPTH MLD UDR (2ND DR)

Arrangement with floors to every 2nd frame!

This sketch approved ^{only} for arrangement of floors in double bottom

Remove frames 100 x 75 x 12 x shown proposed position
in lieu of mols. in Lower dth

 


Blensburg No 346

Longitudinal plan &
attached sketch of skeleton floors

Ham. letter 3. 5. 14

Rudelsburg

4

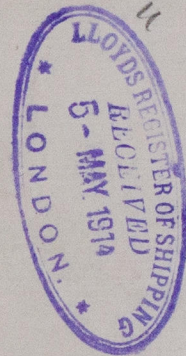

4 18. 2. 21

RECEIVED



© 2020

Lloyd's Register
Foundation