


N^o 526

11.7.01 - MIDSHIP SECTION -


- DIMS. 135'0" x 22'4" M^{LD} x 13'4" MOULDED -

- STEEL CLASS 100A.1. FOR FISHING PURPOSES. -

$\frac{1}{2}$ = ONE FOOT. -

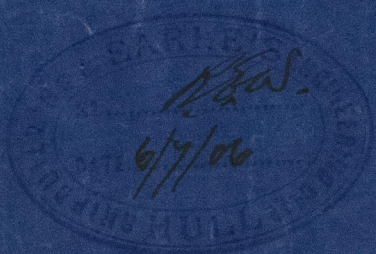

$\frac{1}{2}$ GIRTH = 20.70 ✓
 $\frac{1}{2}$ BREADTH = 11.17 ✓
DEPTH = 13.83 ✓
45.70 ✓
133.792 = LENGTH
9.40 ✓
41.130 ✓
31990 ✓
13710 ✓
13710 ✓
4570 ✓
6114.2940 = 2ND NO
6114.2940 ✓
 $\frac{1}{8}$ = 5.9 $\frac{1}{10}$ = 9.7

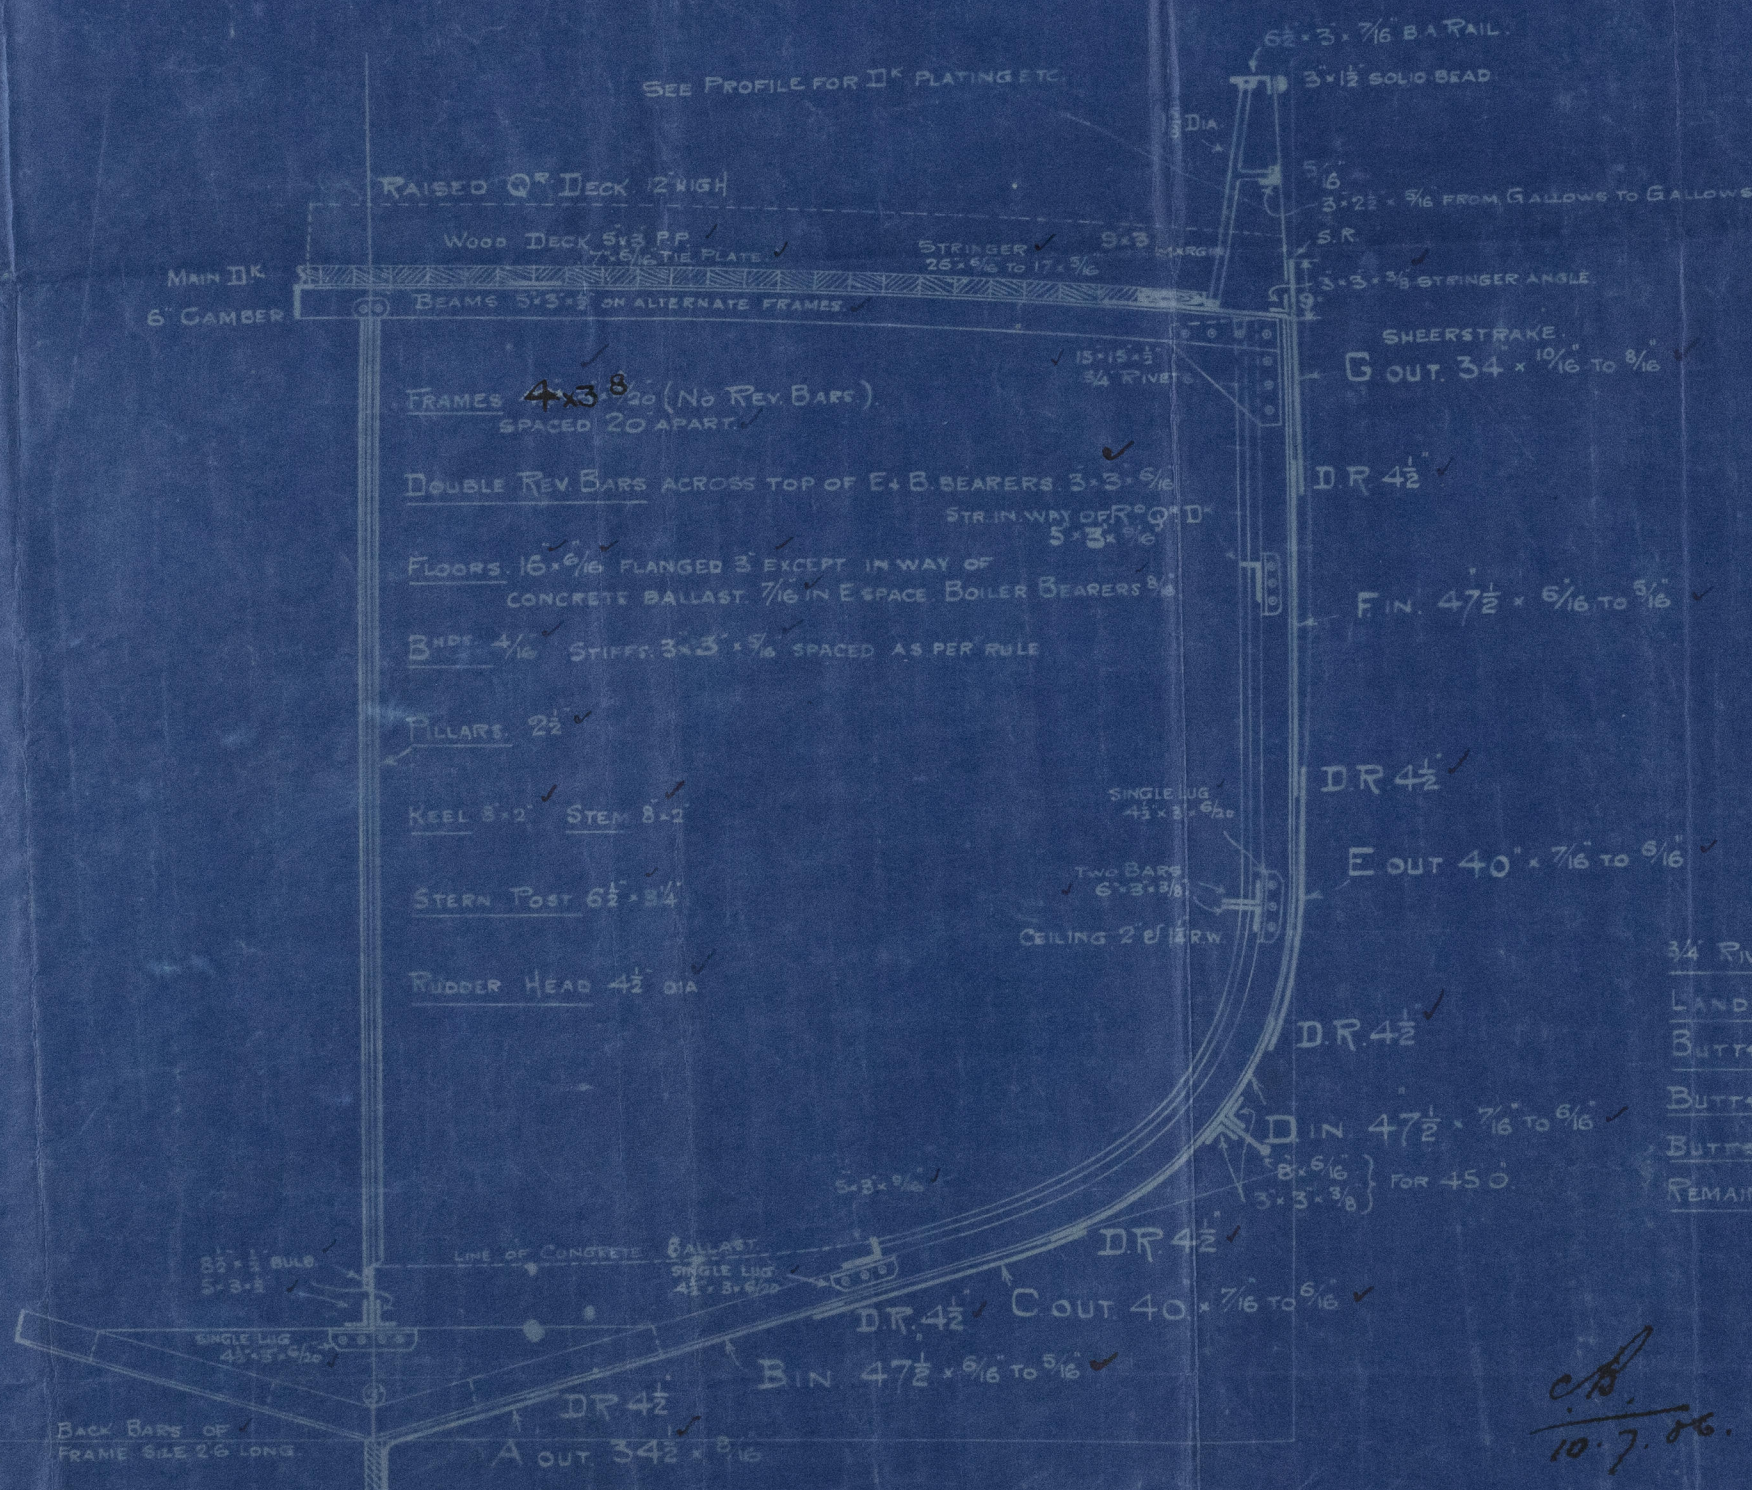

EQUIPMENT

ONE ANCHOR 6 CENTS EX STOCK

" " 5 1/2" " " "

" " 3" " " "

120 FATHOMS 1 1/2" CABLE SHORT LINK

60 " 6" HAWSER

60 " 5" WARP

RIVETING

3/4 RIVETS THROUGHOUT FOR SHELL

LANDINGS D.R. 4 1/2"

BUTTS OF STE. PLATE D.R. 5/8" 4 1/4" WIDE

BUTTS OF SHEER STRAKE STRAPPED D.R. 3/4" 1 1/2" 3/4 RIVETS

BUTTS OF BARS STRAKES STRAPPED D.R. 3/4" 1 1/2" 3/4 RIVETS

REMAINDER OF SHELL BUTTS LAPPED D.R.

C.B.
10.7.06.




Lloyd's Register Foundation

Charles S. & Co.




No. 526.

Midship Section

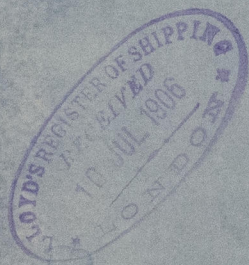

s/s "Venture"

Hull Report No. 18580

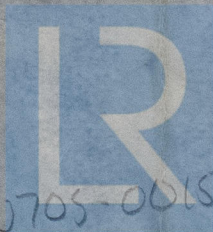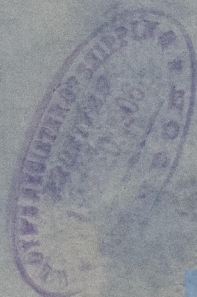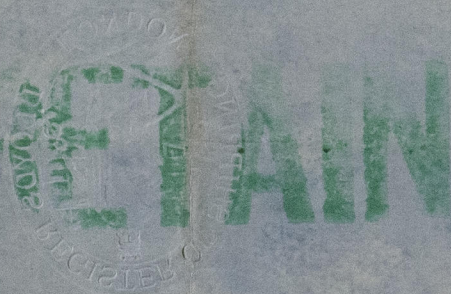

W705-0015

© 2021

Lloyd's Register
Foundation