

JOHN FULLERTON & CO. PAISLEY.


PLAN N° 603 ----

S.S. 'MOYALLON'


S.S.C.I. TYPE. YARD N° 262

142'-0" x 25'-0" x 12'-7" MOULDED TO MAIN DECK.

SCALE 1/4" = ONE FOOT.

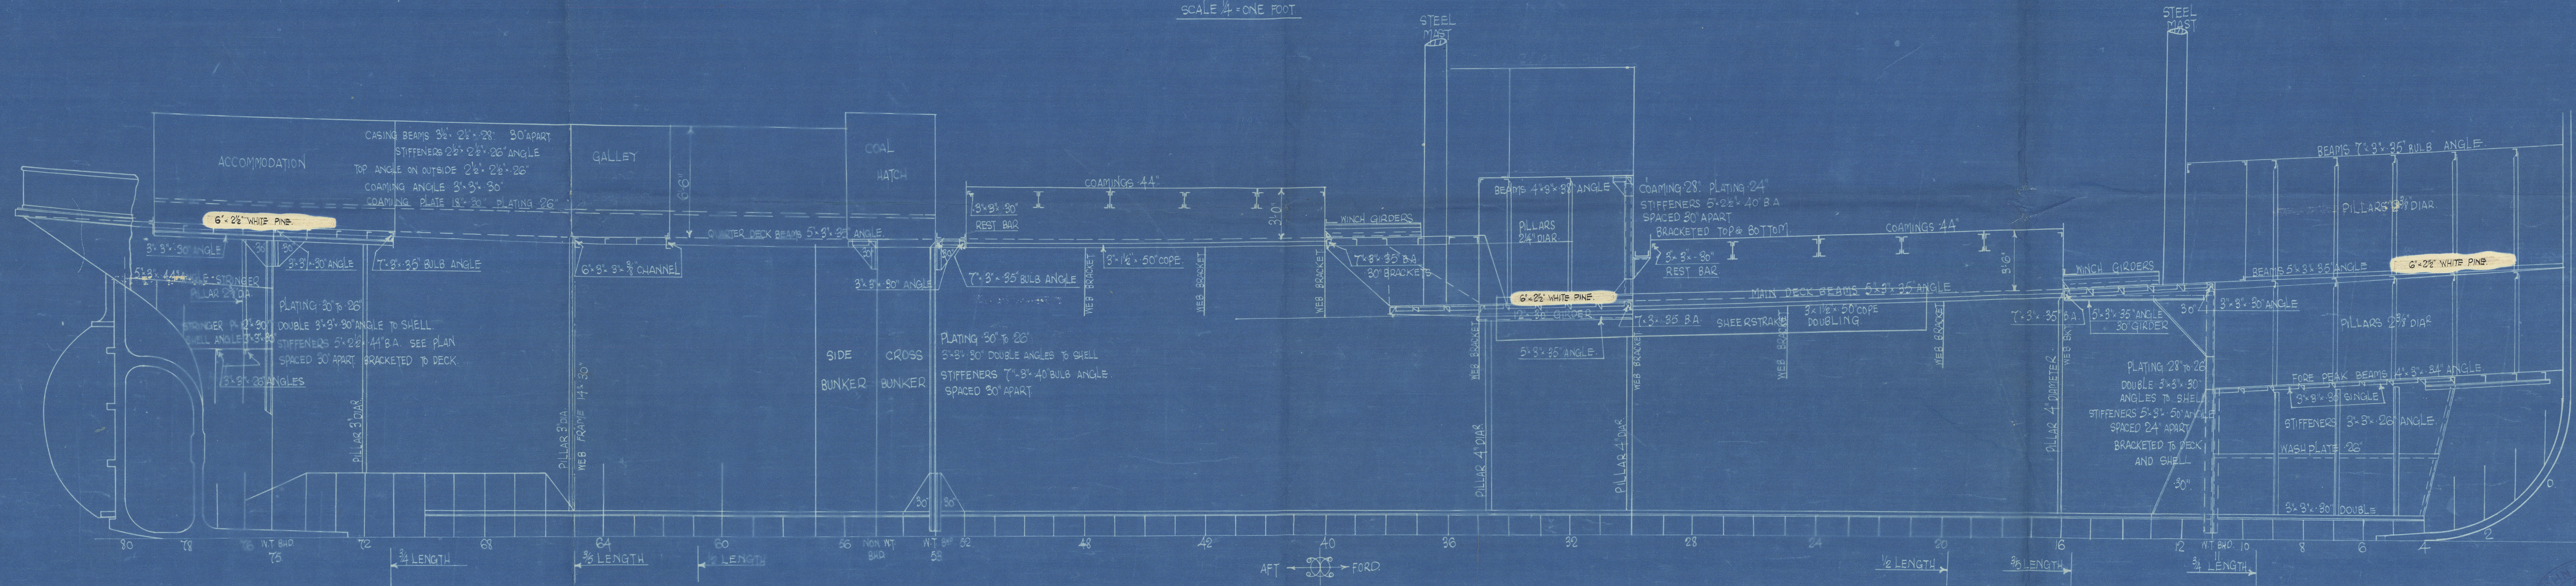

SEE SEPARATE PLAN OF STRENGTHENING FORWARD

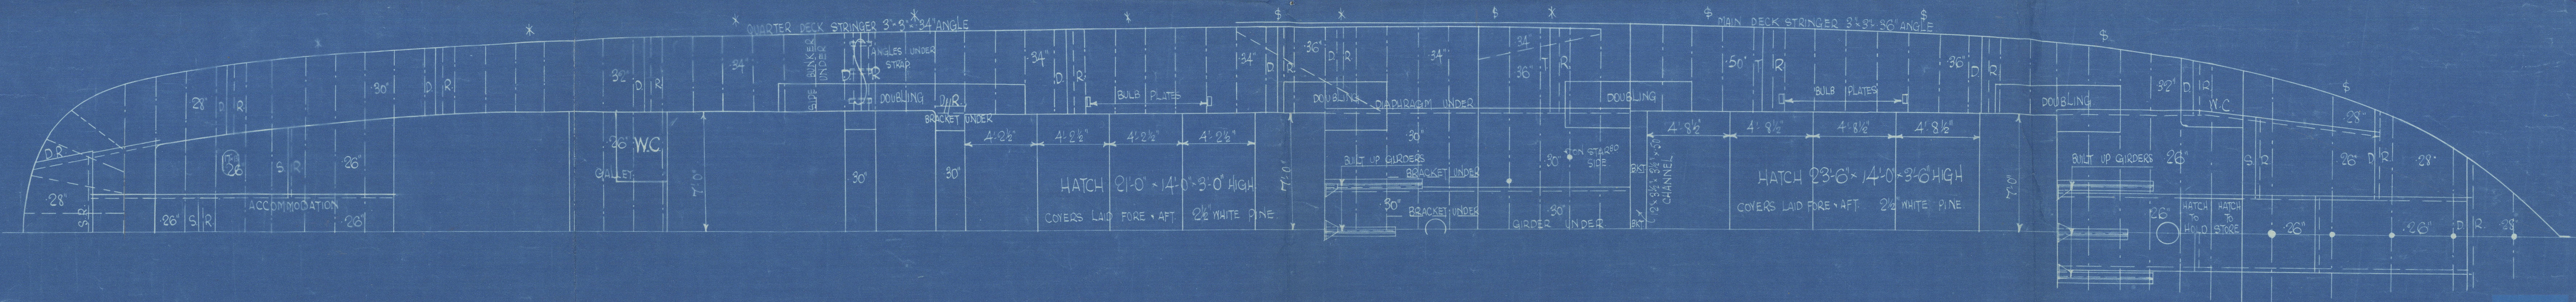

BUILDERS.

*J. Fullerton 16 to 15th
Paisley.*

YARD NO.

262.

PLAN.

Profile of Deck.



SHIP'S NAME,

St Moyaillon

GLASGOW REPORT NO

38865



© 2020

Lloyd's Register
Foundation

W706-0028