

7/1/18


DIMENSIONS: 142'-0" x 25'-0" x 12'-7" M.H.P.

Scale $\frac{1}{2}'' = \text{One Foot}$

TO BE CLASSED 100 A.I. AT LLOYDS AND TO BE BUILT UNDER SPECIAL SURVEY.

RAISED Q ^R DECK	78'75" × 4'0" ABOVE MAIN DECK ✓	Q ^R DECK	5336.36 315.00	TRANSVERSE N ^o (B+D) = 37'58"	Q ^R TO MAIN DK = 11'33"
BRIDGE DECK	8'75" × 7'0" " " ✓	BRIDGE DK	45.34	LONGITUDINAL N ^o L(B+D) = 5336.36	Q ^R TO QUARTER DK = 15'33"
FORECASTLE DECK	22'0" × 7'0" " " ✓	FO ^R CLE DK	115.50	D IN L (Quarter Deck) = 8.5	
CASING	45'5" × 6'5" " Q ^R " ✓	CASING	147.87 5960.67	D IN L (Main Deck) = 11.2	

29-12-17


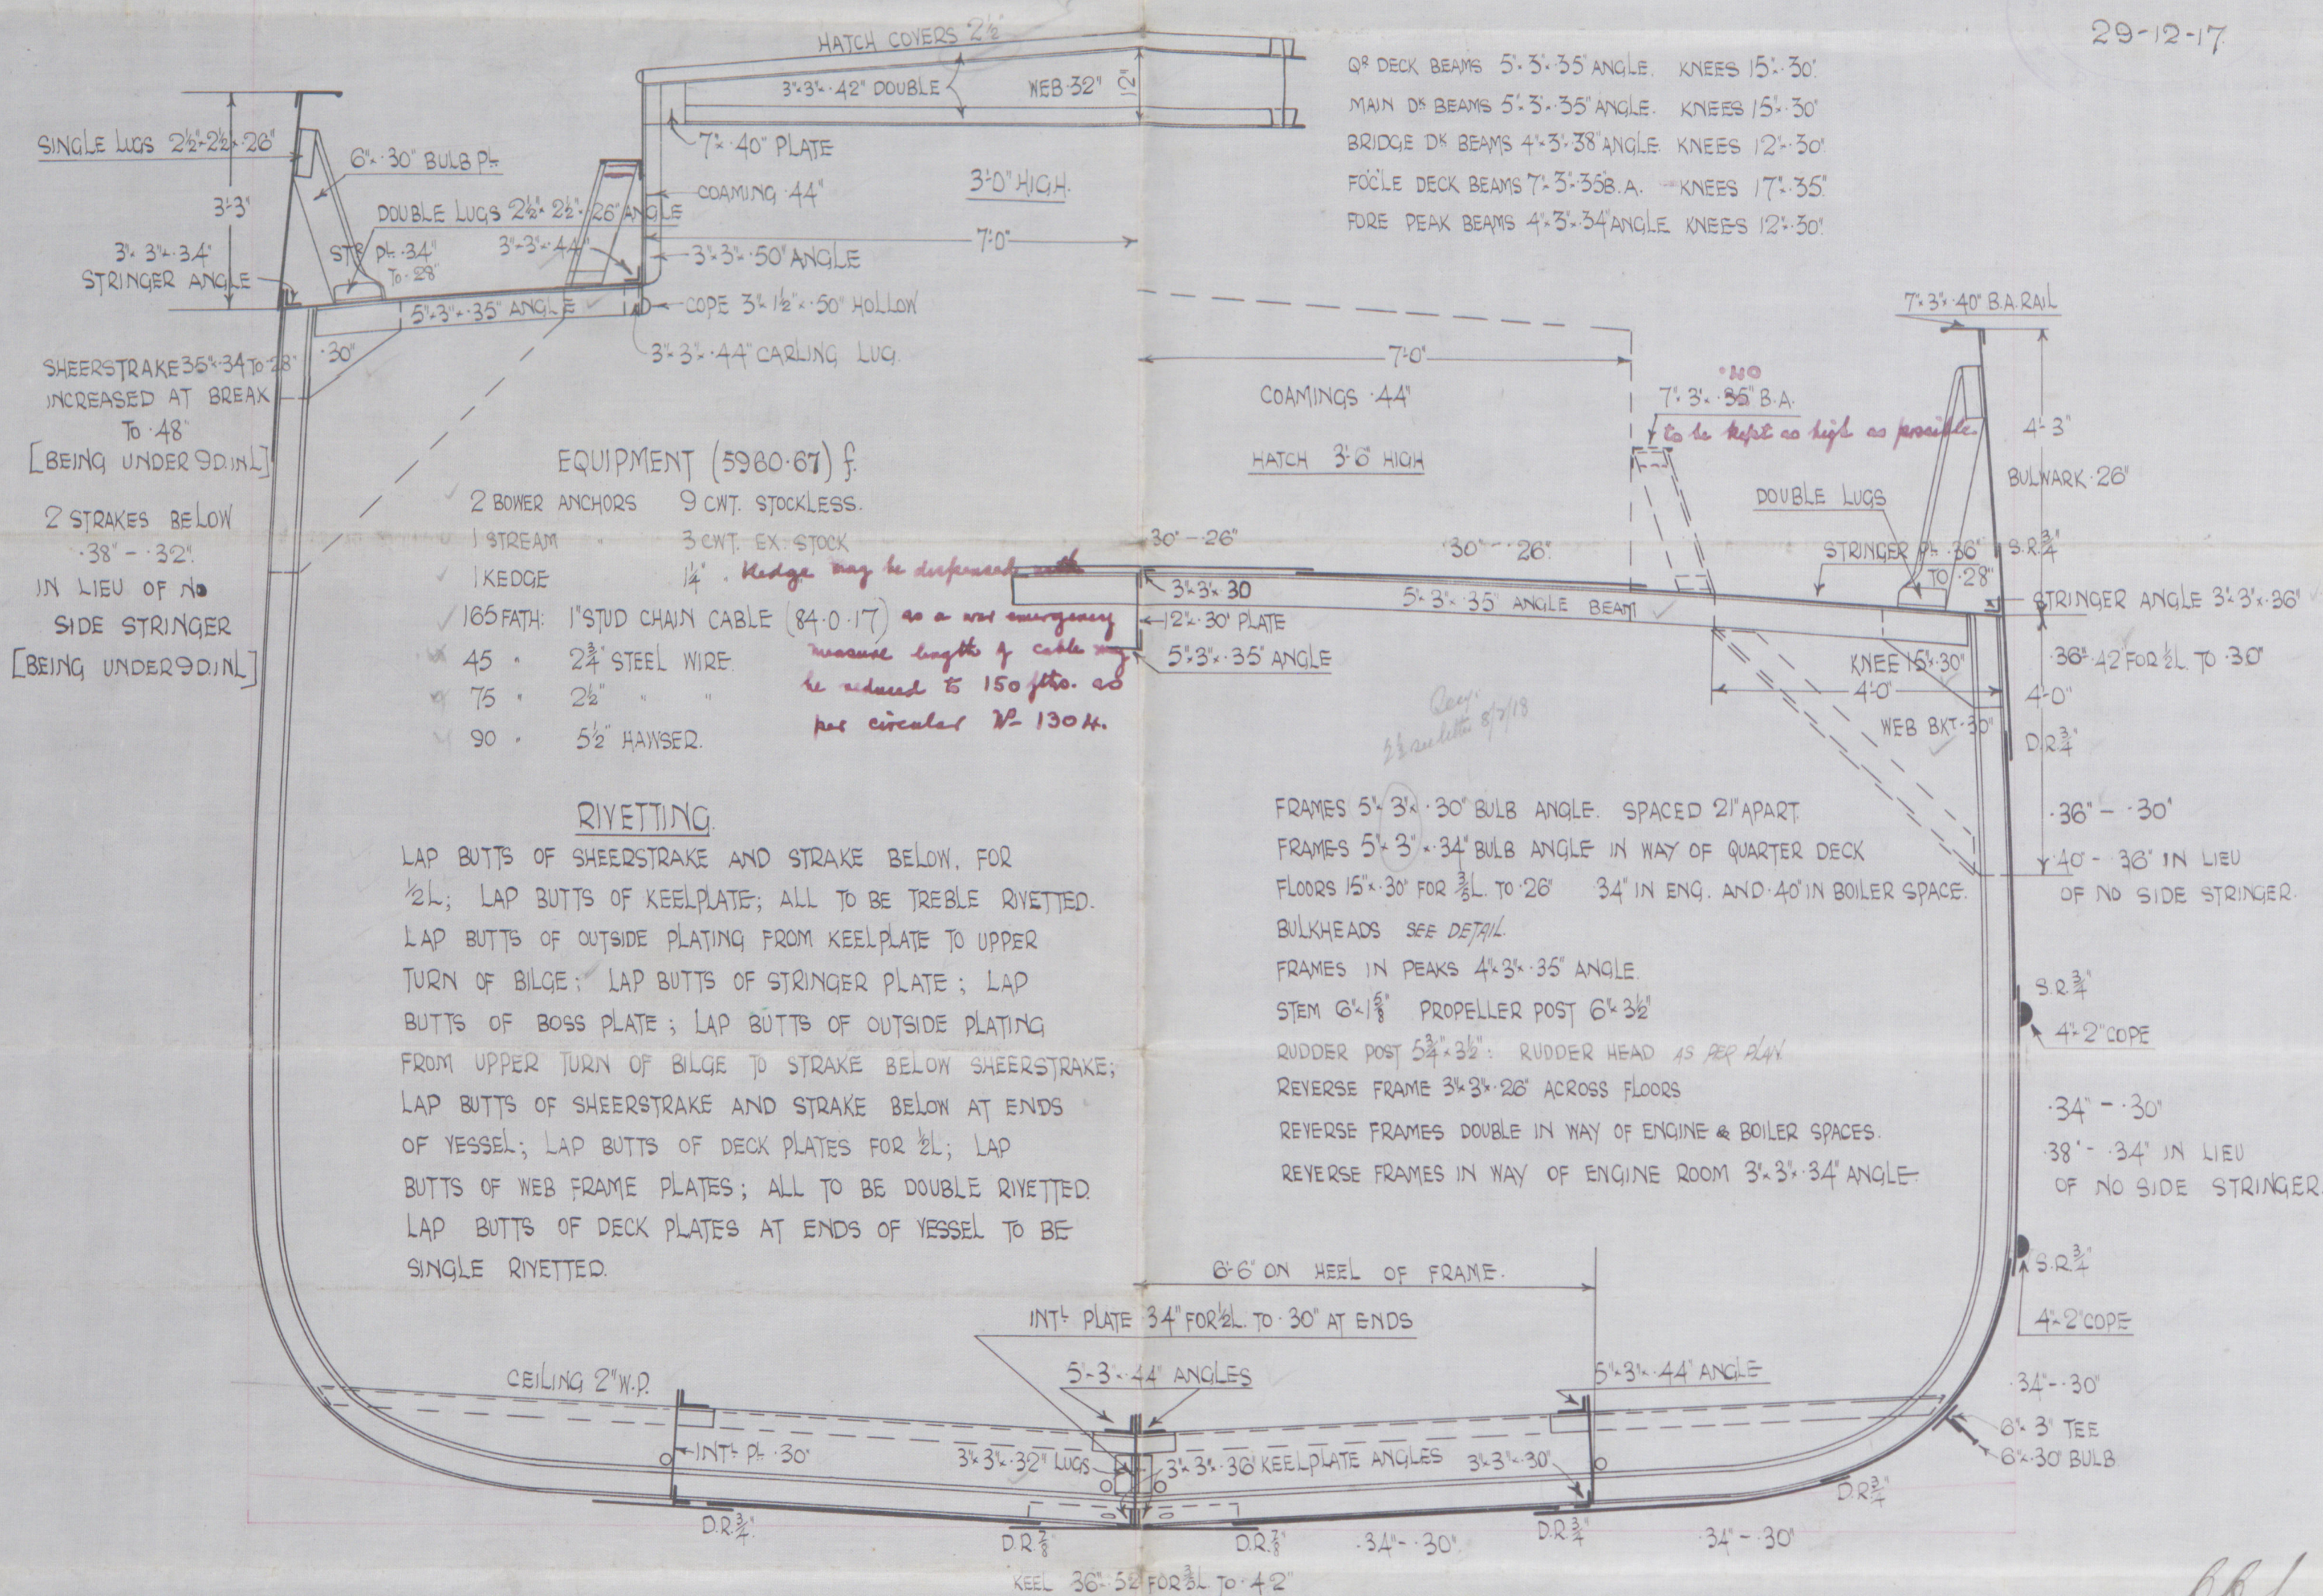


NOTE:- THE 3 STRAKES OF OUTSIDE PLATING, NEXT THE KEEL ARE TO HAVE THE MIDSHIP THICKNESS MAINTAINED TO THE RULE POSITION OF COLLISION BULKHEAD.

THE THREE LANDINGS ON BOTTOM FOR² TO HAVE AN
EXTRA RIVET BETWEEN THE FRAMES FROM 6 TO 16

BB/
5. 1. 18.

Recd.
2/1/18

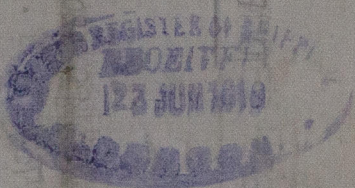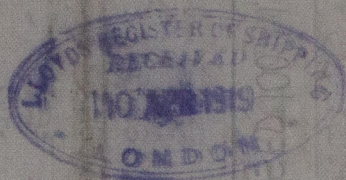

RECEIVED

FORECASTLE DECK

BRIDGE DECK

WHEEL OF DECK

WHEEL OF DECK

FORECASTLE DECK

BRIDGE DECK

WHEEL OF DECK



© 2020

Lloyd's Register Foundation

W706-0020