
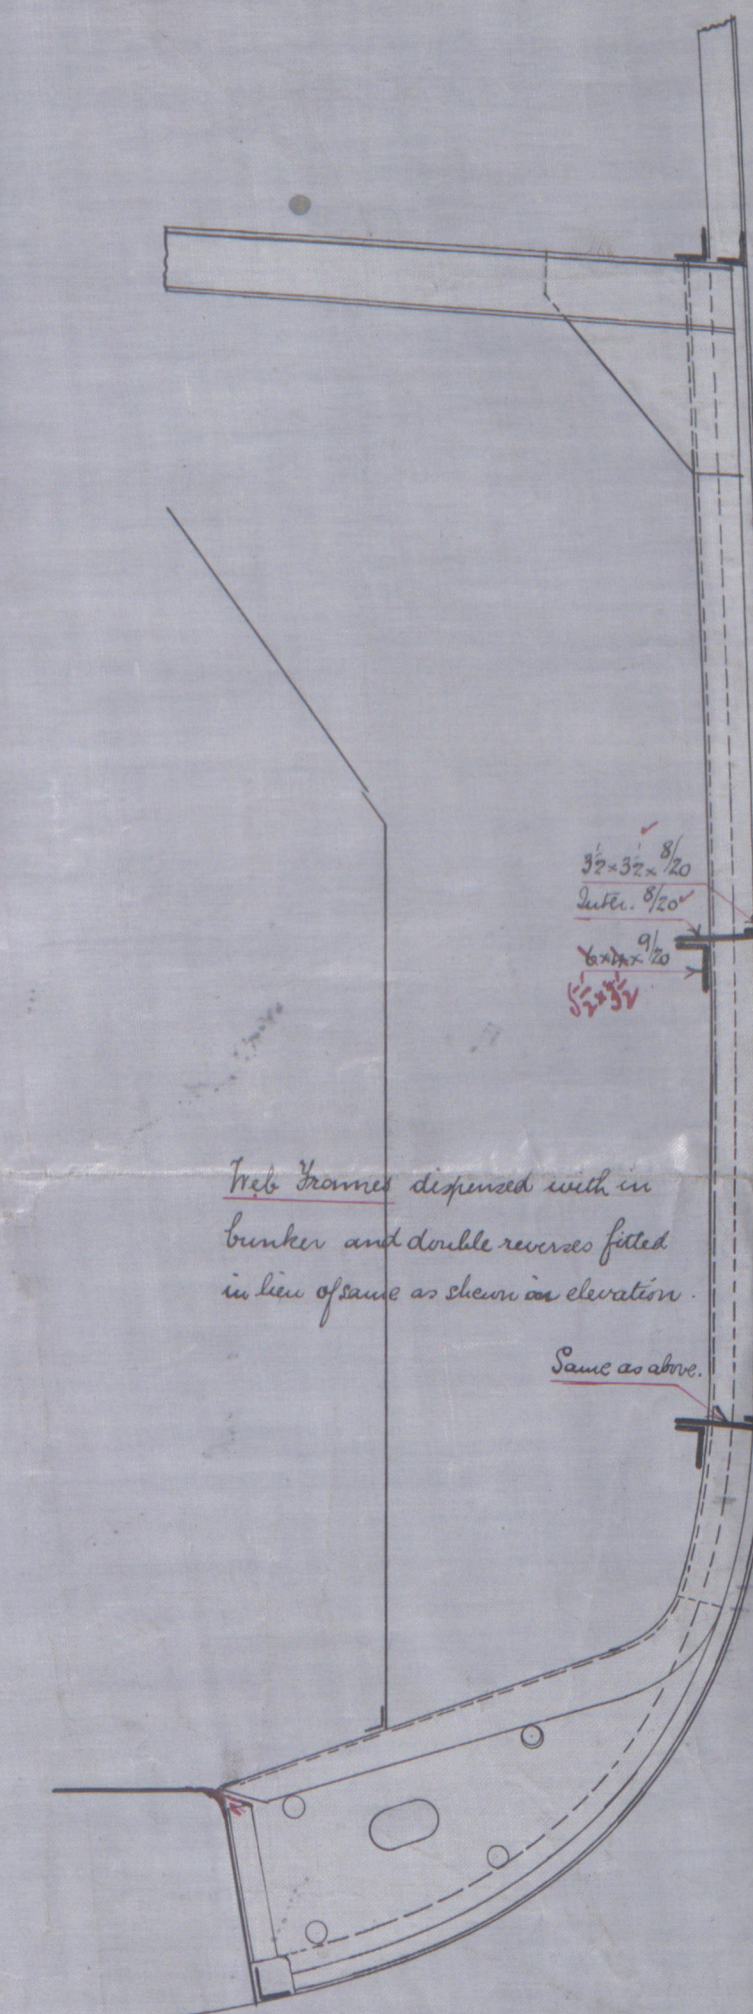


8-1-05
31-1-05
2-2-05
21-2-05
1-3-05

No 225.
— Longitudinal Section of Turbine Steamer 300' x 40' x 19' 1" Mch. —
— Scale 1/8" = one foot. —

Longitudinal Section of
Turbine Steamer
300' x 40' x 19' 1" Mch.
Scale 1/8" = one foot.
No 225

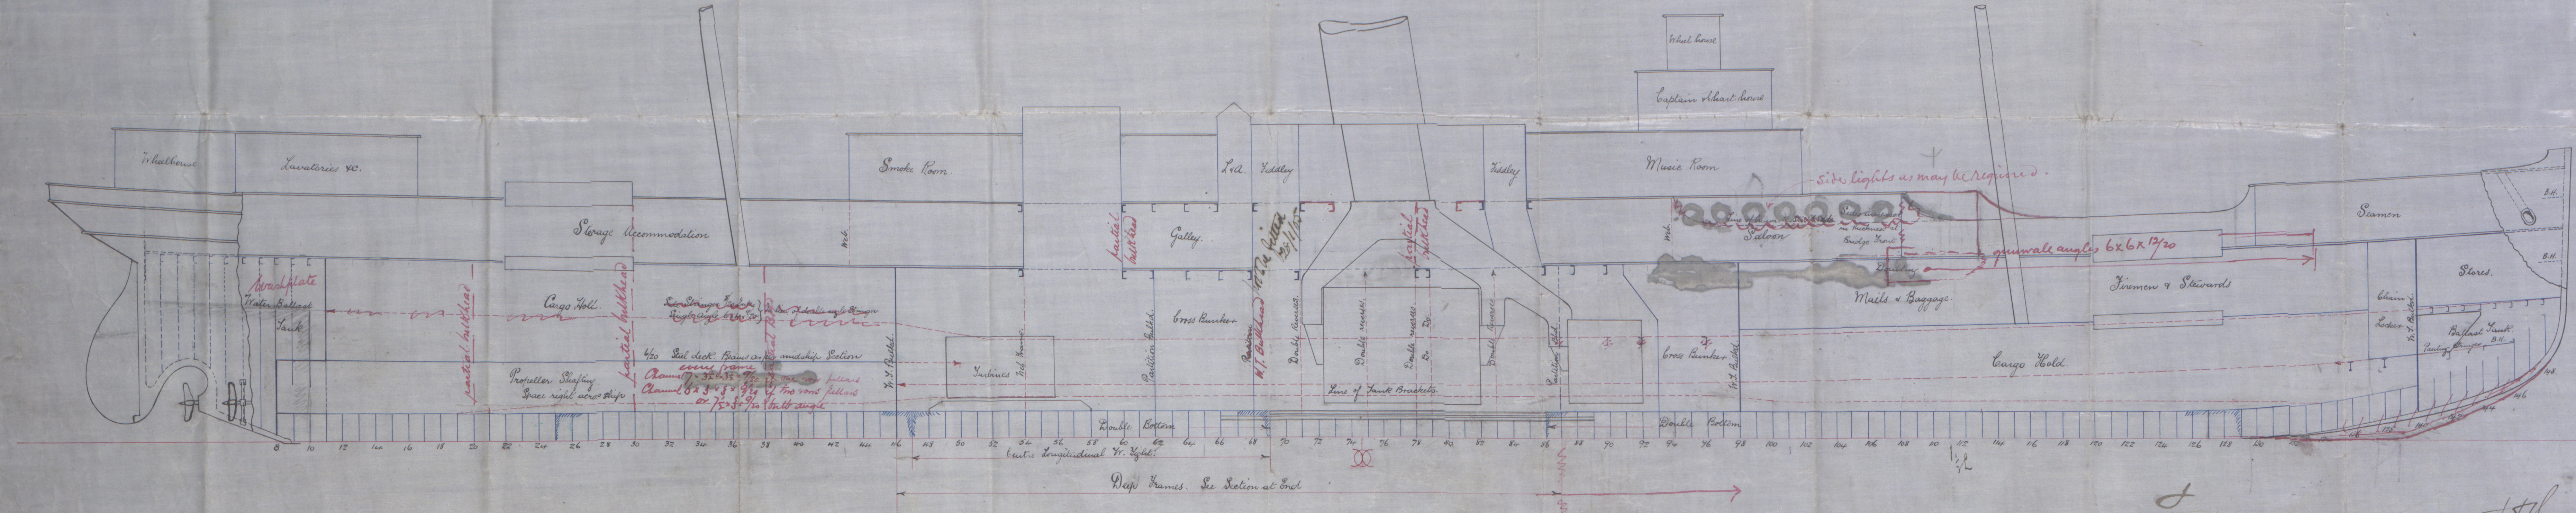

Section showing deep framing in E. & B. Spaces.
Scale 1/2" = 1 foot.

Messrs Workman Clark & Co
Turbine Steamer


300 x 40 x 19.1 Moulded

Jara No 225

Profile

Ringera

Rel boat

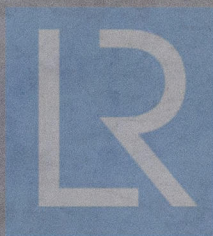

© 2021

Lloyd's Register
Foundation

W707-0204