


— LONGITUDINAL SECTION No 225 T.S.S. —

SCALE 1/8" = 1 FOOT.



E.F.M.
5/12/05

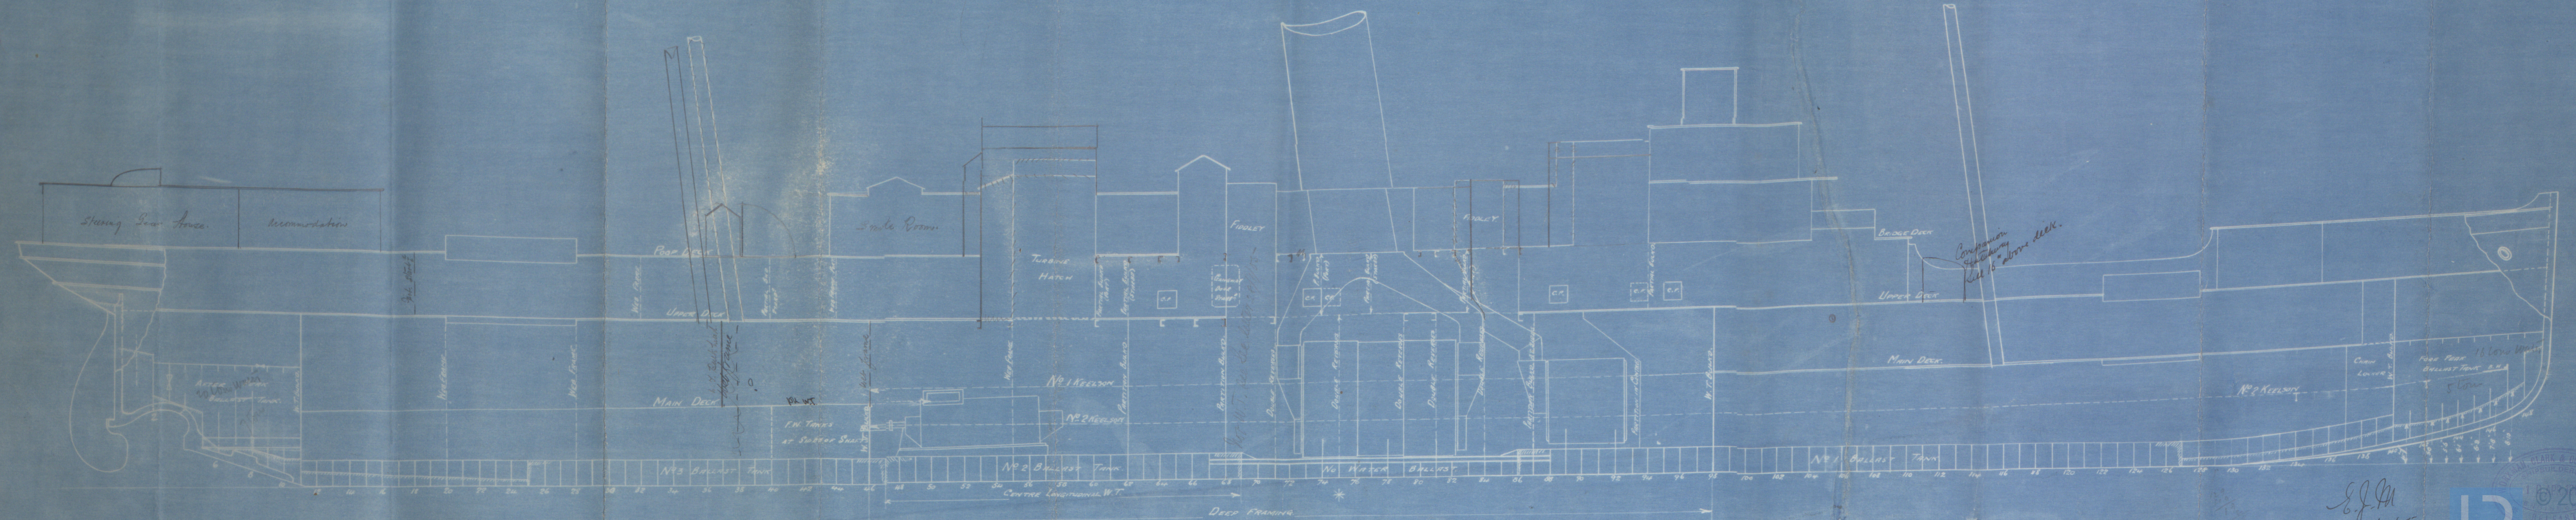


0209

Workman Class

Tubing 5.3

225

Propeller as built

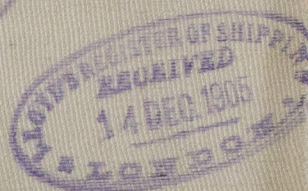

BINGERA

BEL 6001



© 2021

Lloyd's Register
Foundation

W707-0209

20
Lloyd's Register
2021



© 2021

Lloyd's Register
Foundation