
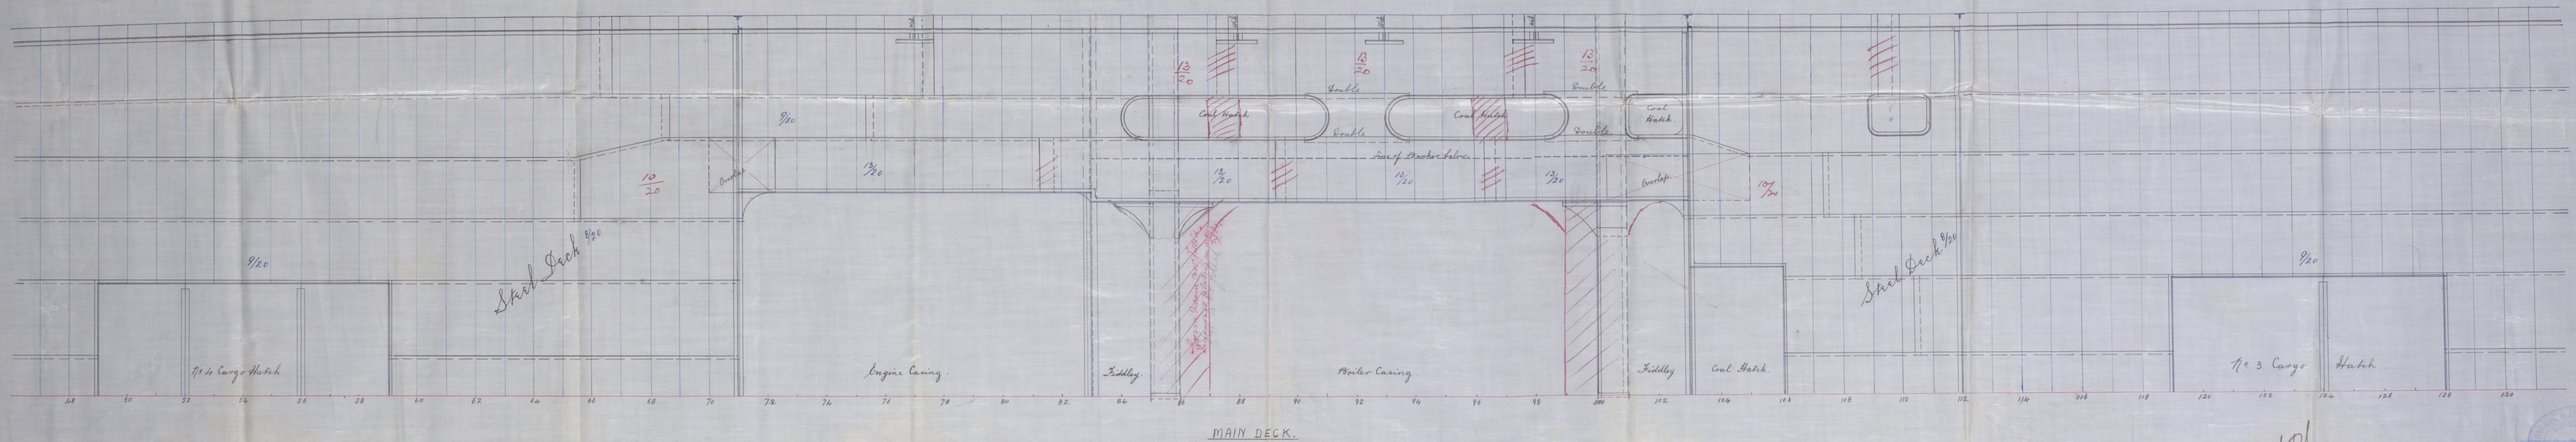
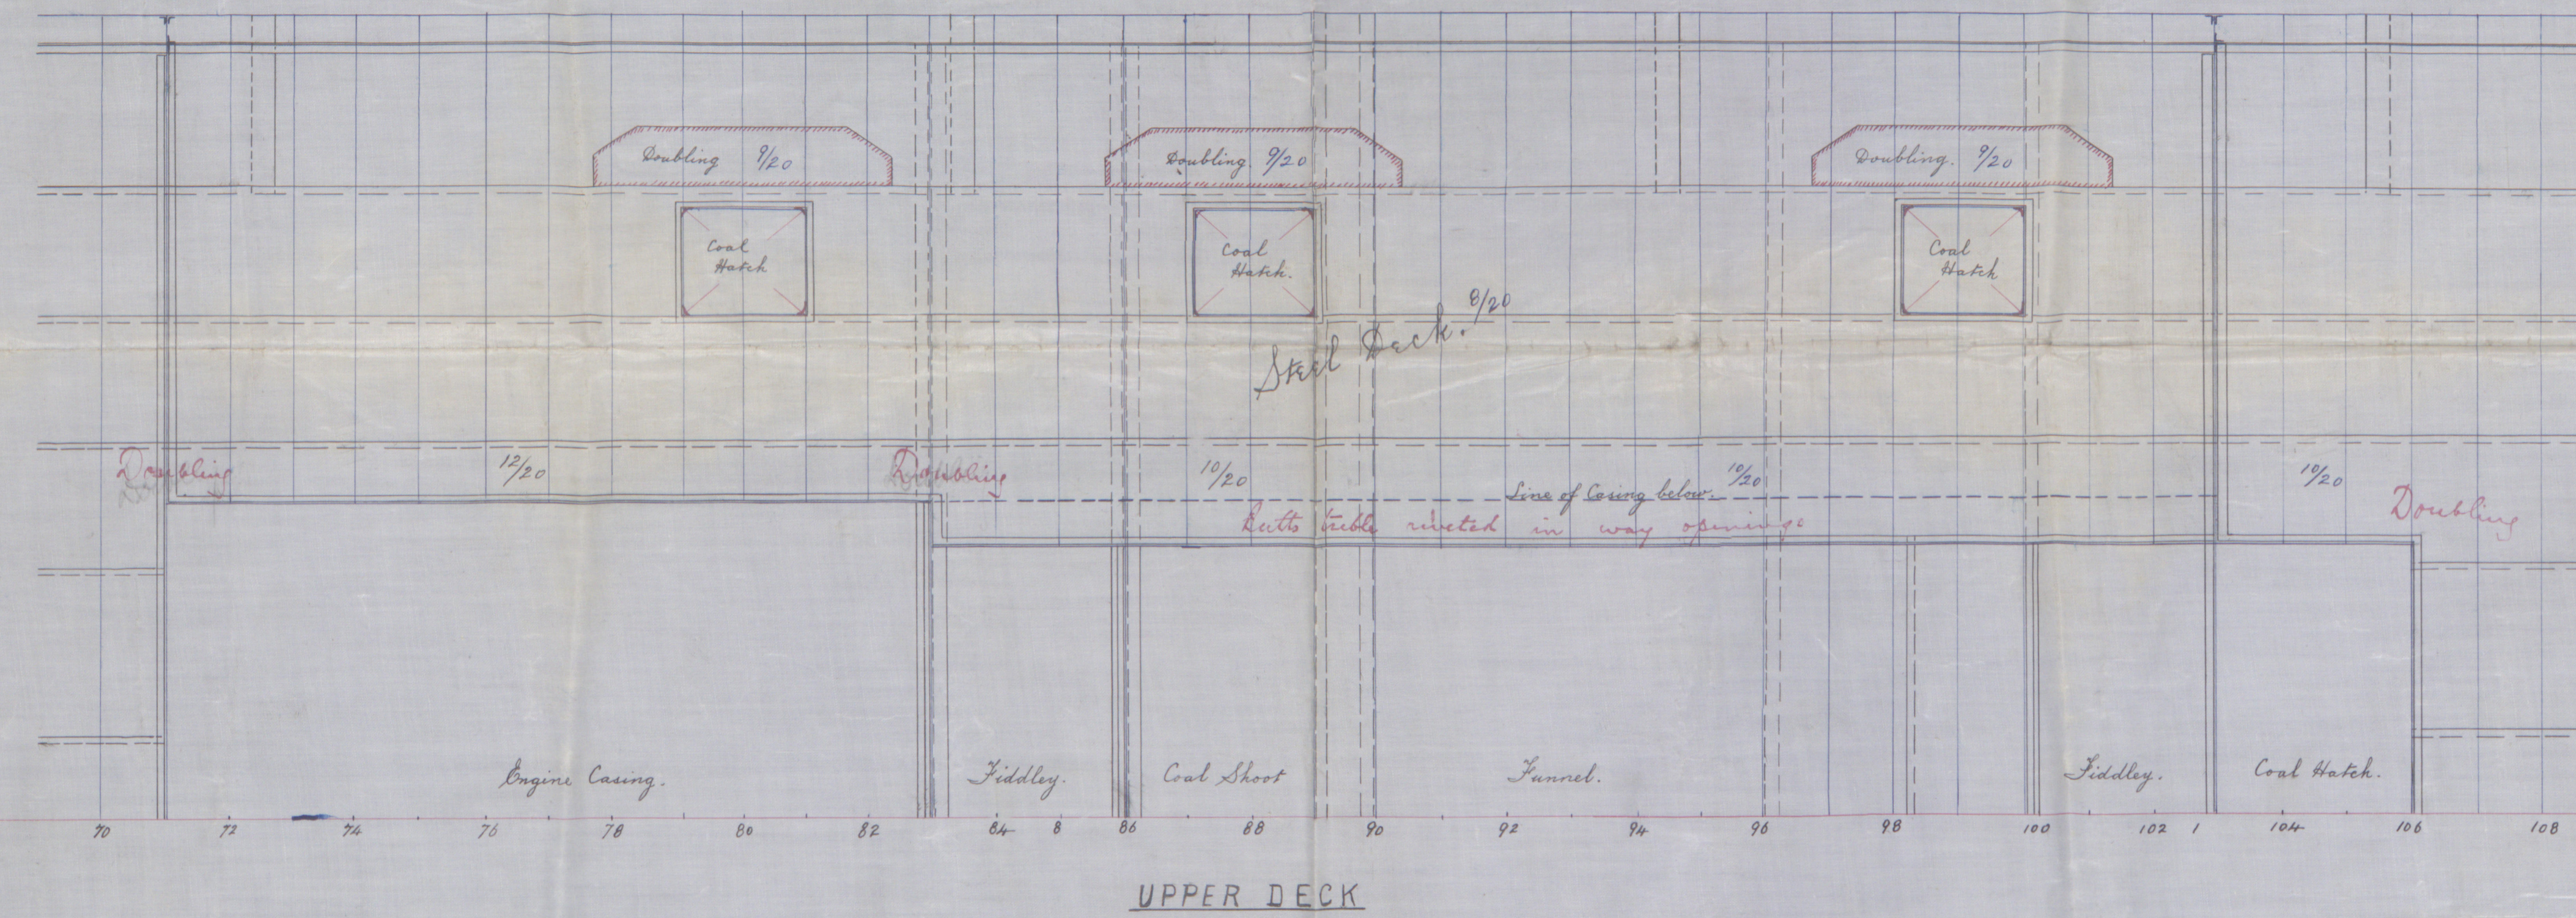


30.5.01

Midship Deck Plating Plans No 183 T.S.S.

Scale 1/4" = one foot.

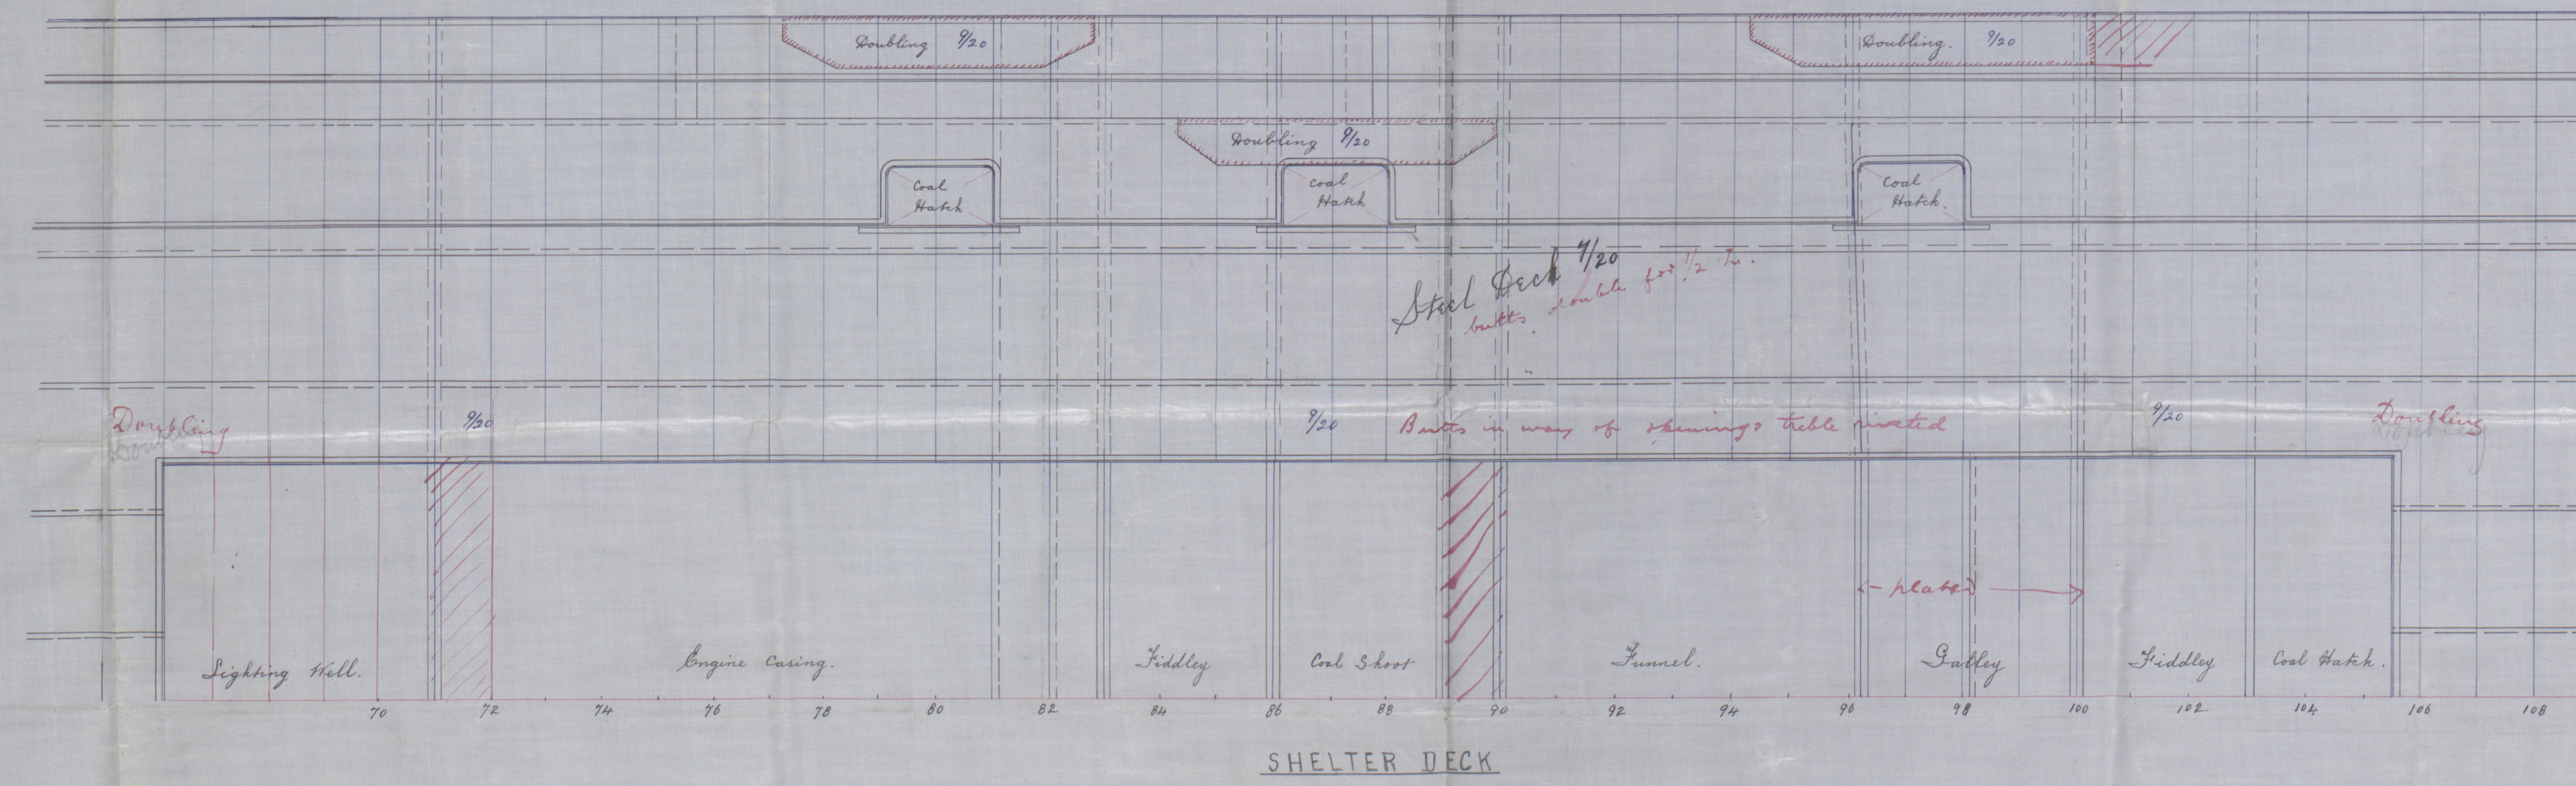

J.P.L.
30/5/01



Mess^{rs} Workman Clark

SS No 183 + 194

Plan of deck plating

SS Kiwaru

Bel 5400

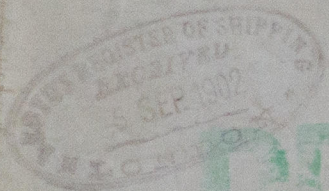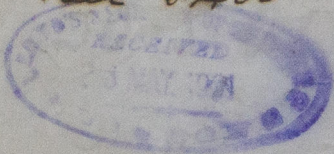

RETAIN



© 2021

Lloyd's Register
Foundation

W708 - 0024