


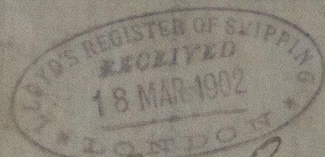





Belfast  
 Workman Clark & Co.  
 S. S. No 123 ~~1954~~  
 Altered 16/6/02  
 Midship Section




L. L. H. H. H. H.  
 Del. 5400

Marere

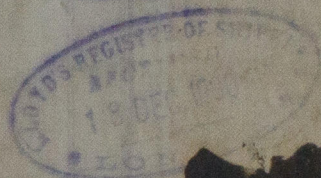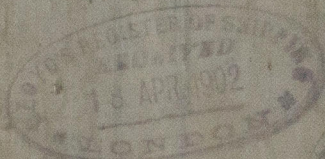

ELTAIN

 

© 2021

Lloyd's Register  
 Foundation