


7. 11. 05

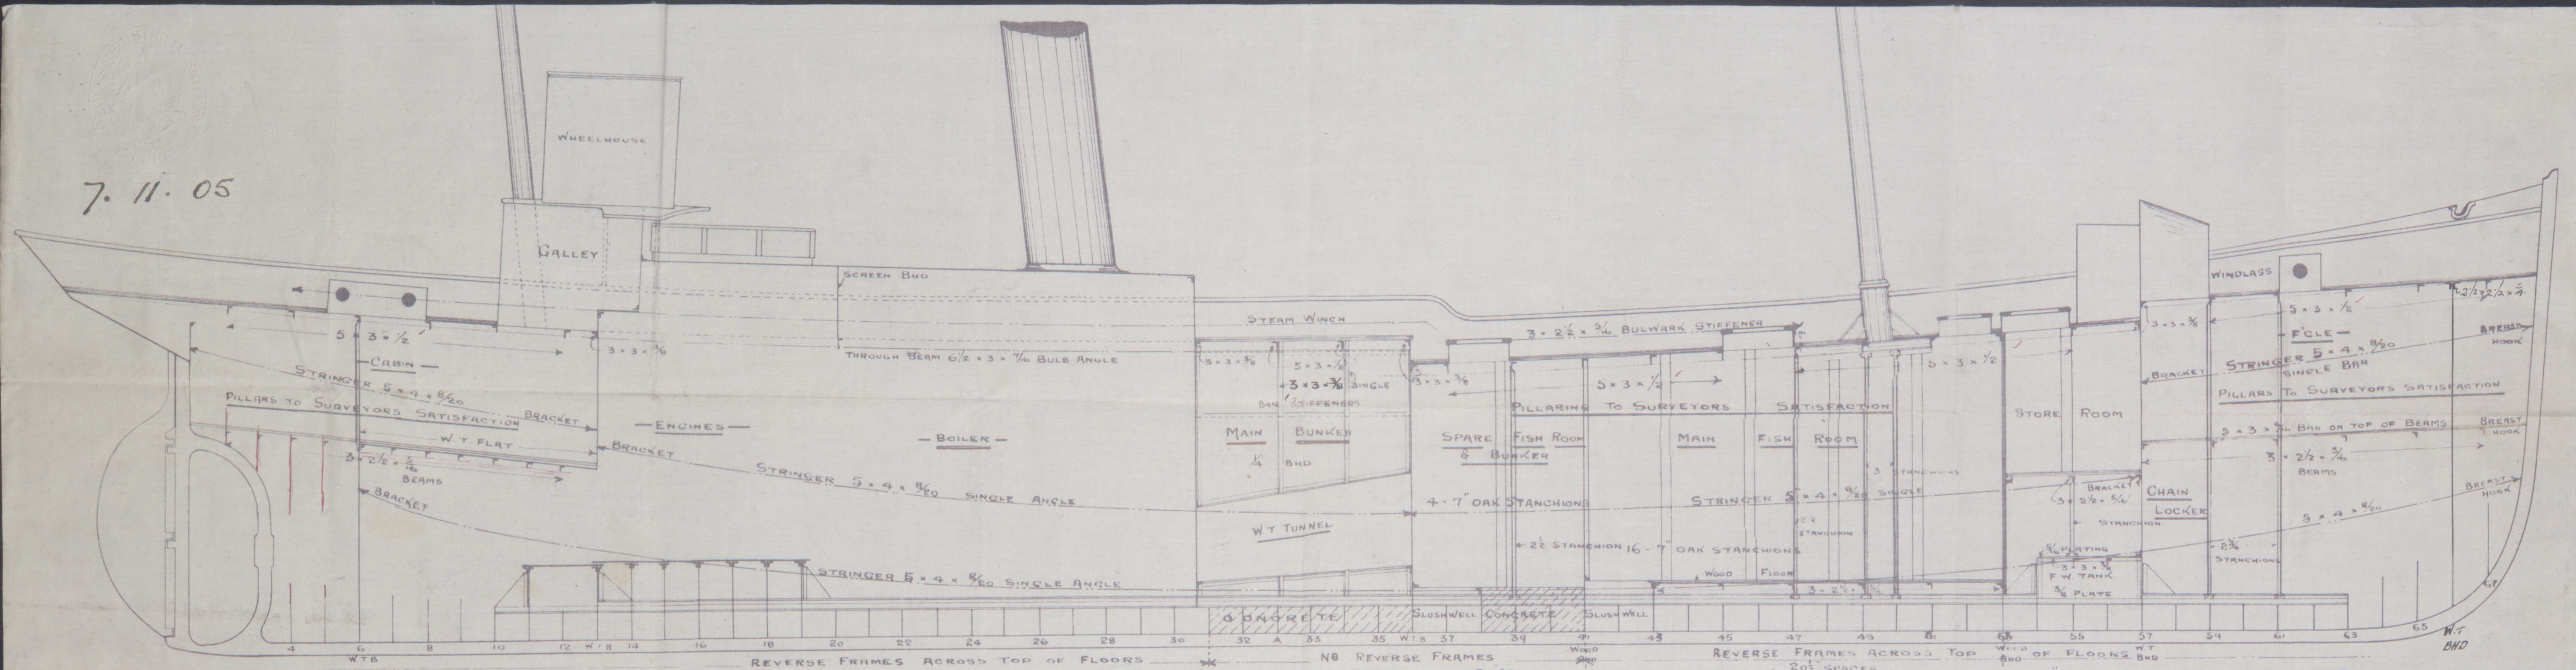

— BEAM ARRANGEMENT —

ALL PILLARING TO SURVEYORS <sup>20 SPACES</sup> SATISFACTION

SCALE  $\frac{1}{4}" = 1 \text{ FOOT}$

S. S. N<sup>o</sup> 112.—

COOK WELTON & GEMMELL

SHIPBUILDERS

BEVERLEY

DATE SUBMITTED NOV. 3<sup>R</sup> 1905

DATE APPROVED

C.B.  
7.11.53

LOYD'S REGISTER  
OF SHIPPING.  
6 - NOV 1905  
+ HULL +  
Lloyd's Register  
Foundation  
W 708 - C157



Profile

Cook Belton & Gemmells

No 112



s/s "Regal"

Hull Report No. 18117

W708 - 0157

ETAIN



© 2021

Lloyd's Register  
Foundation