



total capacity tons. F.P.T. tons; A.P.T. tons; M.T. feet tons;

Particulars of Classification (which must be inserted precisely as in Register Book & Supplements).

CHARACTER.	Years Assigned now expired.	Years Assigned now expired.
Machinery and Boiler (including date of N.B., if any).		
100, A. 1		L.M.C. 10.20

Report, No. 10749 Port Don

RIVER TREES Proposed Modification to Rudder. Scale 1" = 1 foot.

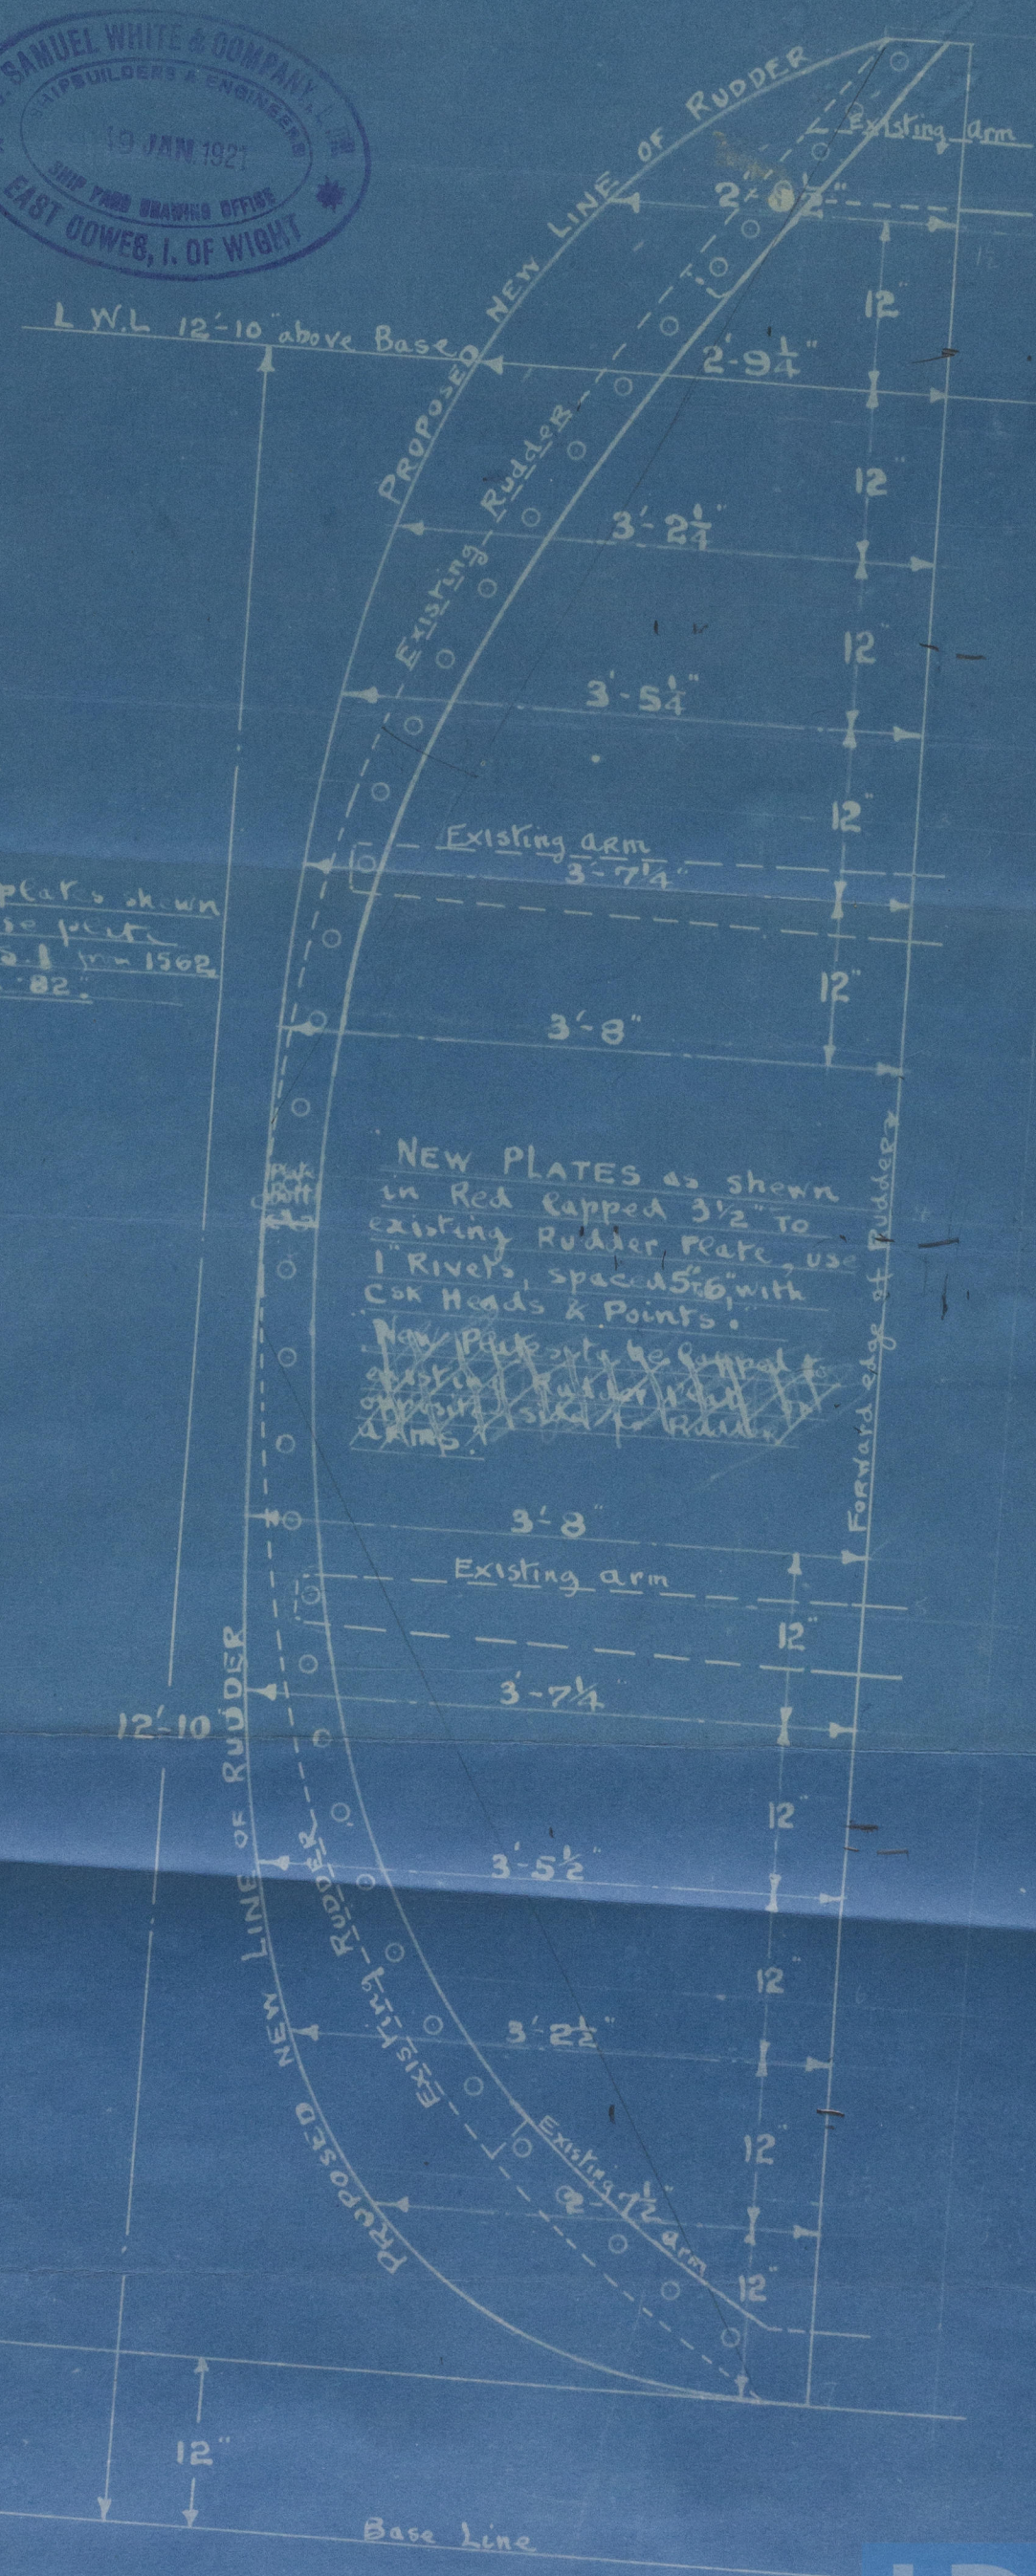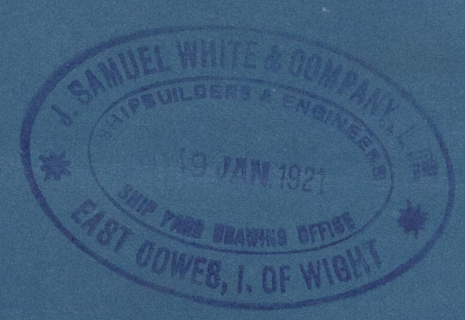

For new plates shown in Red, use plate marked K.S. 1 mm 1562 10'-2 x 17' x 82.

NEW PLATES as shown in Red capped 3 1/2" to existing Rudder plate, use 1" Rivets, spaced 5 1/2" with Cork Heads & Points.

To remain as shown in the Register Book with fresh notes of survey.

Survey Fee (per Section 25) ...
Special Damage Fee (per Sec. 25) ...
Traveling Expenses (if chargeable) ...
Fees applied for, ...
Received by me, ...
Certificate required? If so, ...

W708-0220

4 witness
Mr. G.W.C.
Mr. H.B.
Mr. J.L.
Actual measurement
over 500p. 1082



© 2021 Lloyd's Register Foundation

S. S. River Tees.

alteration to
existing Rudder
Plate.

See Report N^o 10842.



© 2021

Lloyd's Register
Foundation

V.B.—All alterations
If the Vessel has
tanks examined.
s, and of the inn
st Report.

dical Surveys, wh
e of Repairs, if a
ccount of Damag
besides being det
acement of Ancho
back of this form.

image cases when

they were declined

AIRS, OR EXA

Rudder

enclos

where

MARY OF DAMAGE

Renewed

Removed and Fair

Faired or Repaired

PRESENT CONDITION OF

ing of Decks.....

rways.....

ings

s & Fastenings.....

de Plating

ing of ditto.....

is.....

sthooks & Crutches.....

soms.....

ies.....

rse Frames.....

's.....

sons.....

eneral Ob

State clear
this survey, thus,
survey, 1,15," or "

ulio
to