


SECTION THREE TANKS
IN WAY OF EXISTING HATCHES.


SECTION AT FORE END OF NO 5 TANK
CLOSE OF HATCHES.

Fillers require supporting struts to remain as at present in ship.


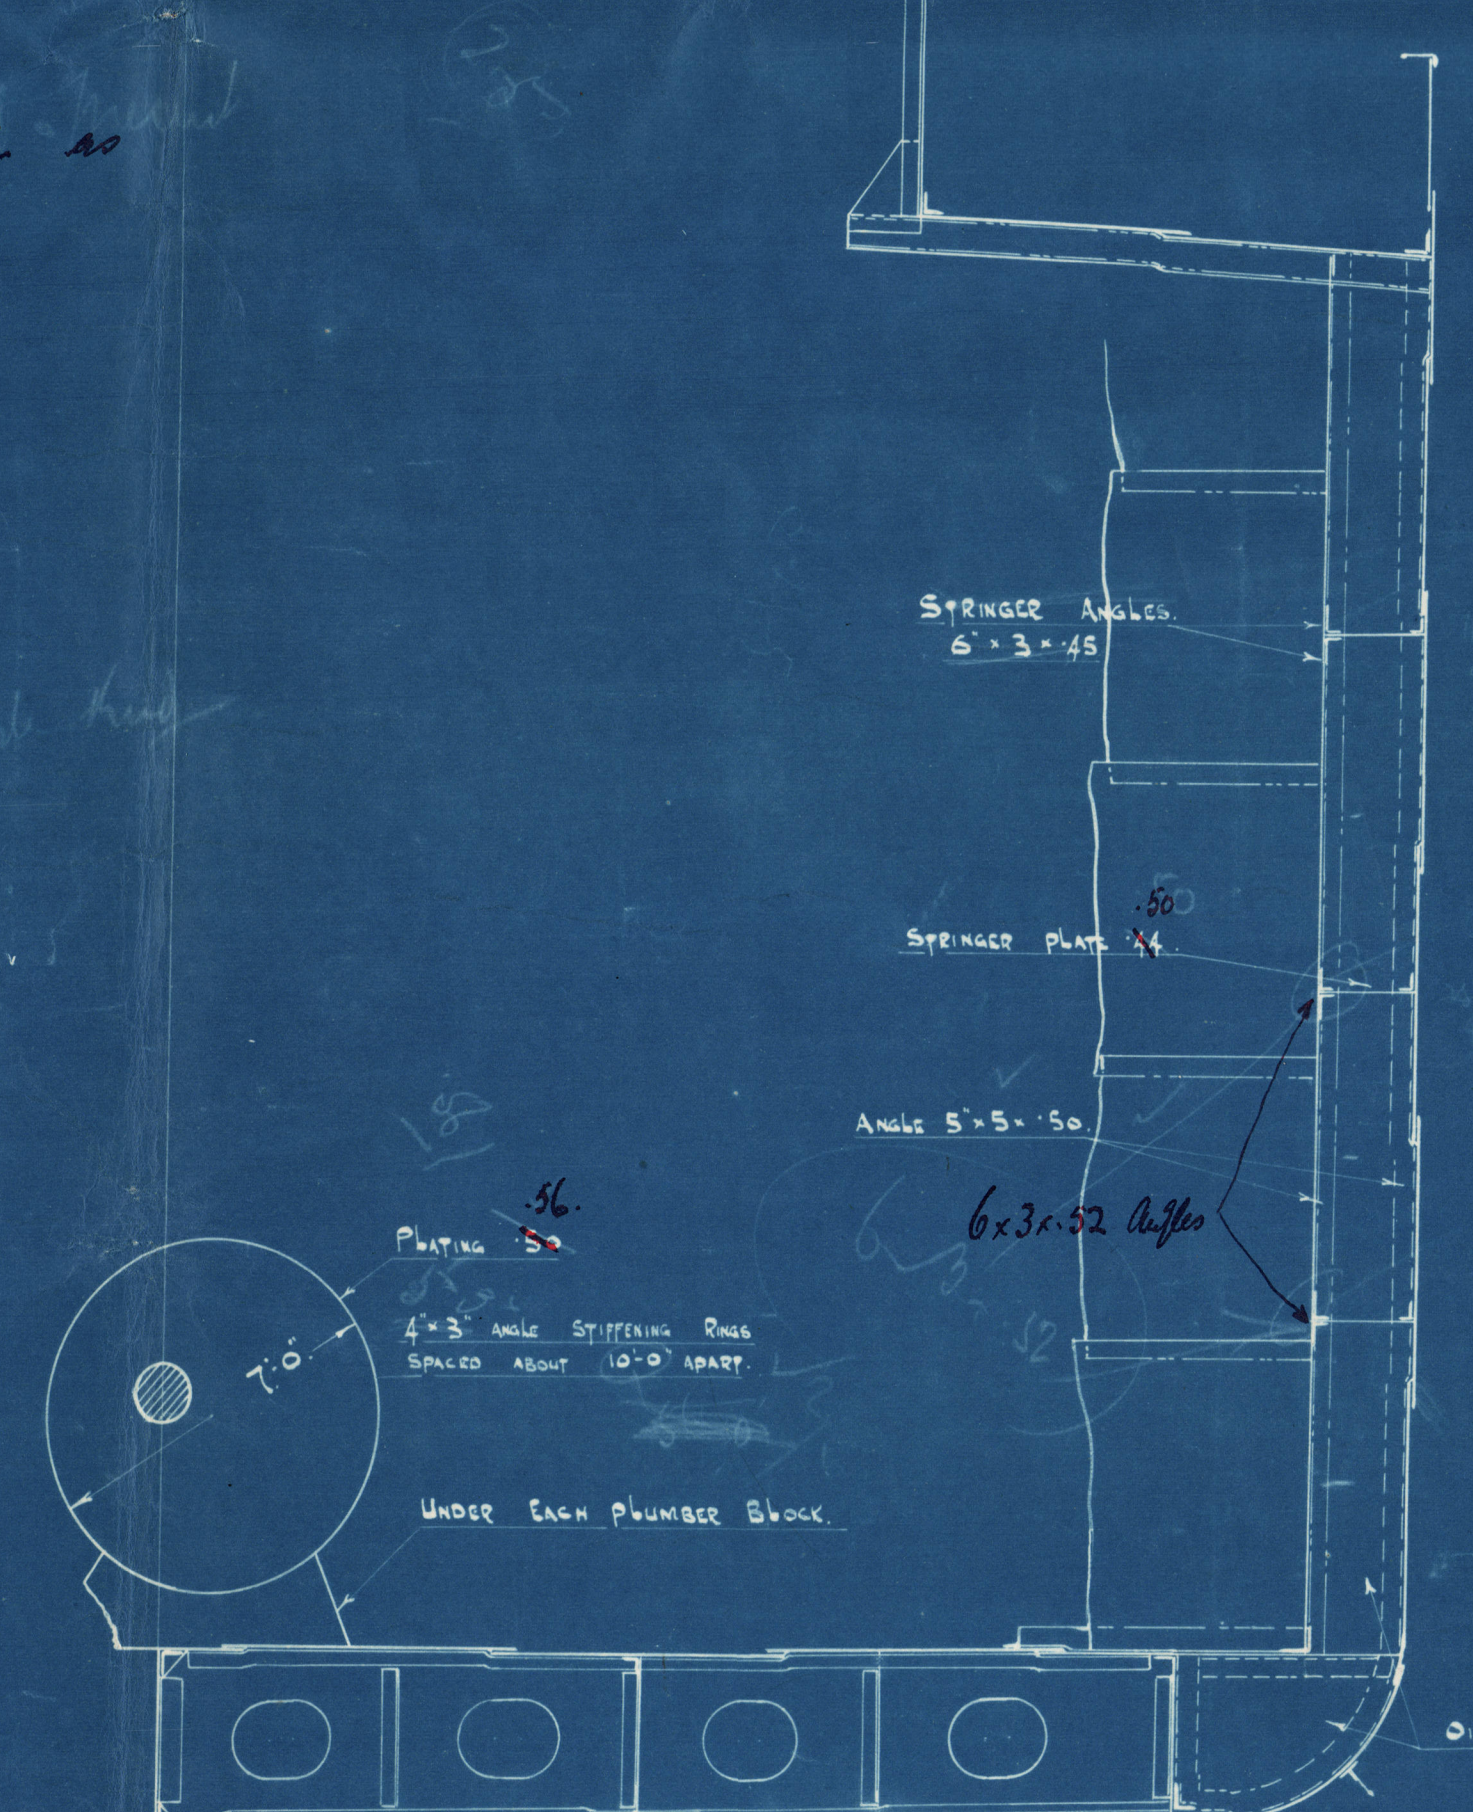

SECTION SHOWING CONNECTION TANK TO SHELL.


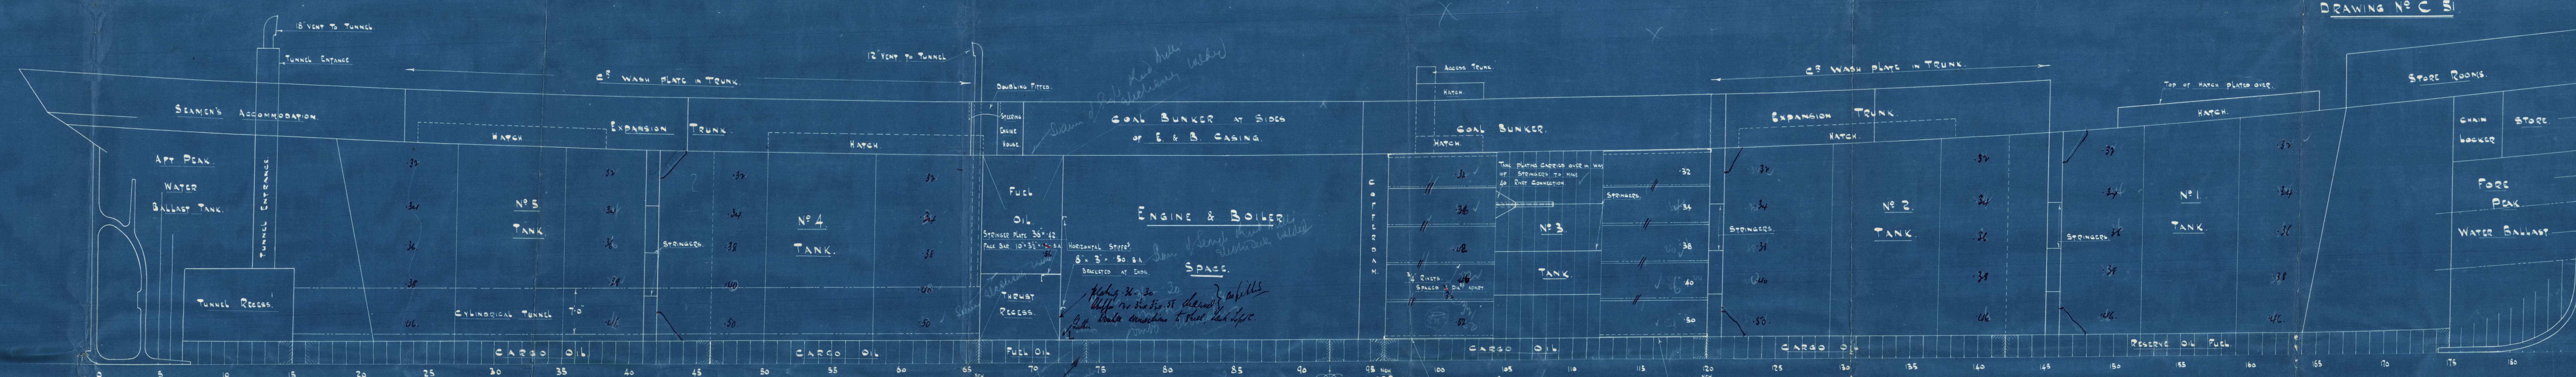


SKETCH SHOWING METHOD OF CONVERTING
STANDARD 'A' VESSEL TO CYLINDRICAL TANKER.


SCALES:-
PROF. 1/8" = 1 FOOT.
SECTION 1/4" = 1 FOOT.

DRAWING NO C 51

APPROVED
LLOYD'S REGISTER OF SHIPPING
Montgomery
DATE 15.9.00

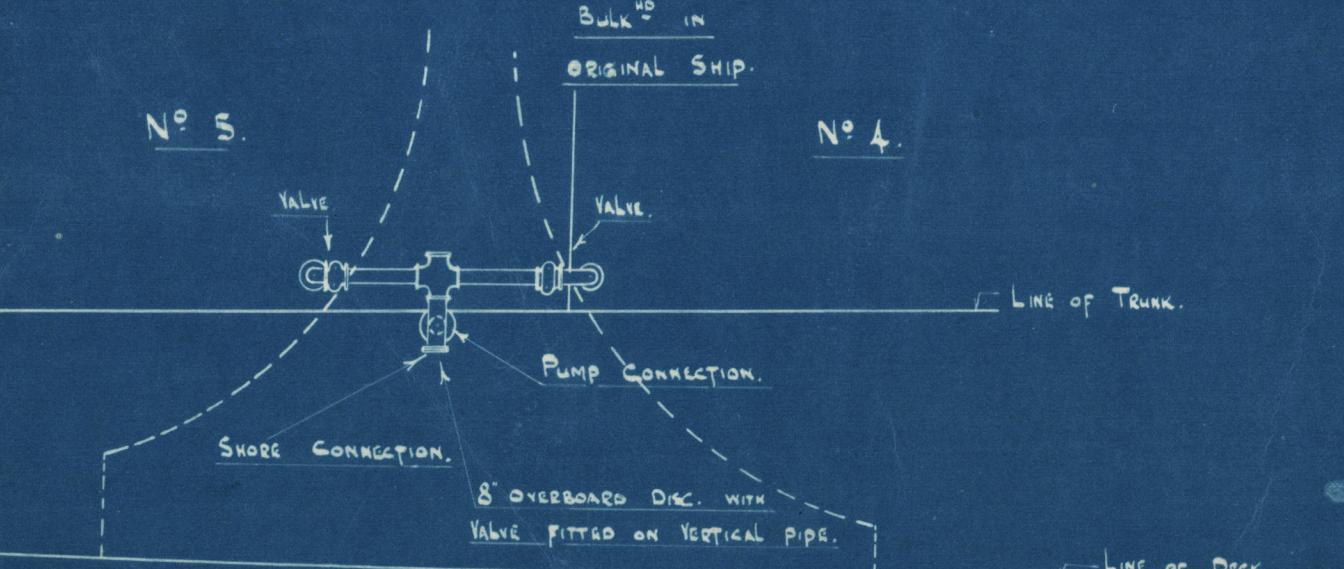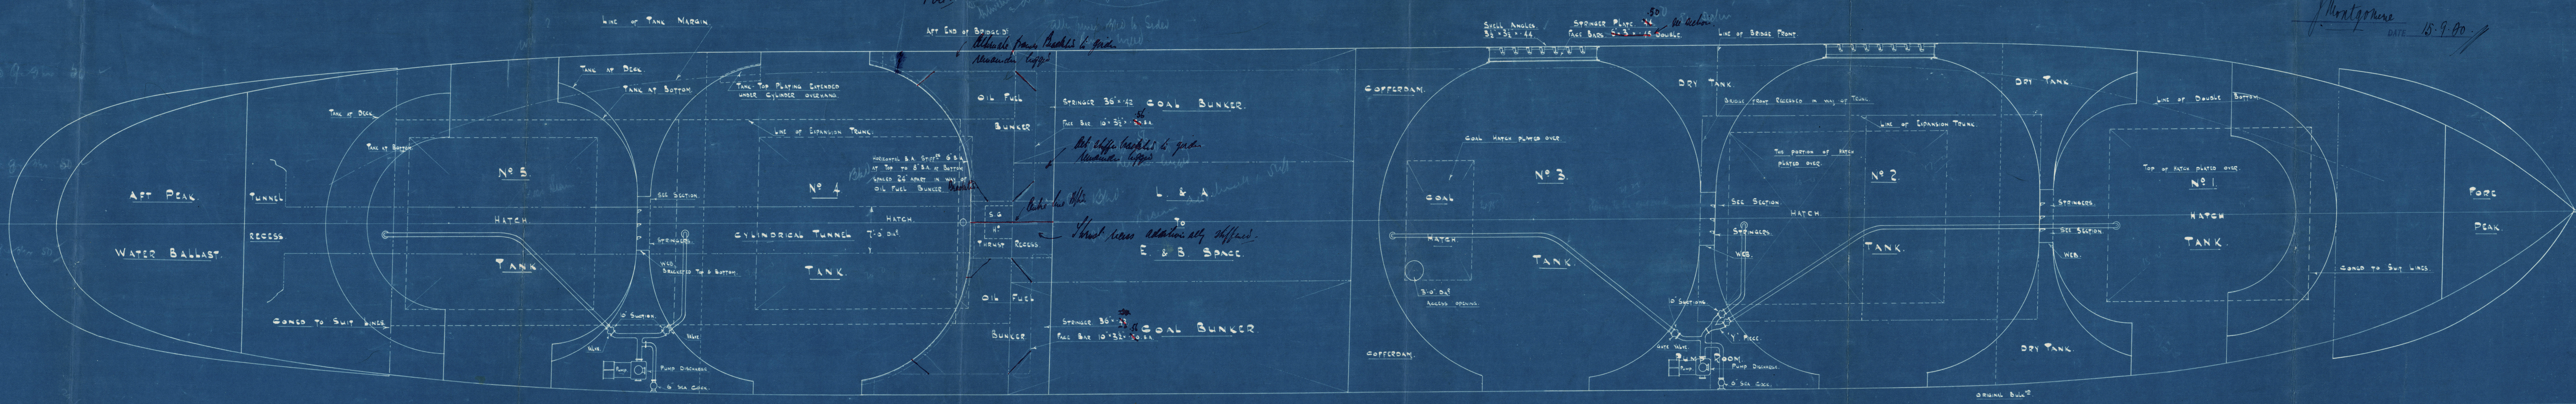

ARRANGEMENT OF PIPING ON DECK.

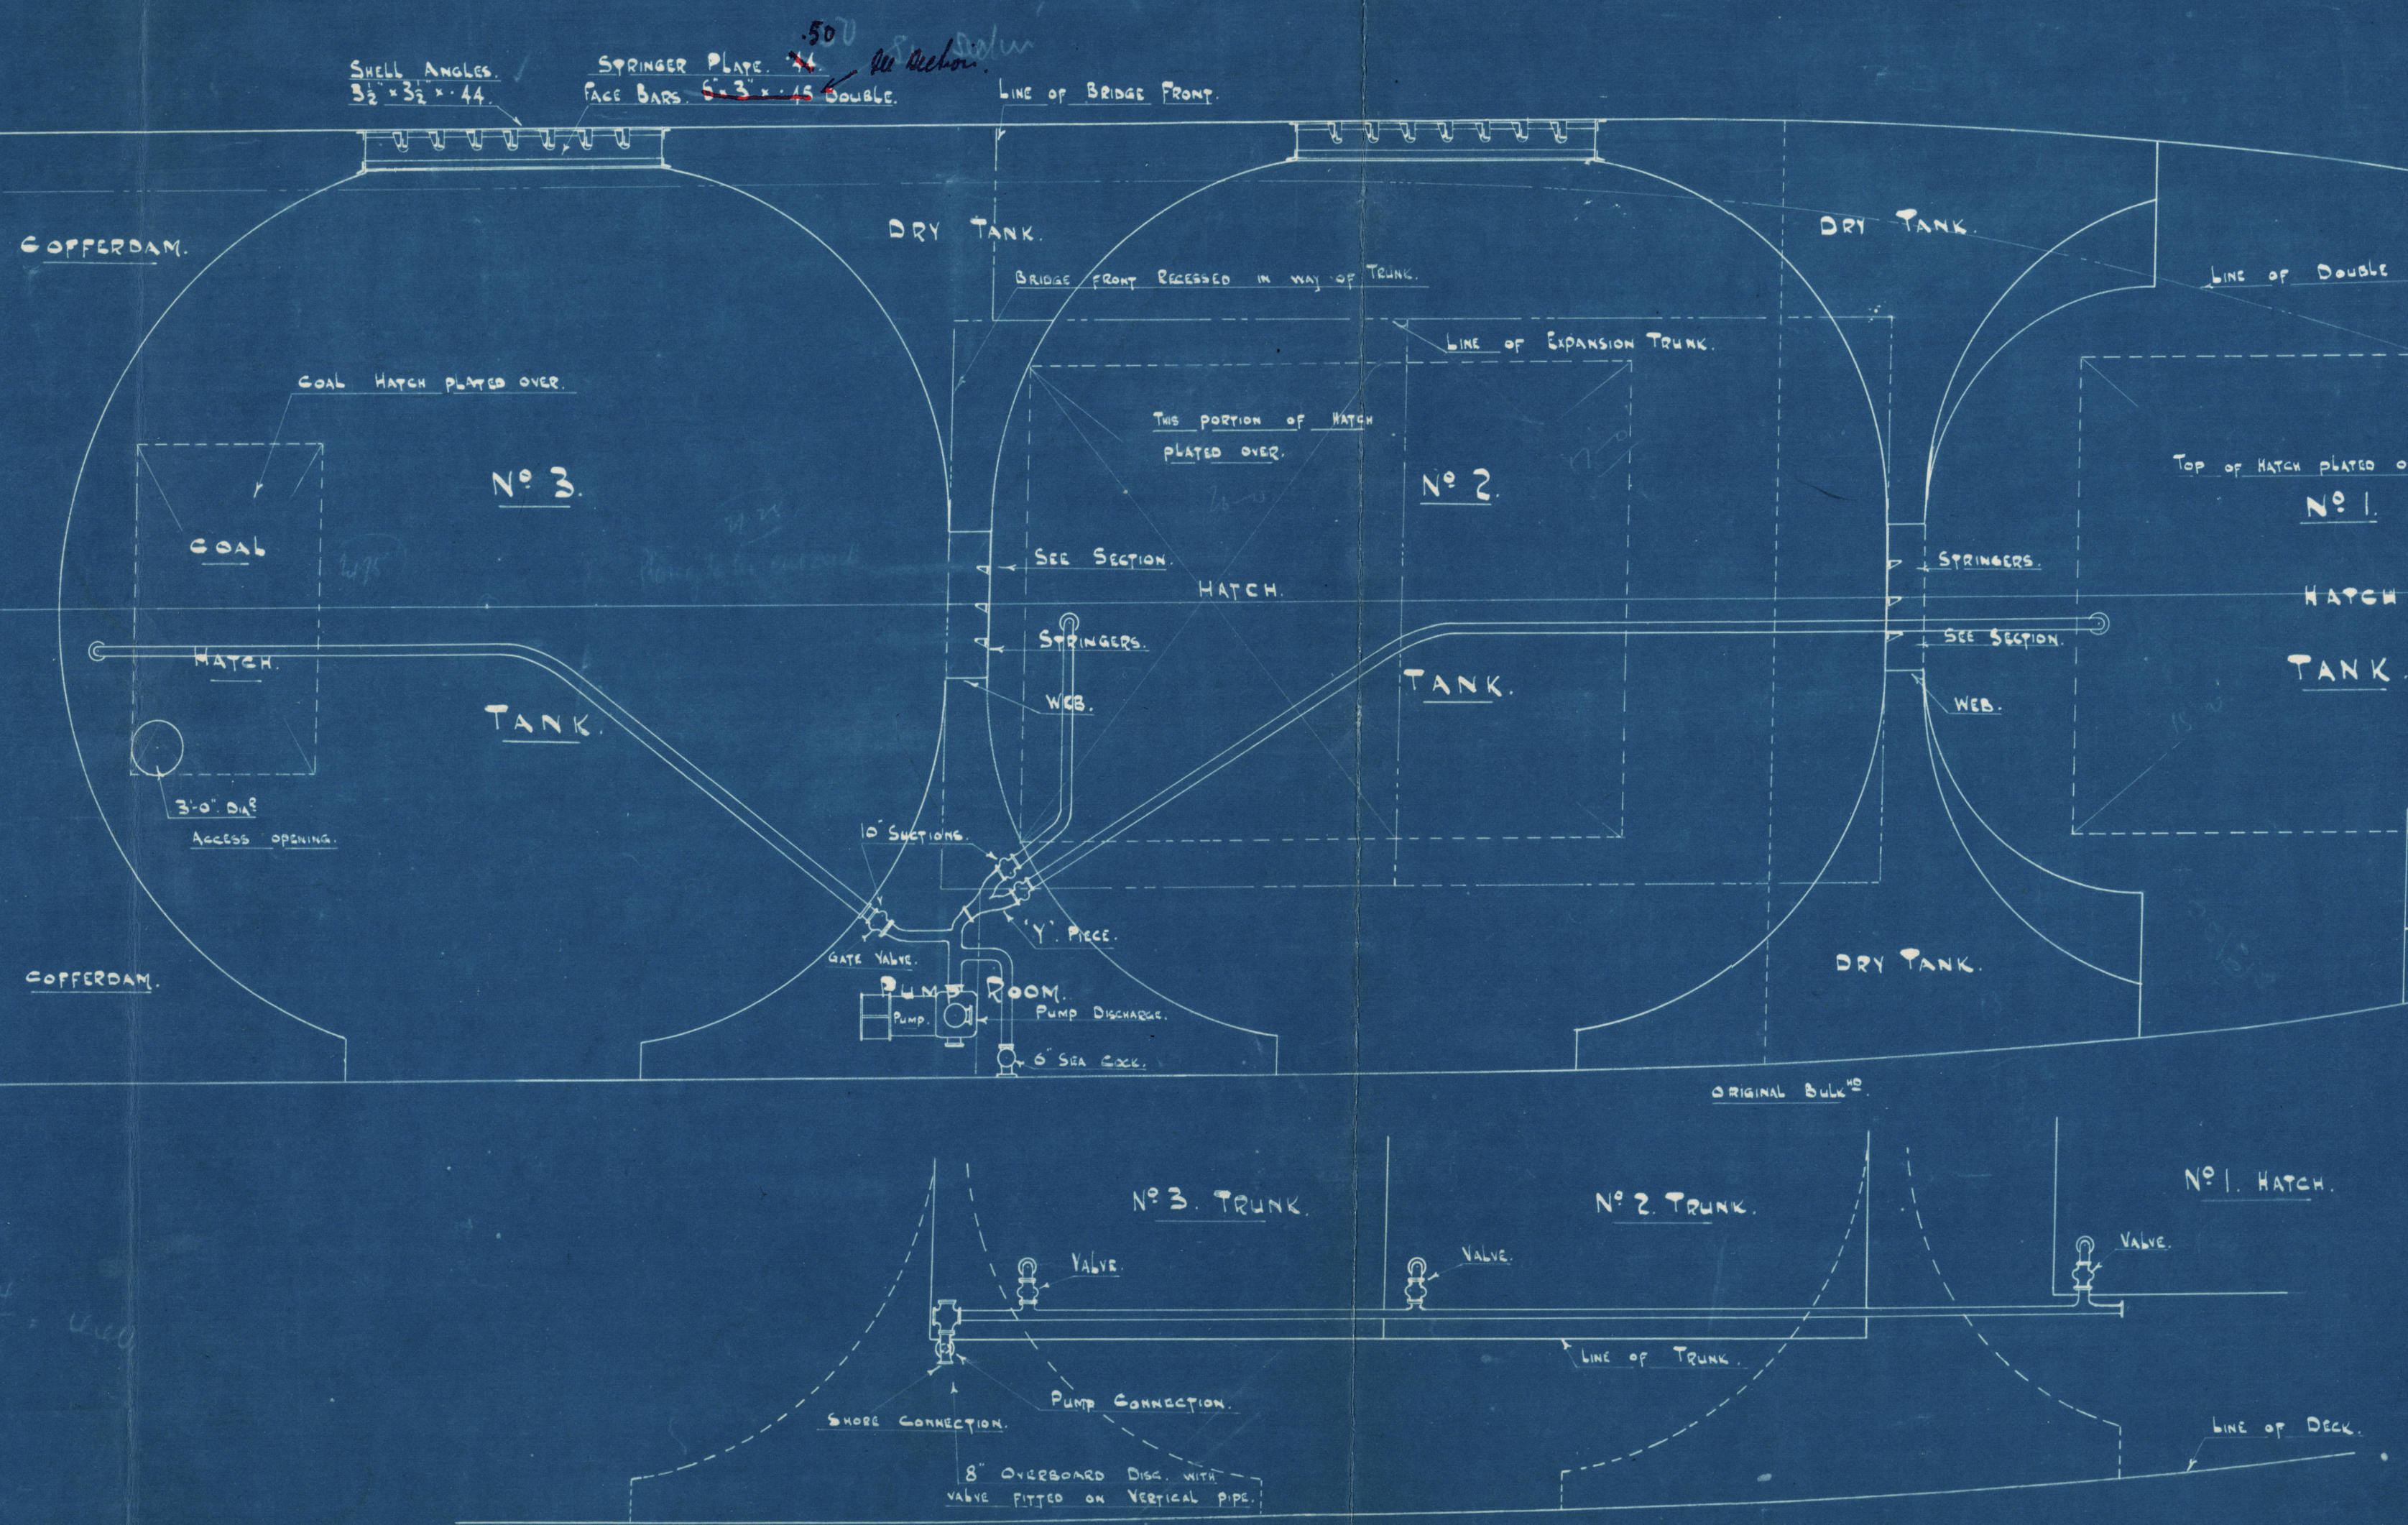

ARRANGEMENT OF PIPING ON DECK.

C. P. M. JACK.
153 ST. VINCENT STREET
GLASGOW.



W711-0035

Standard "A" vessel

RETRACT

GLASGOW REPORT No.

41069

S/S COYLEET

M711-0035



© 2020

Lloyd's Register
Foundation