


# STEEL BOILER

Scale 1" = 1 Foot

21: 7: 06

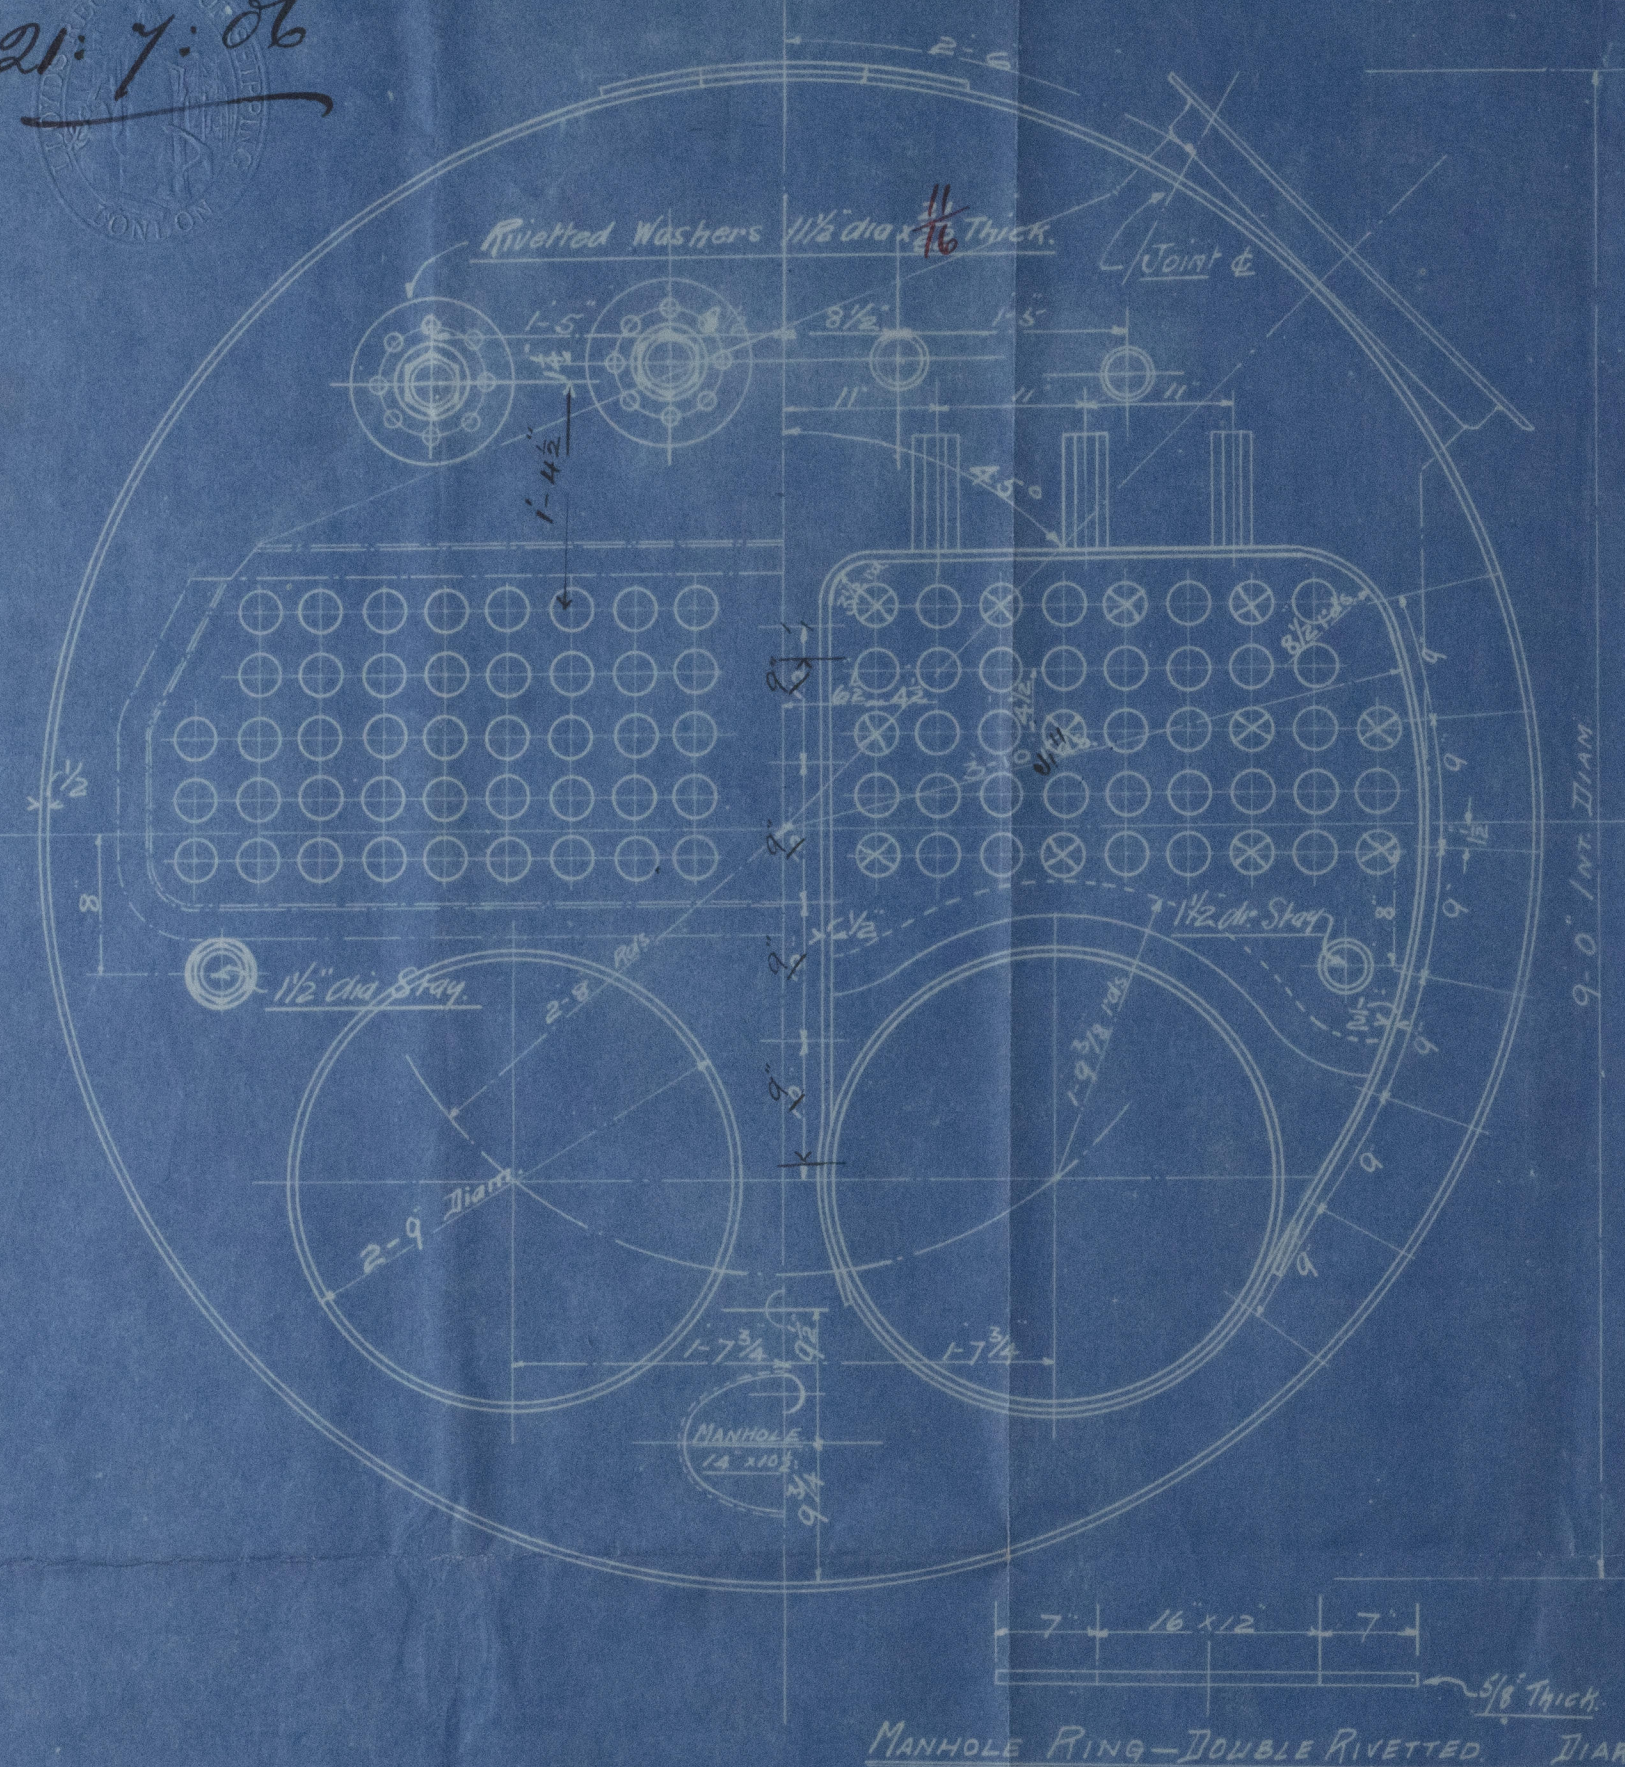



TO PASS LLOYDS SURVEY FOR 80 LBS WORKING PRESSURE


TENSILE STRENGTH OF SHELL PLATES 27 TO 32 TONS

OF END & INTERNAL PLATES 26 TO 30 TONS

ORDER N<sup>o</sup> M.B. 102

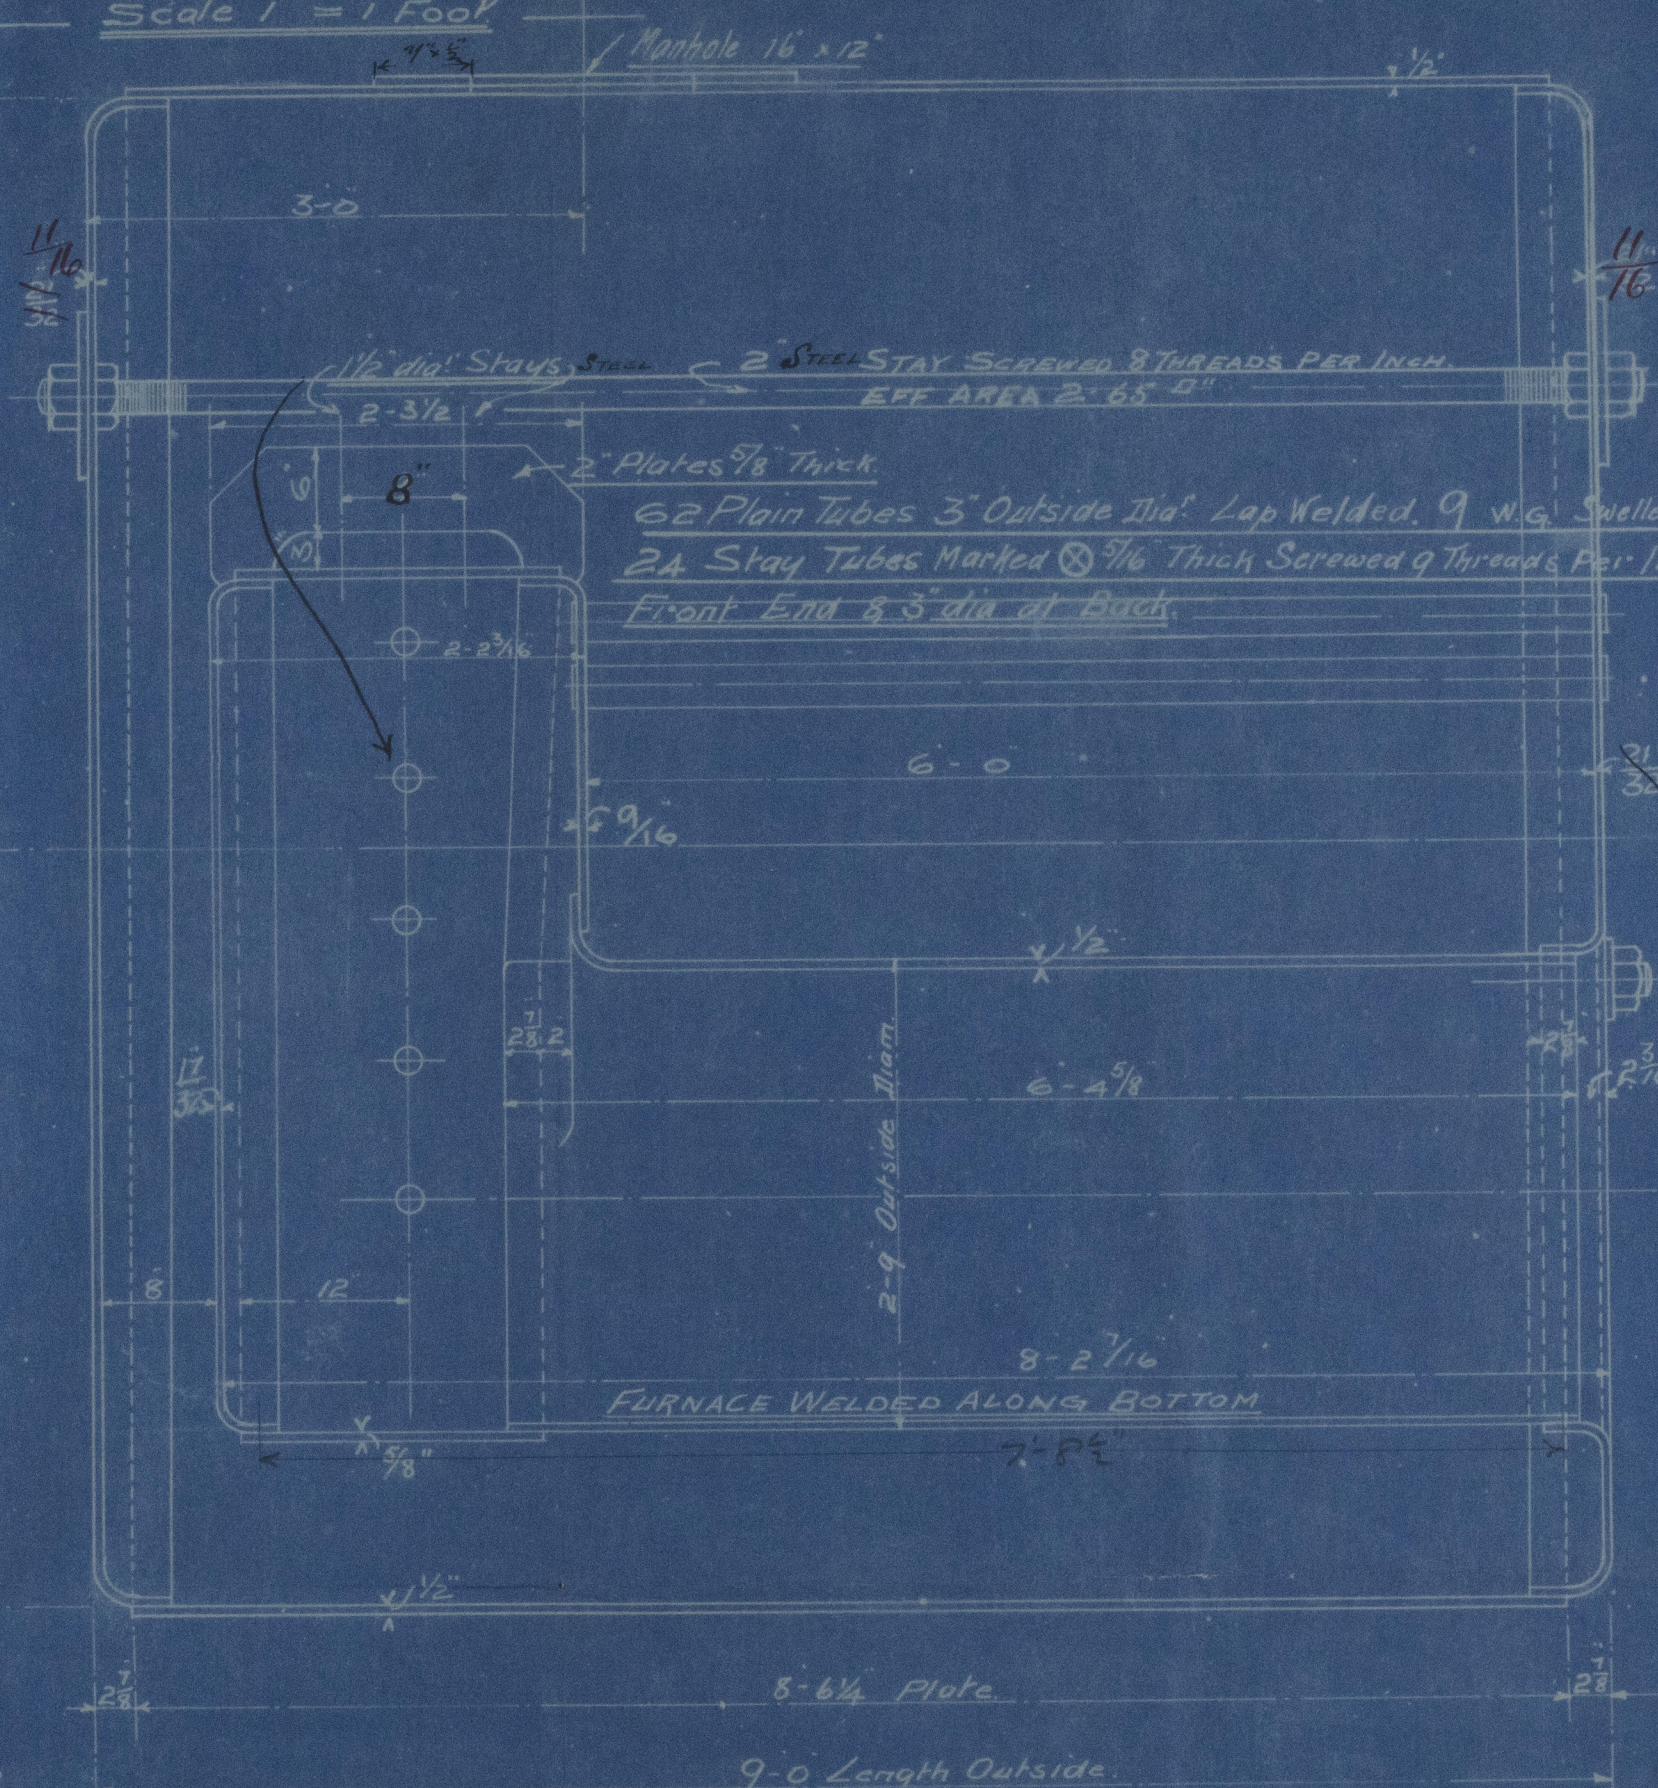

PLAN OF SHELL RIVETTING

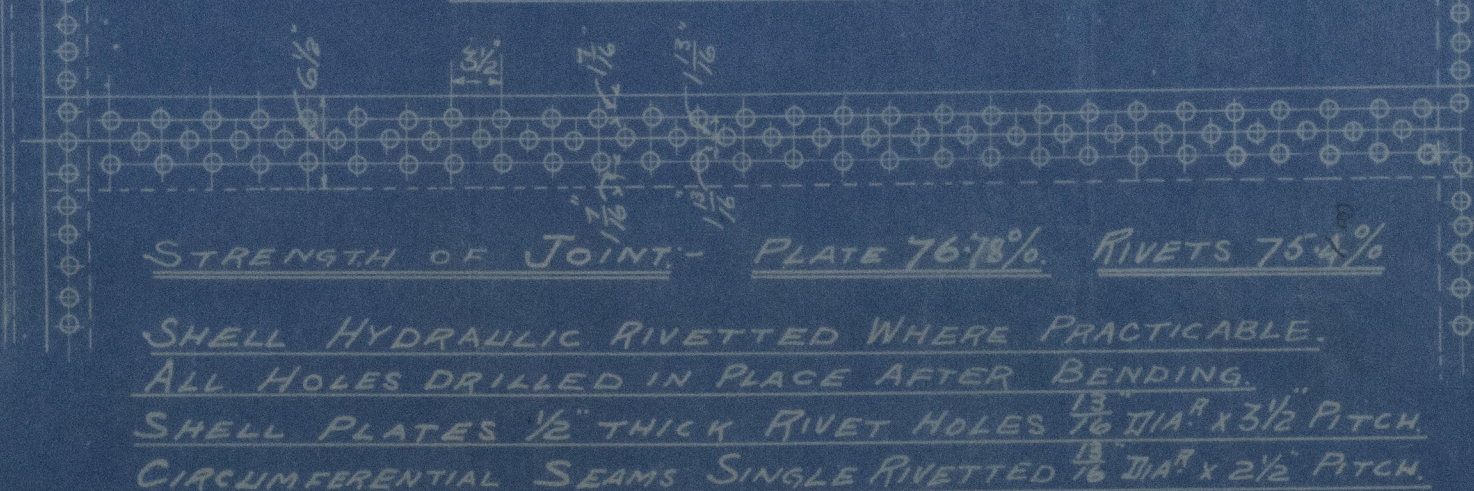




SHELL HYDRAULIC RIVETTED WHERE PRACTICABLE.

ALL HOLES DRILLED IN PLACE AFTER BENDING.



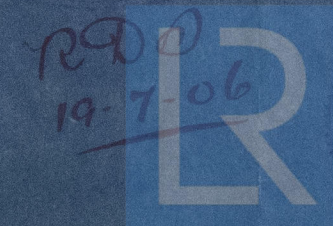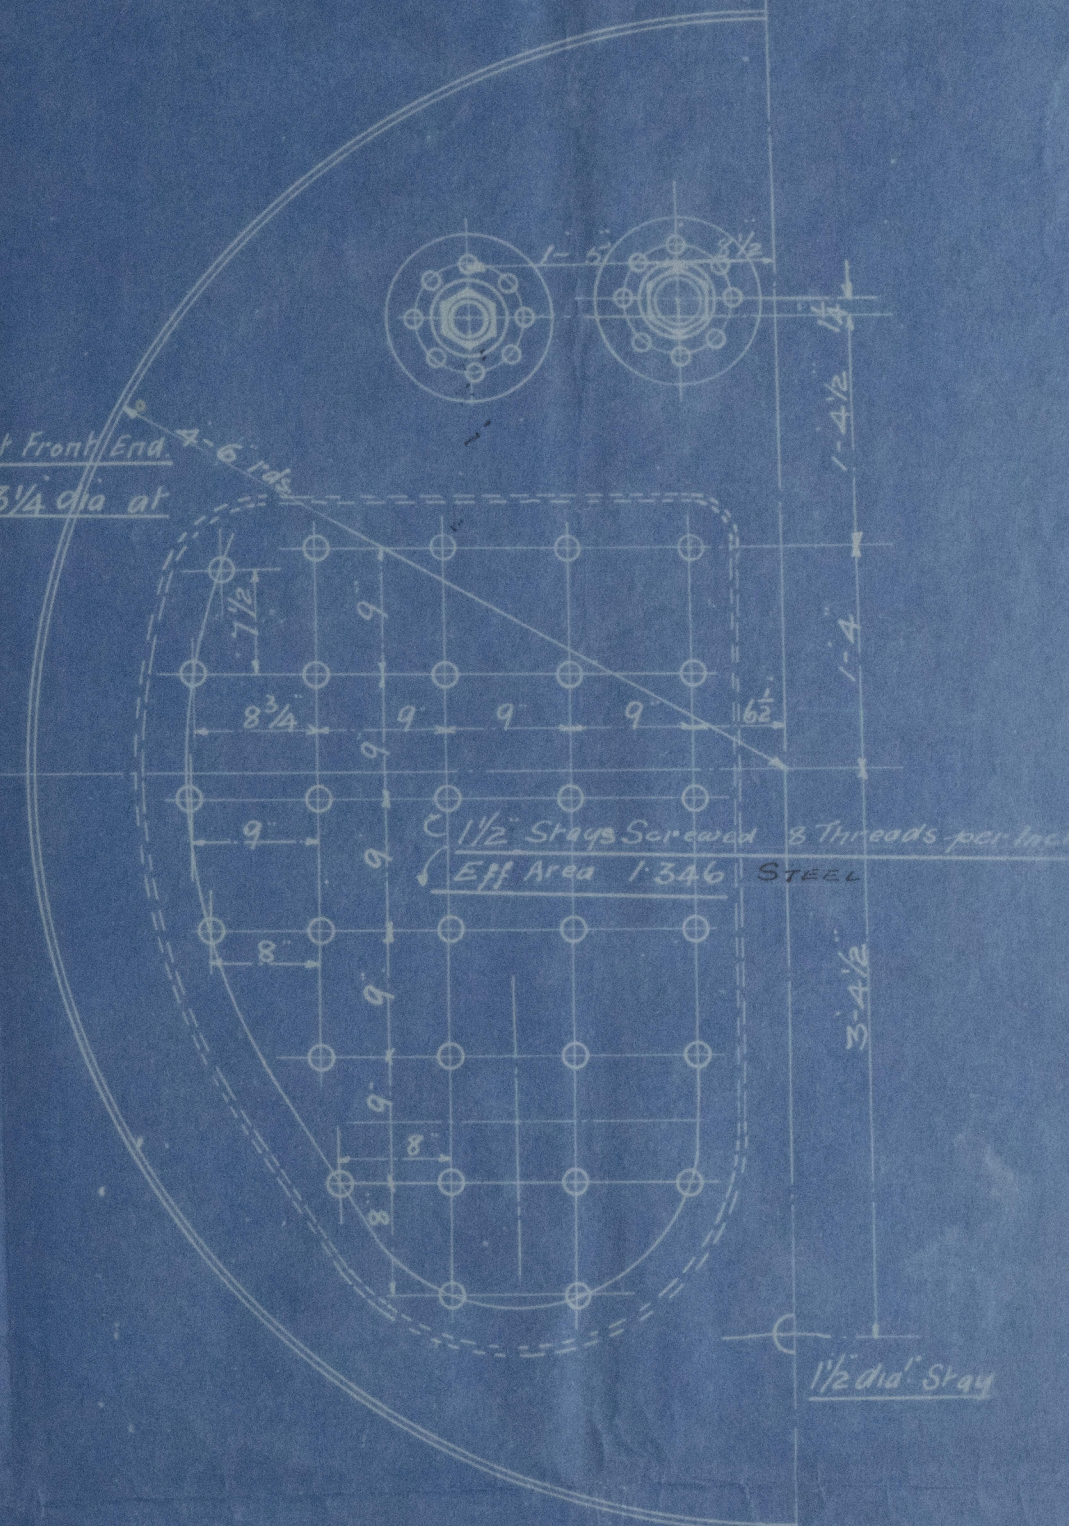

J.M. 20/7/06

W713-0060



Donkey Boiler  
No 102.

Blake Boiler W & E Co

W. Gray & Co

S.S. No 735

Mdb report No. 4823

"Ben Saunders"

App. report No. 13129

No. 3795
LLOYD'S TEST.
160 lbs.
30-10-06
R.D.S.

RETAIN



© 2020

Lloyd's Register

W713-0060